


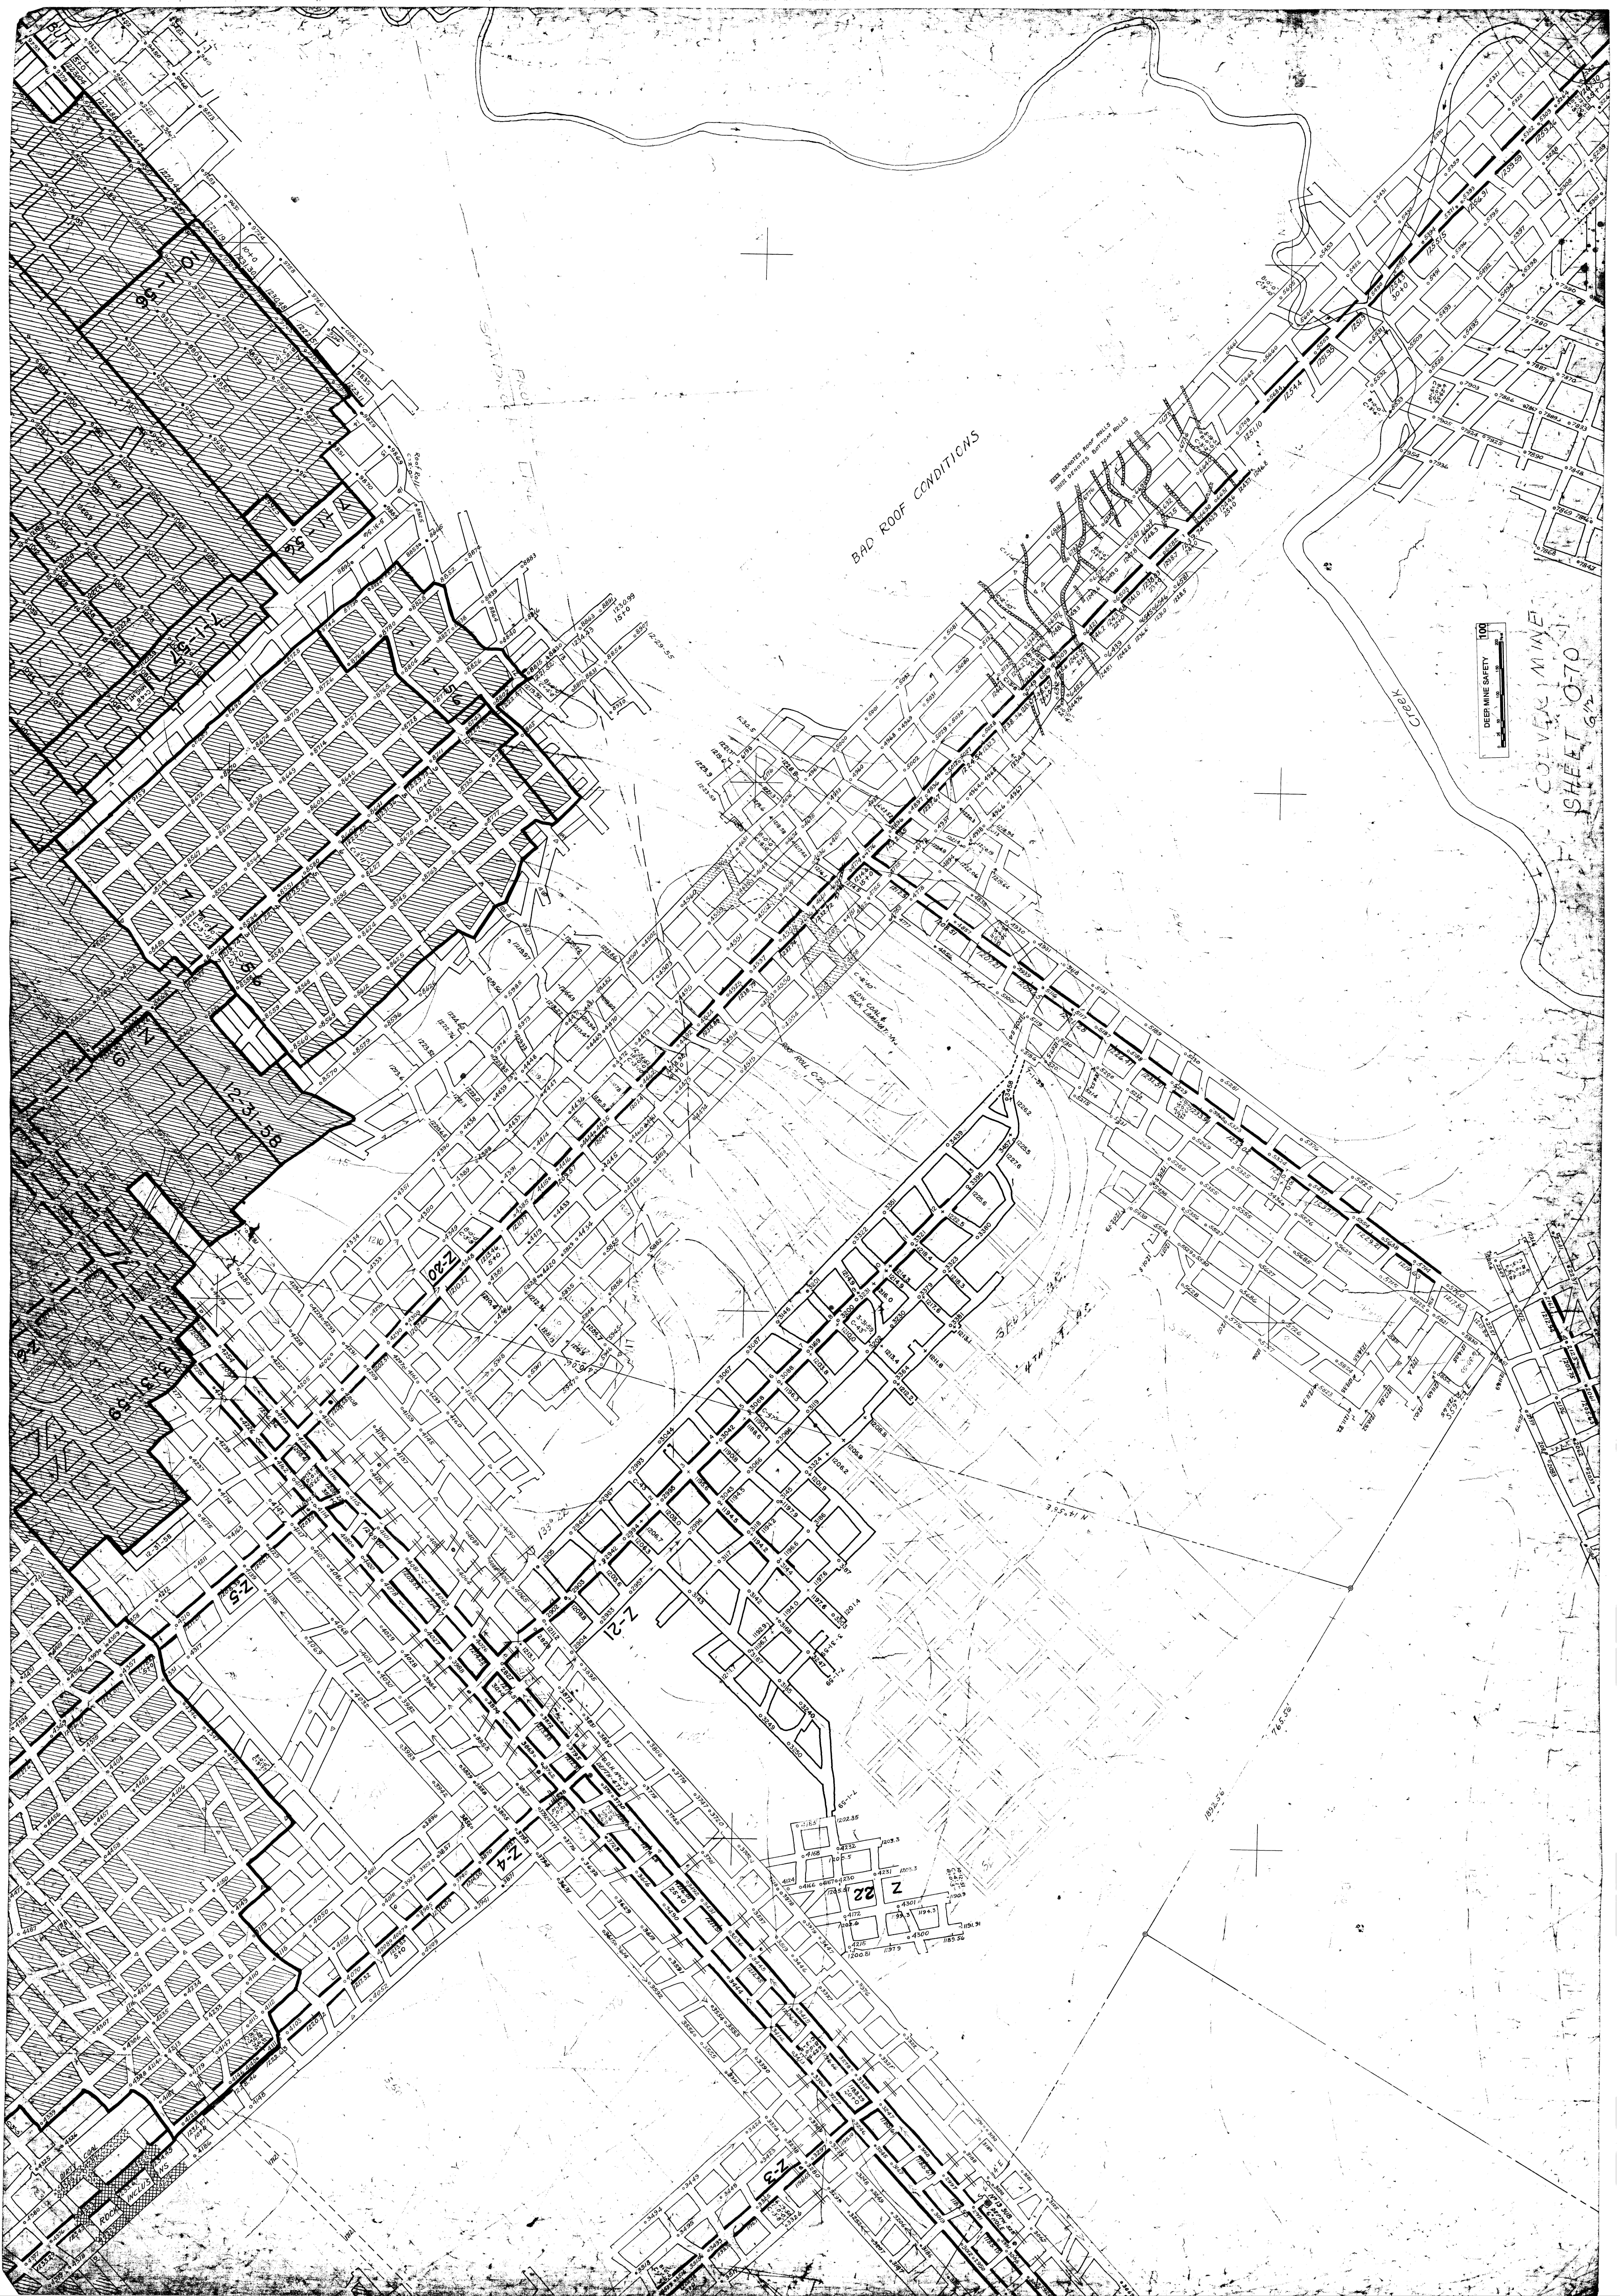

BAD ROOF CONDITIONS

COAL MINE
SHEET 070

DEEP MINE SAFETY
100

Creek