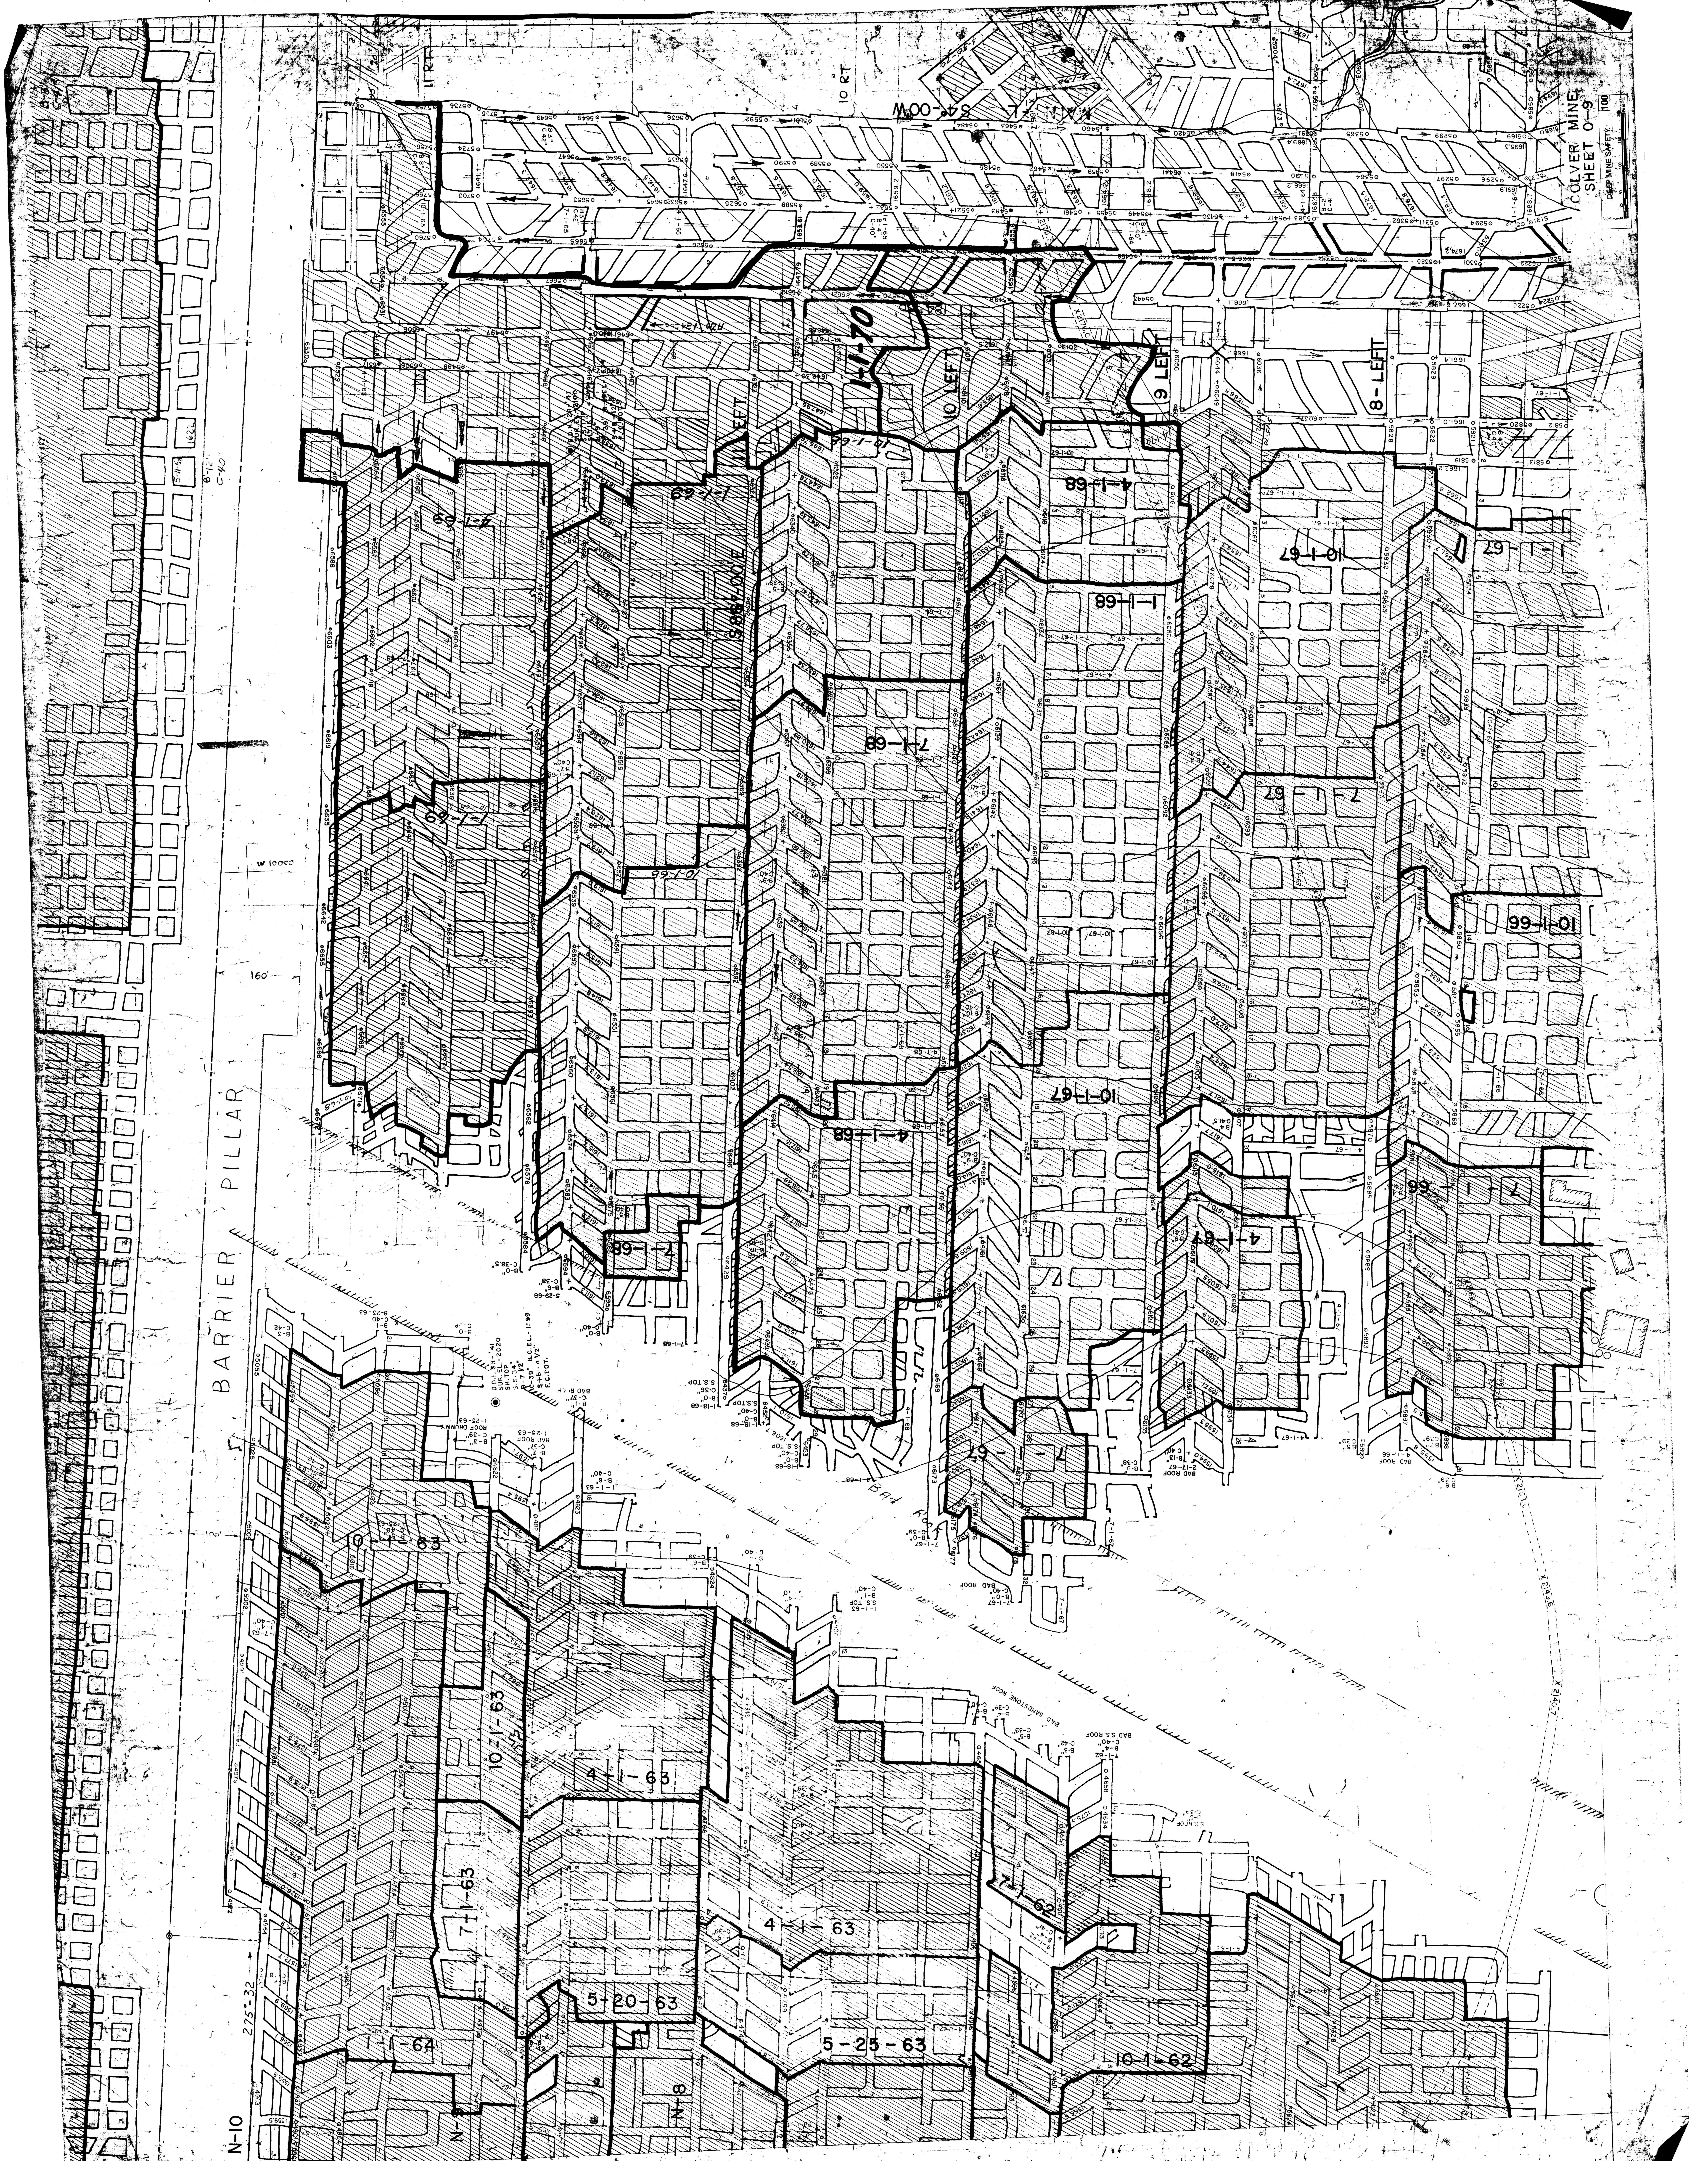
COLVER MINE
SHEET O-9
DEEP MINE SAFETY
100
MAIN
S4°-00W
11 RT
10 RT
10 LEFT
9 LEFT
8-LEFT
S86°-00E
1-1-70
1-1-69
4-1-69
7-1-69
10-1-68
7-1-68
4-1-68
1-1-68
7-1-68
4-1-68
10-1-67
7-1-67
4-1-67
1-1-67
10-1-67
7-1-67
10-1-66
7-1-66
4-1-67
7-1-67
B-12"
C-40"
160'
W 10000
BARRIER PILLAR
Bad Roof
BAD ROOF
BAD SANDSTONE ROOF
BAD S.S. ROOF
S.S. TOP
ROOF DRUMMY
D.D.H. S.R. 41
SUR. EL.-2020
SH. TOP
10-1-63
10-1-63
4-1-63
7-1-63
4-1-63
5-20-63
5-25-63
1-1-64
7-1-62
10-1-62
N-10
N-8
275°-32
X 2140.7