


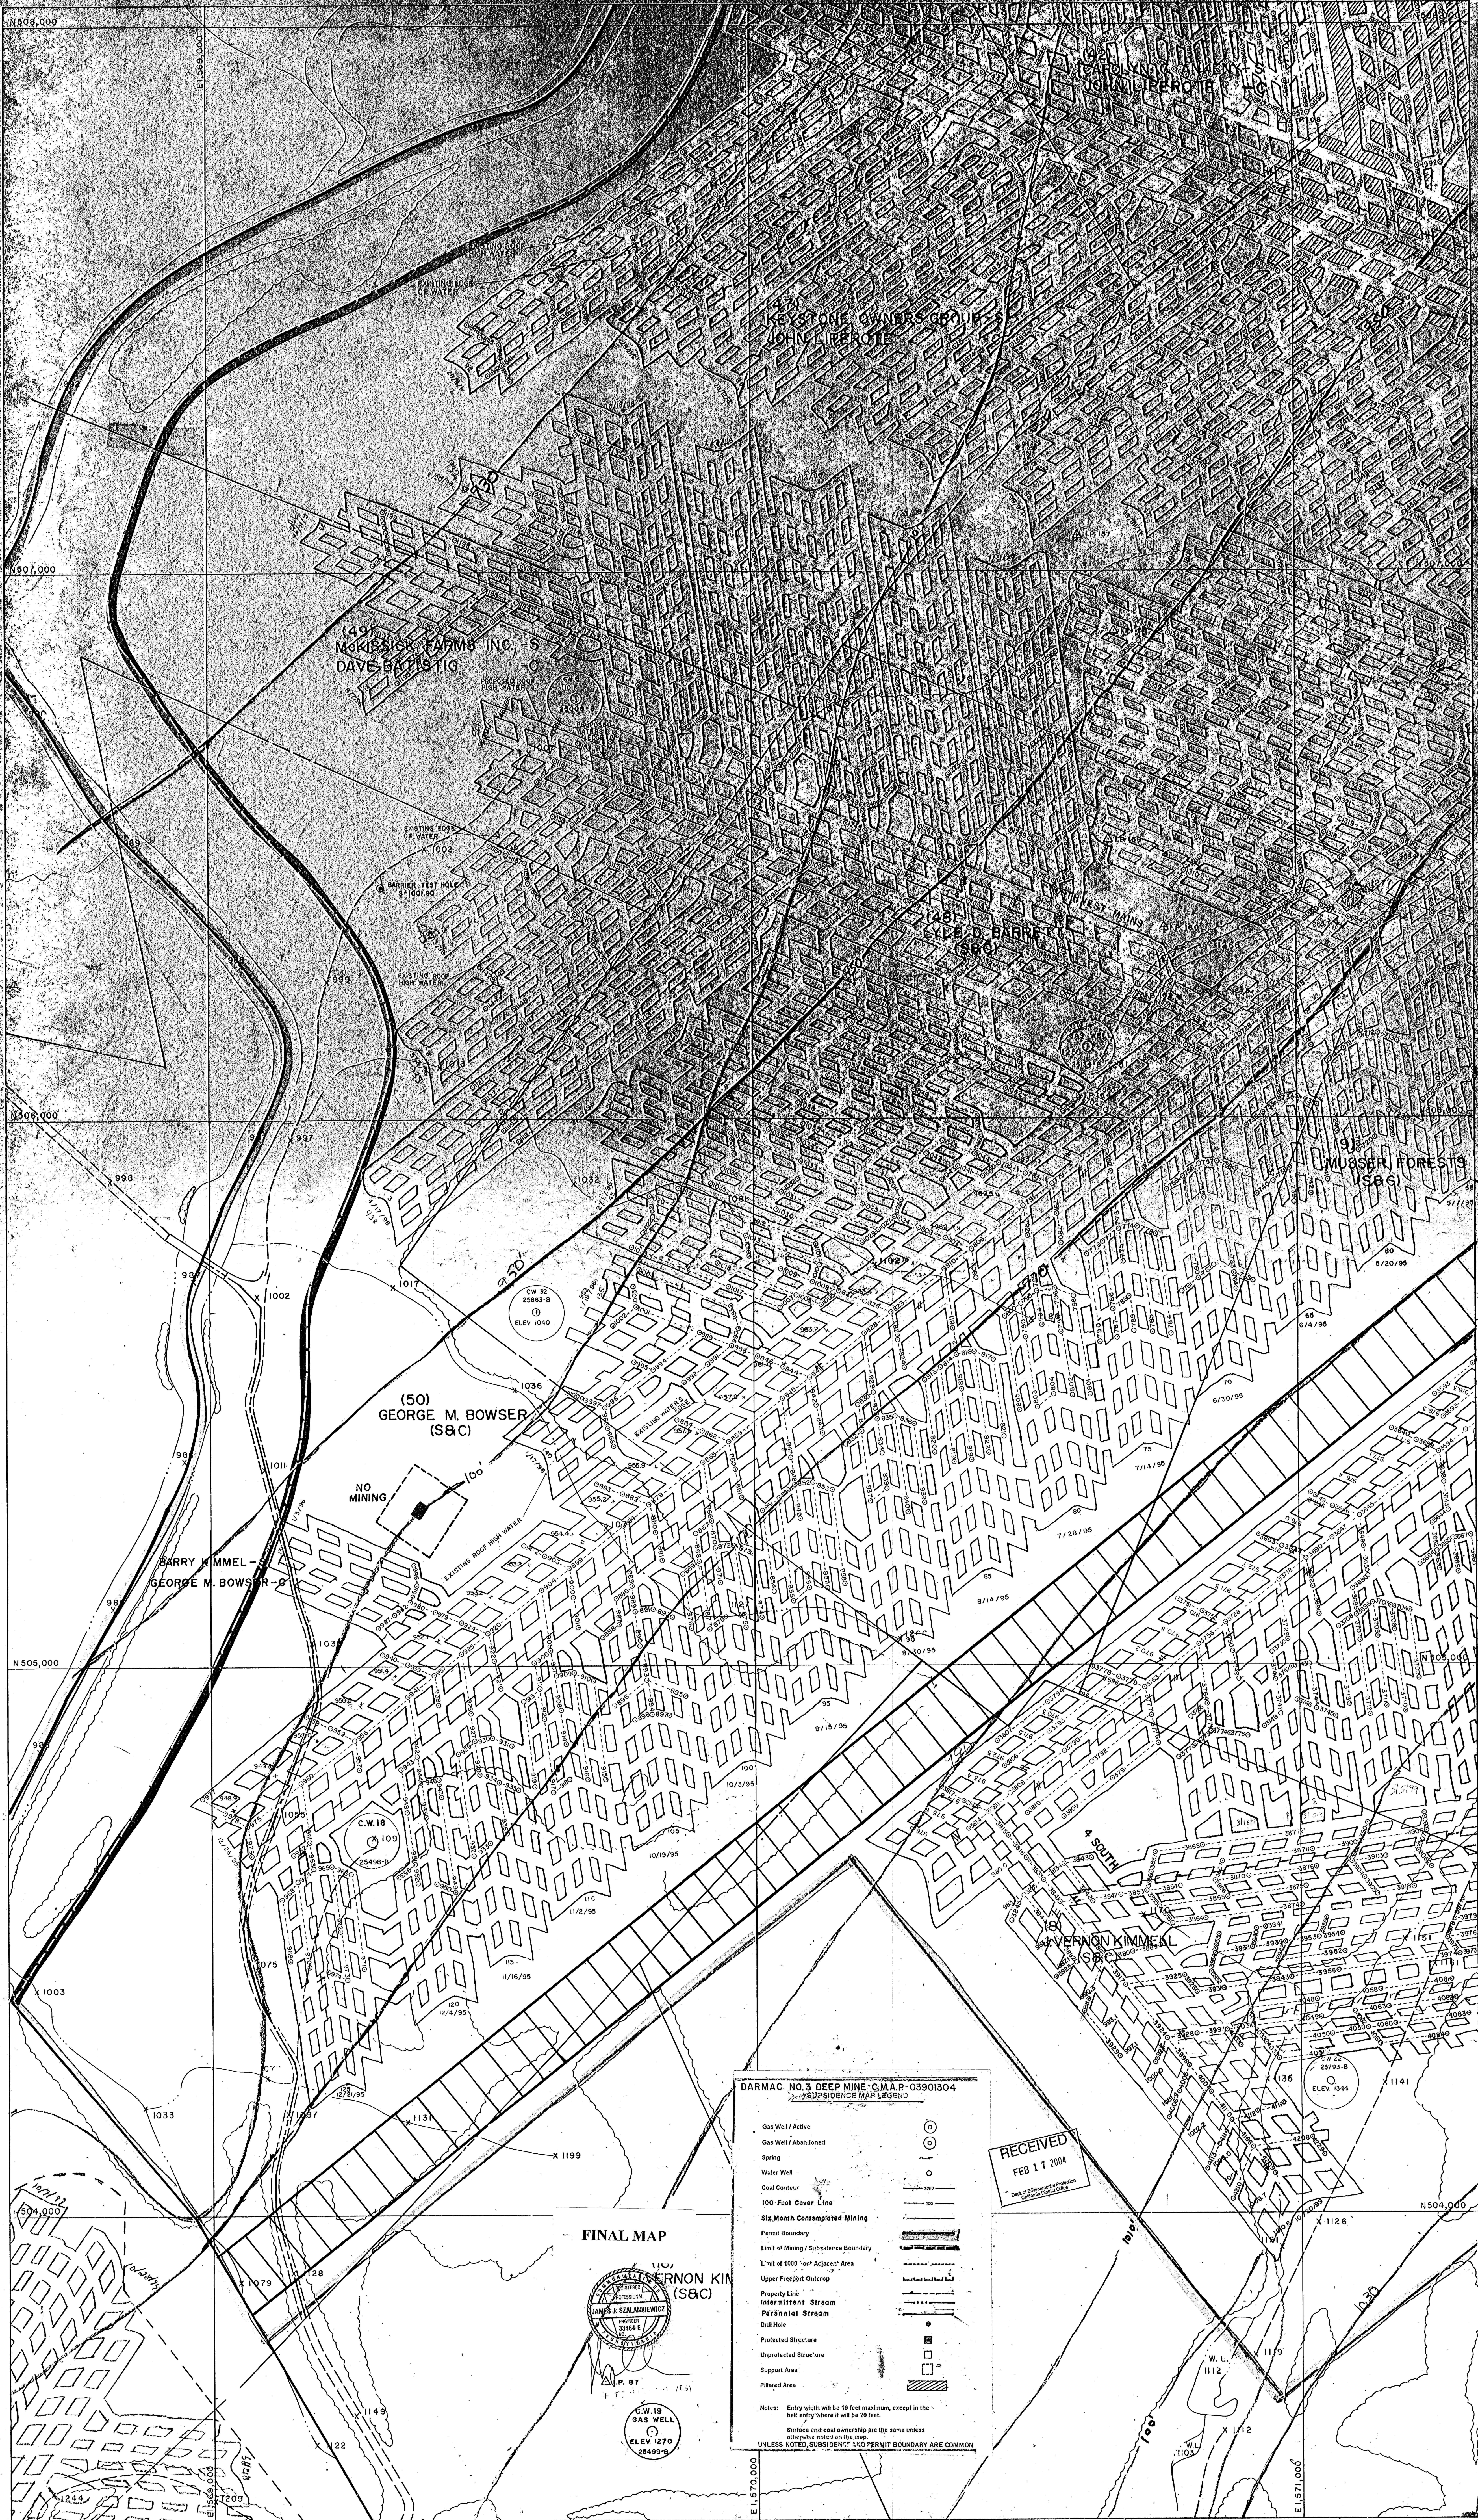

TJS MINING, INC.
DARMAC NO. 3 MINE
PLUMCREEK & ARMSTRONG TOWNSHIPS,
ARMSTRONG & INDIANA COS.

UPPER FREEPORT COAL SEAM

PROJECTION: NAD 83
MINING PERIOD: 11/1/95 TO 5/1/00
SURVEY DATE: 11/2/98