


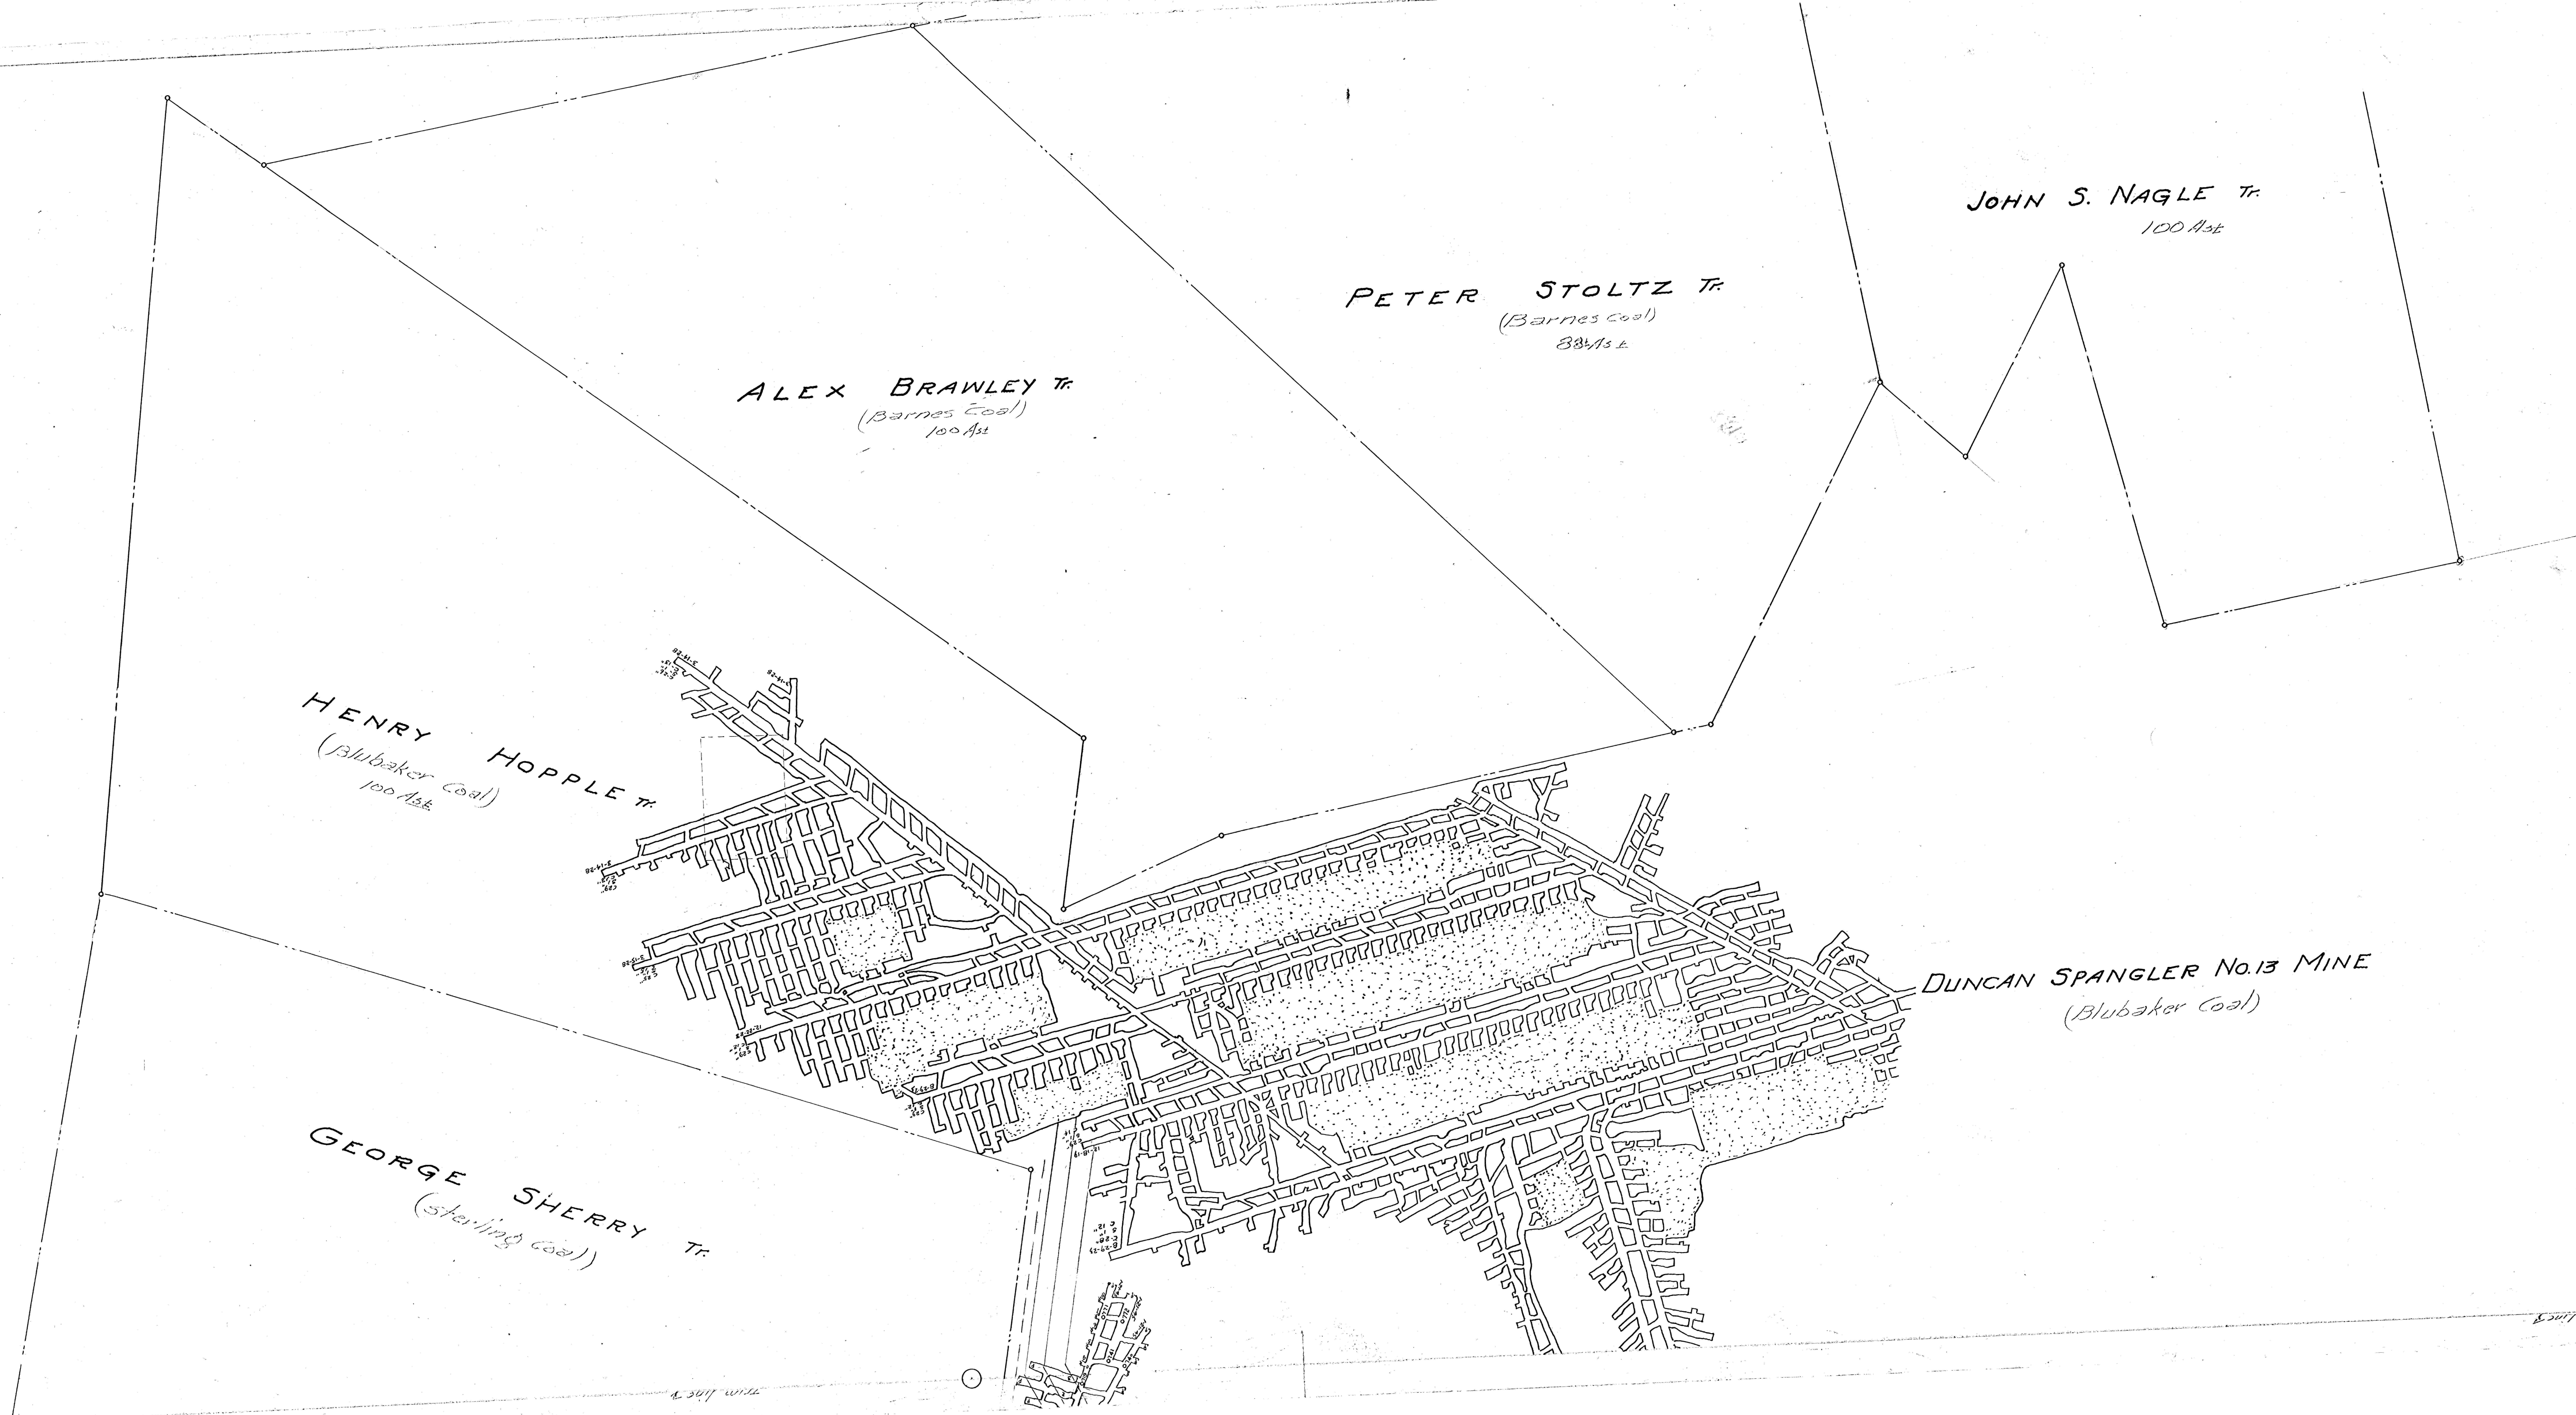

ALEX BRAWLEY Tr.
(Barnes Coal)
100 Acs

PETER STOLTZ Tr.
(Barnes Coal)
88 1/2 Acs

JOHN S. NAGLE Tr.
100 Acs

HENRY HOPPLE Tr.
(Blubaker Coal)
100 Acs

GEORGE SHERRY Tr.
(Sterling Coal)

DUNCAN SPANGLER No. 13 MINE
(Blubaker Coal)