#25 | #25

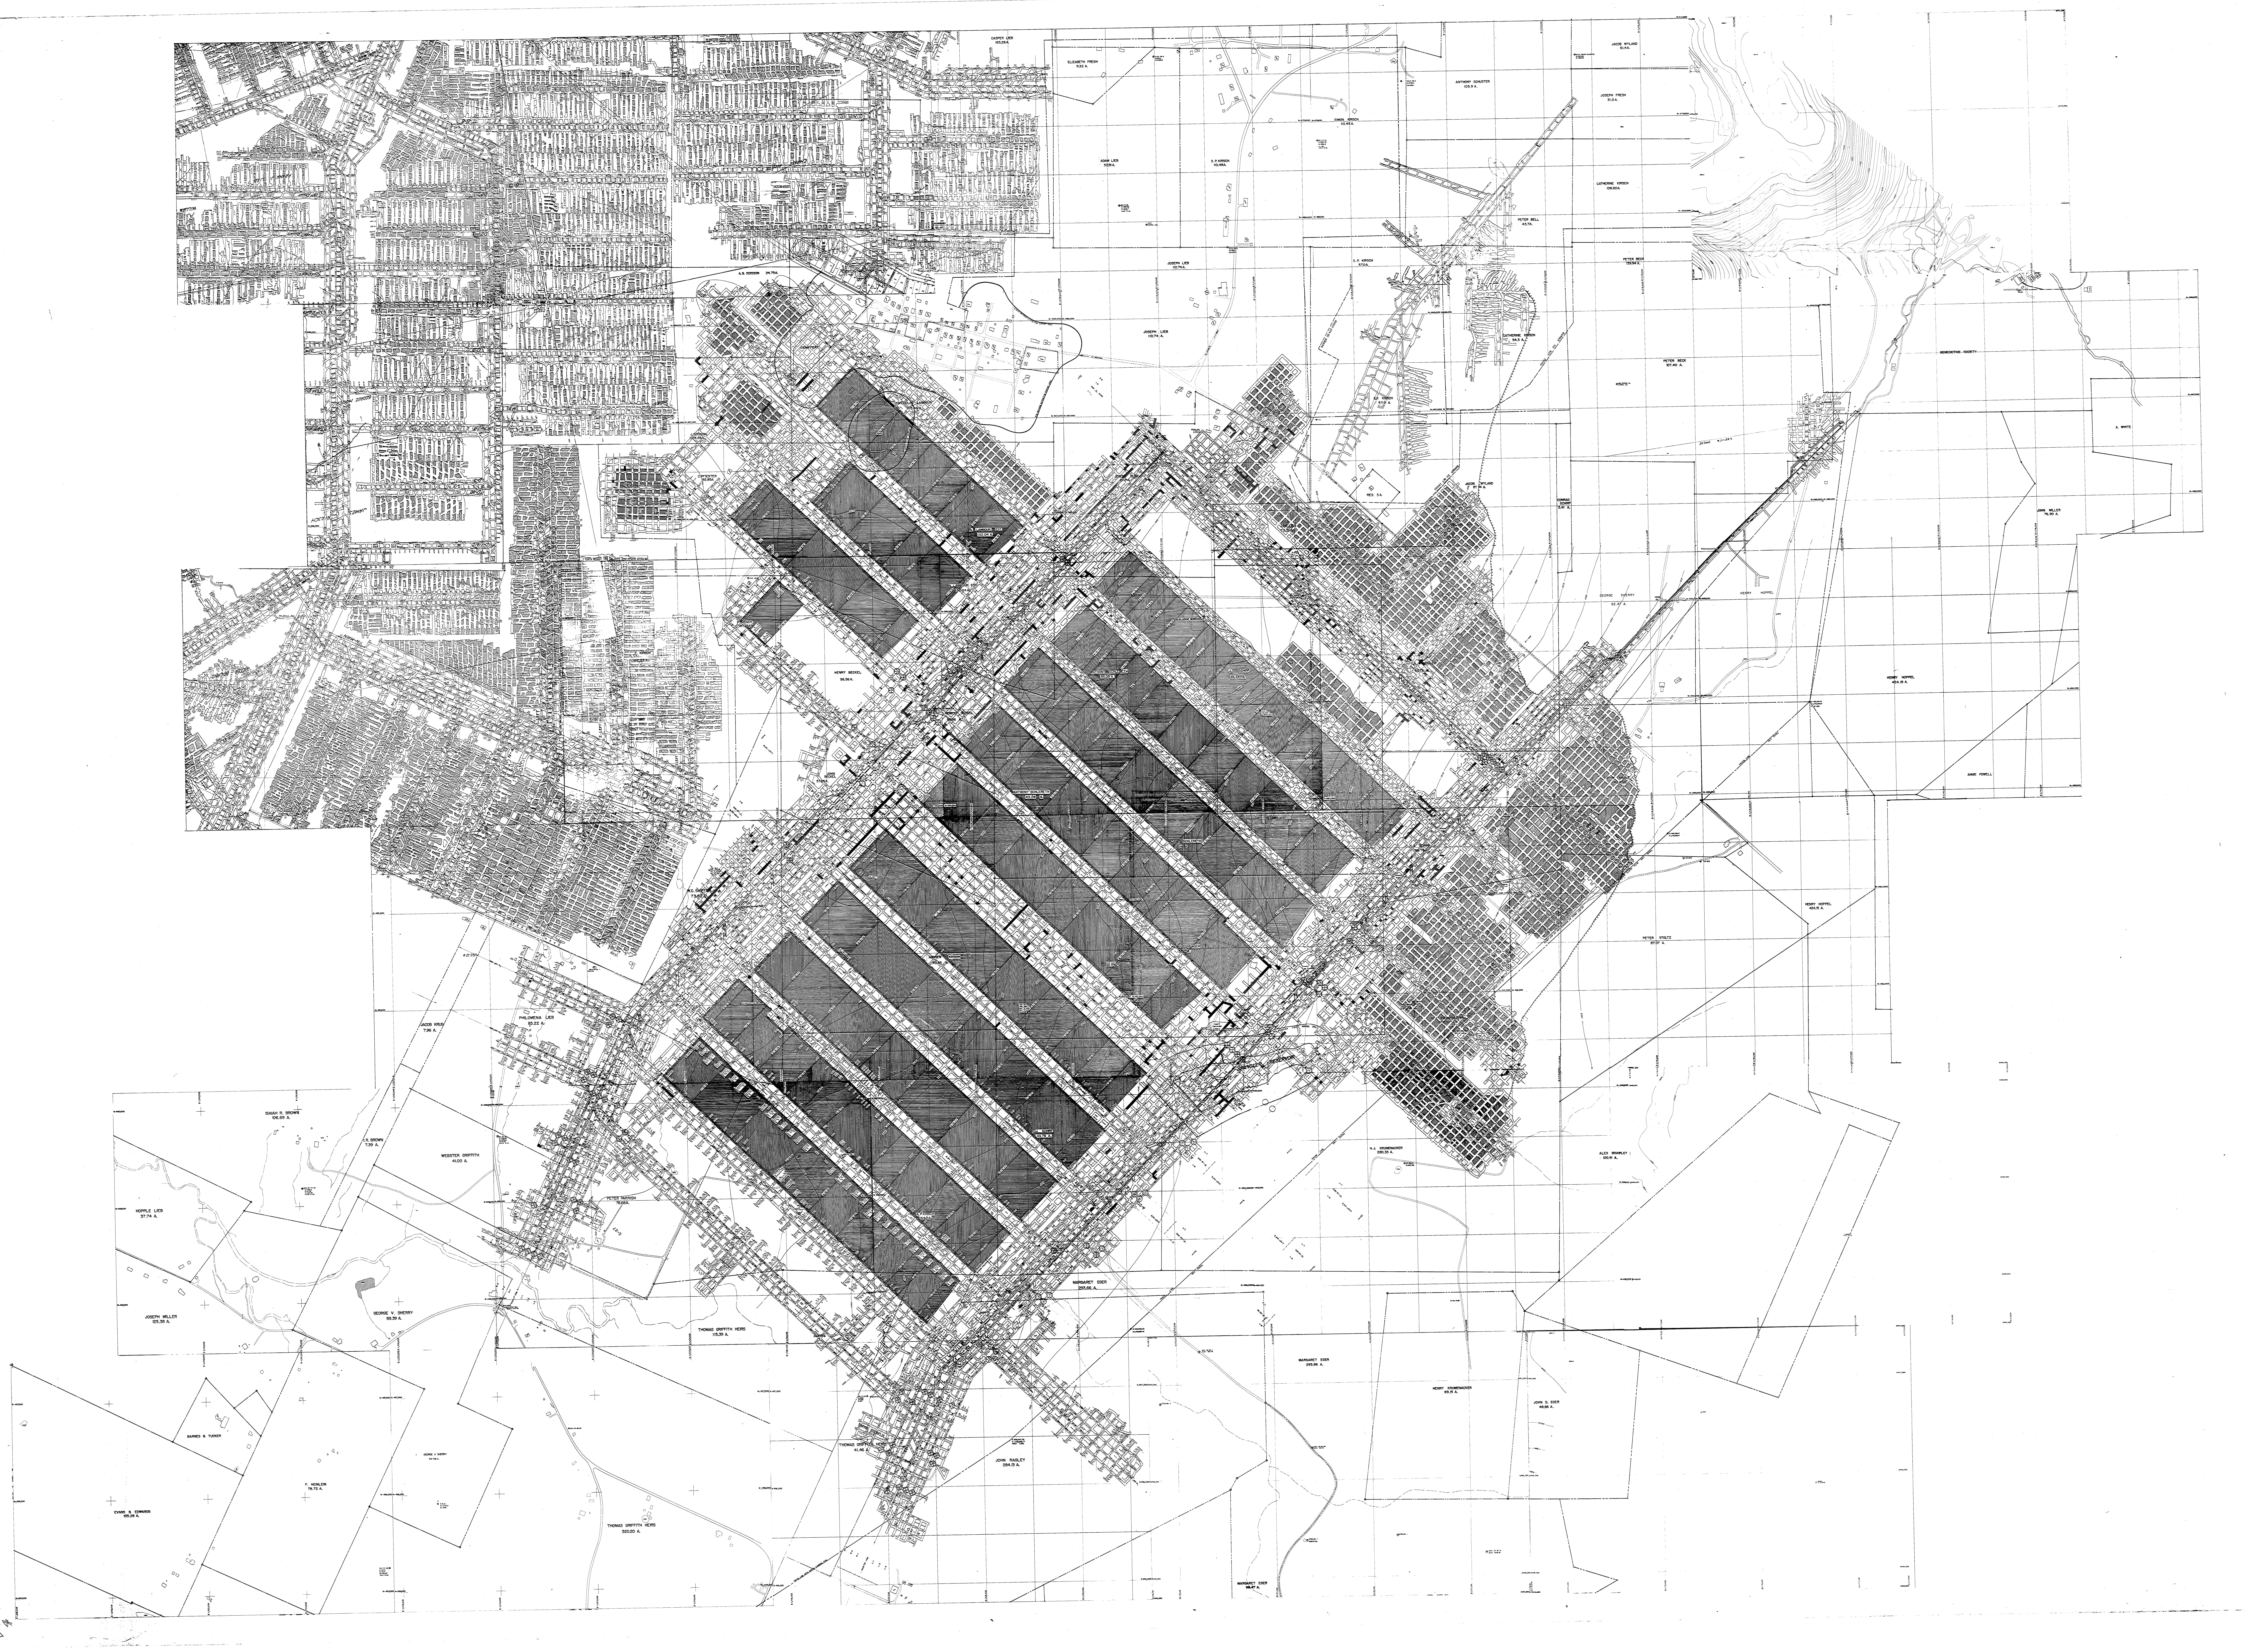
CASPER LIEB
165.28 A.
ELIZABETH FRESH
9.32 A.
ADAM LIEB
52.81 A.
S. P. KIRSCH
110.48 A.
SIMON KIRSCH
110.48 A.
ANTHONY SCHUSTER
105.9 A.
JACOB WYLAND
61.4 A.
JOSEPH FRESH
31.0 A.
CATHERINE KIRSCH
106.60 A.
PETER BELL
43.7 A.
PETER BECK
139.94 A.
JOSEPH LIEB
110.74 A.
S. P. KIRSCH
57.0 A.
CATHERINE KIRSCH
54.3 A.
PETER BECK
107.40 A.
BENEDICTINE SOCIETY
A. WHITE
JOHN MILLER
76.90 A.
RES. 3 A.
JACOB WYLAND
87.74 A.
CONRAD SCHIRF
5.41 A.
GEORGE SHERRY
62.47 A.
HENRY HOPPEL
HENRY HOPPEL
424.15 A.
ANNIE POWELL
HENRY HOPPEL
424.15 A.
PETER STOLTZ
87.07 A.
A. B. SOISSON 24.75 A.
J. SOISSON
C. PFIESTER
92.85 A.
LAMBOUR EST.
132.04 A.
HENRY BECKEL
58.56 A.
JOHN BECKEL
57.26 A.
ANTHONY SCHLERETH
43.06 A.
ANTHONY SCHLERETH
86.08 A.
J. SCHIRF
101.23 A.
SLUDGE BOREHOLE
ANDREW KIRSCH
W. C. SHIFFER
73.62 A.
J. SCHIRF
110.78 A.
A. P. KIRSCH
164.0 A.
SPRINGLER RESERVOIR
H. J. KRUMENACKER
280.33 A.
ALEX BRAWLEY
100.91 A.
PETER PARRISH
78.68 A.
C-27
JACOB KRUG
7.96 A.
PHILOMENA LIEB
83.22 A.
ISAIAH R. BROWN
106.69 A.
I. R. BROWN
7.39 A.
WEBSTER GRIFFITH
41.00 A.
HOPPLE LIEB
37.74 A.
JOSEPH MILLER
125.38 A.
GEORGE V. SHERRY
88.39 A.
THOMAS GRIFFITH HEIRS
115.39 A.
BARNES & TUCKER
F. HEINLEIN
78.72 A.
GEORGE V. SHERRY
EVANS & EDWARDS
105.28 A.
THOMAS GRIFFITH HEIRS
320.20 A.
MARGARET EGER
293.66 A.
MARGARET EGER
293.86 A.
HENRY KRUMENACKER
69.15 A.
JOHN D. EGER
48.66 A.
THOMAS GRIFFITH HEIRS
41.46 A.
JOHN RAGLEY
284.13 A.
MARGARET EGER
98.47 A.