


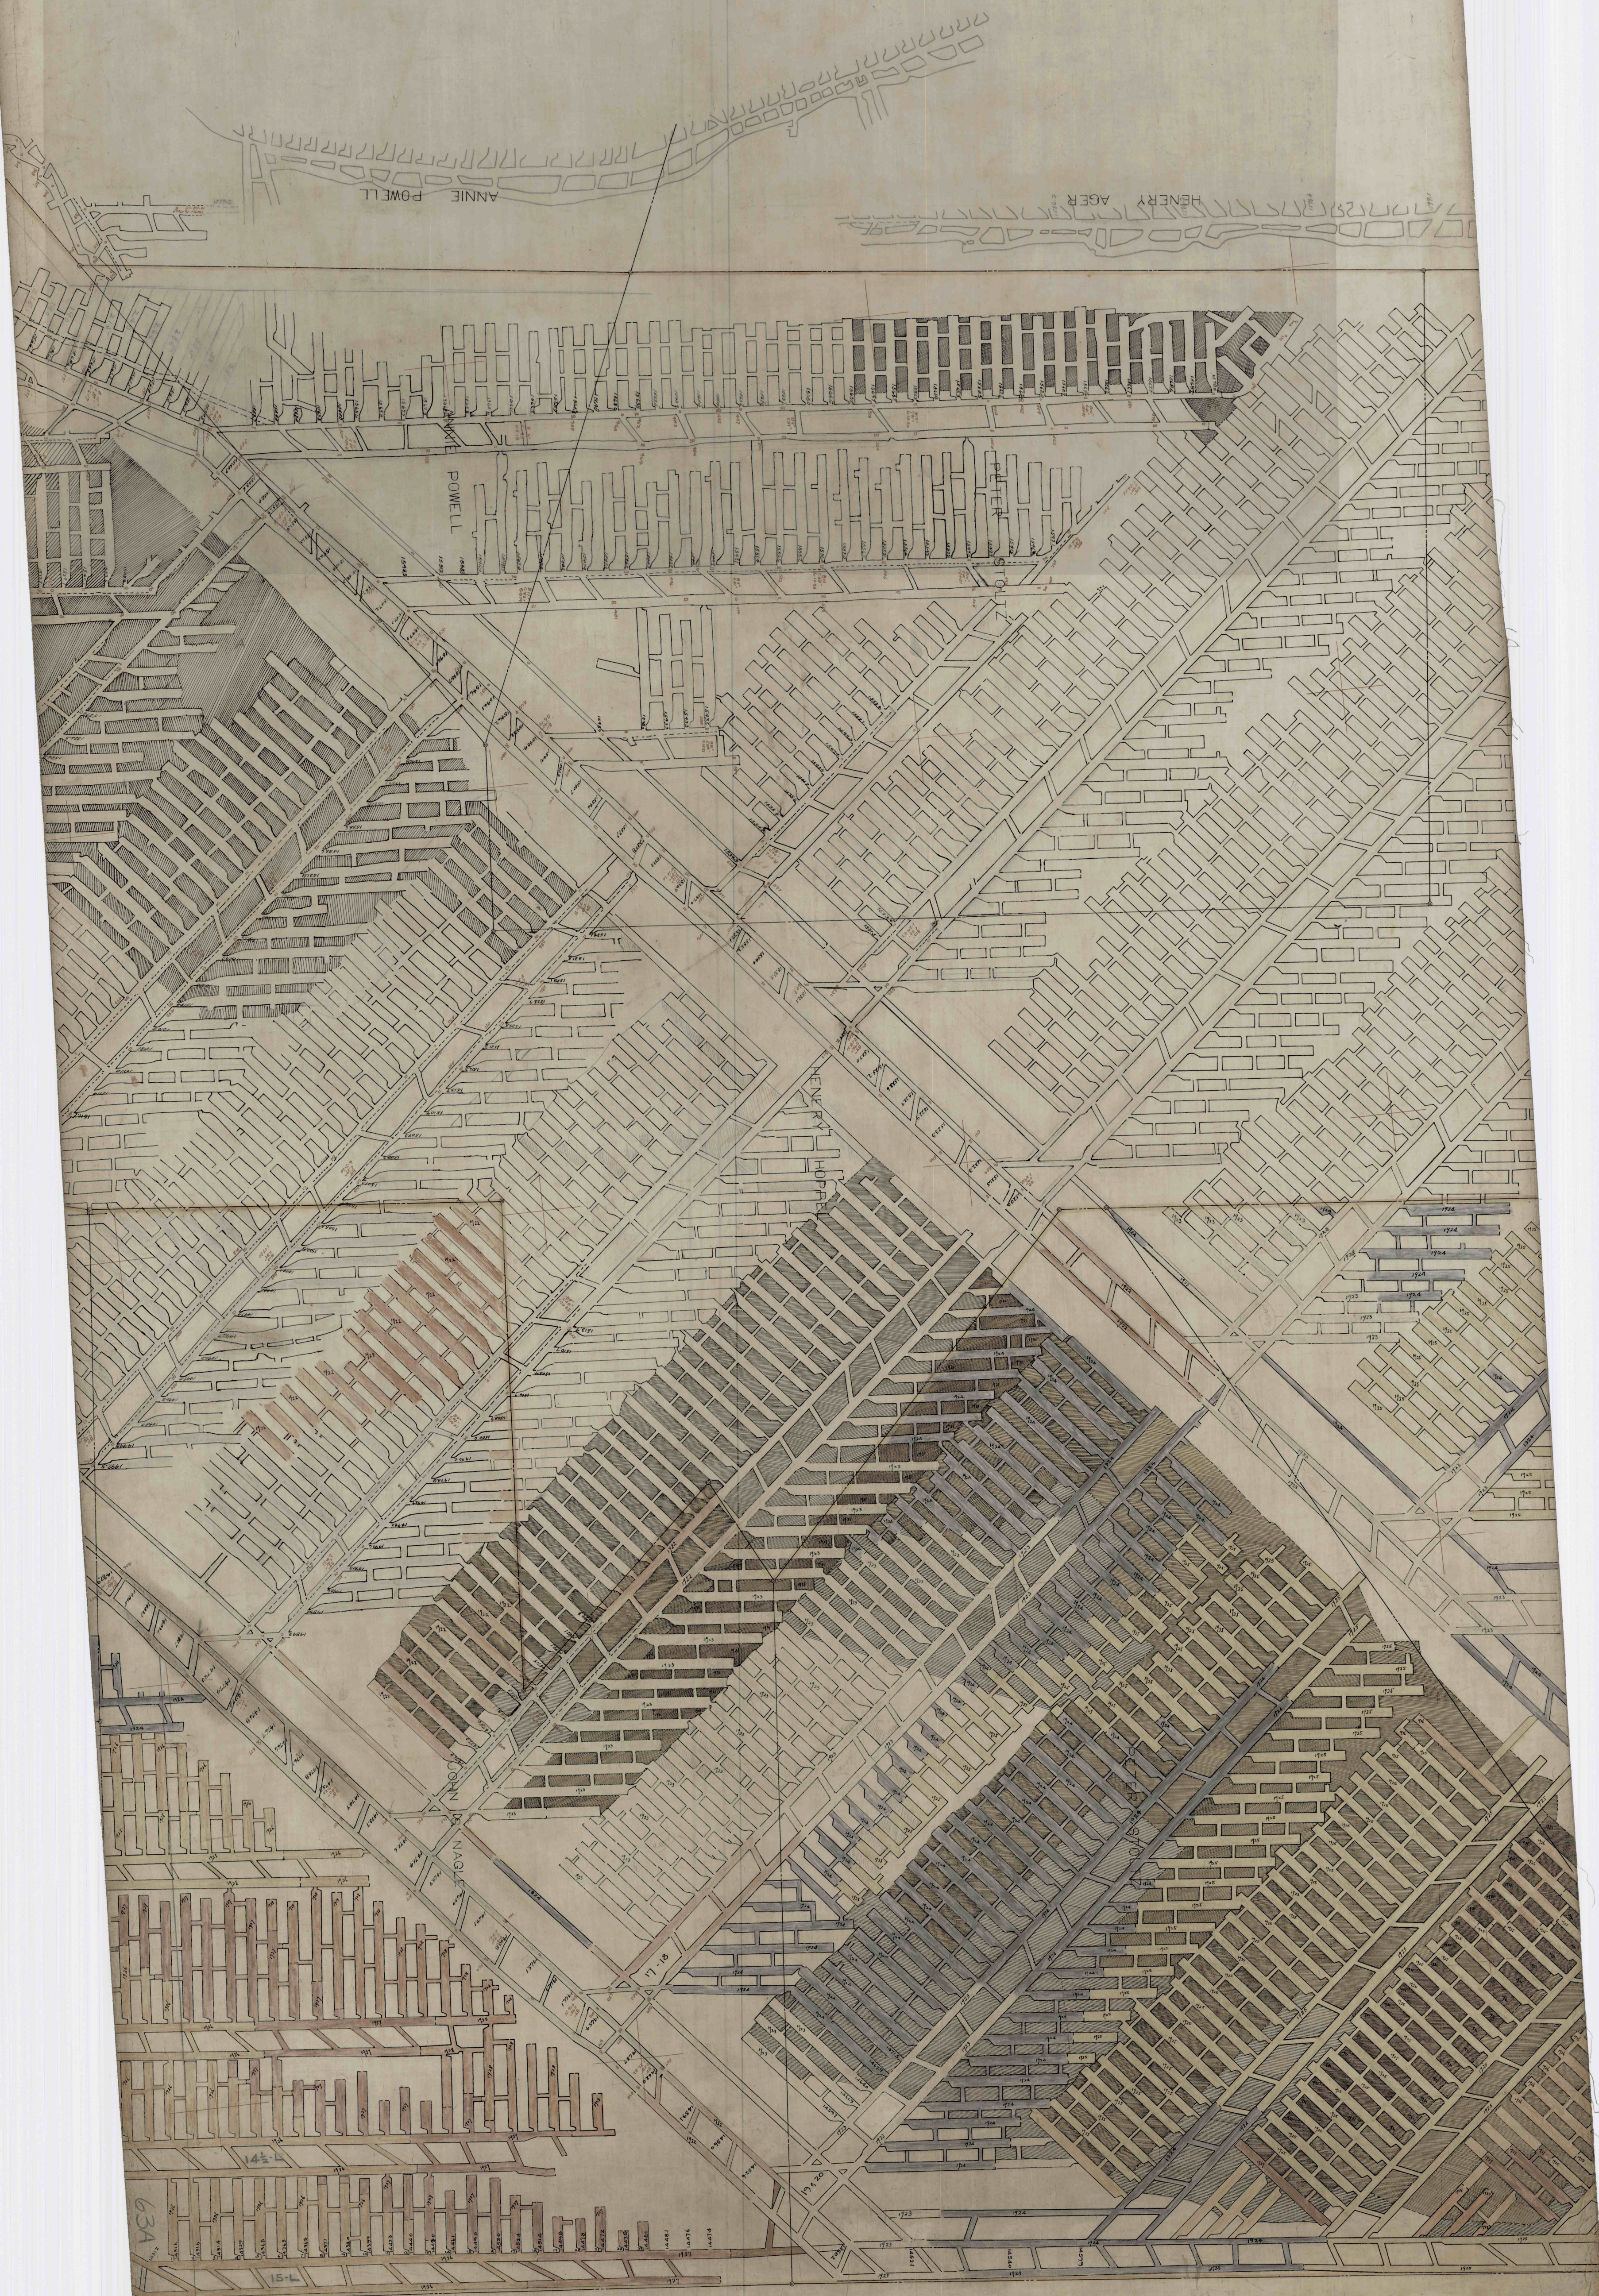

ANNIE POWELL

HENRY AGER

POWELL

HENRY HOPKINSON

JOHN

634