


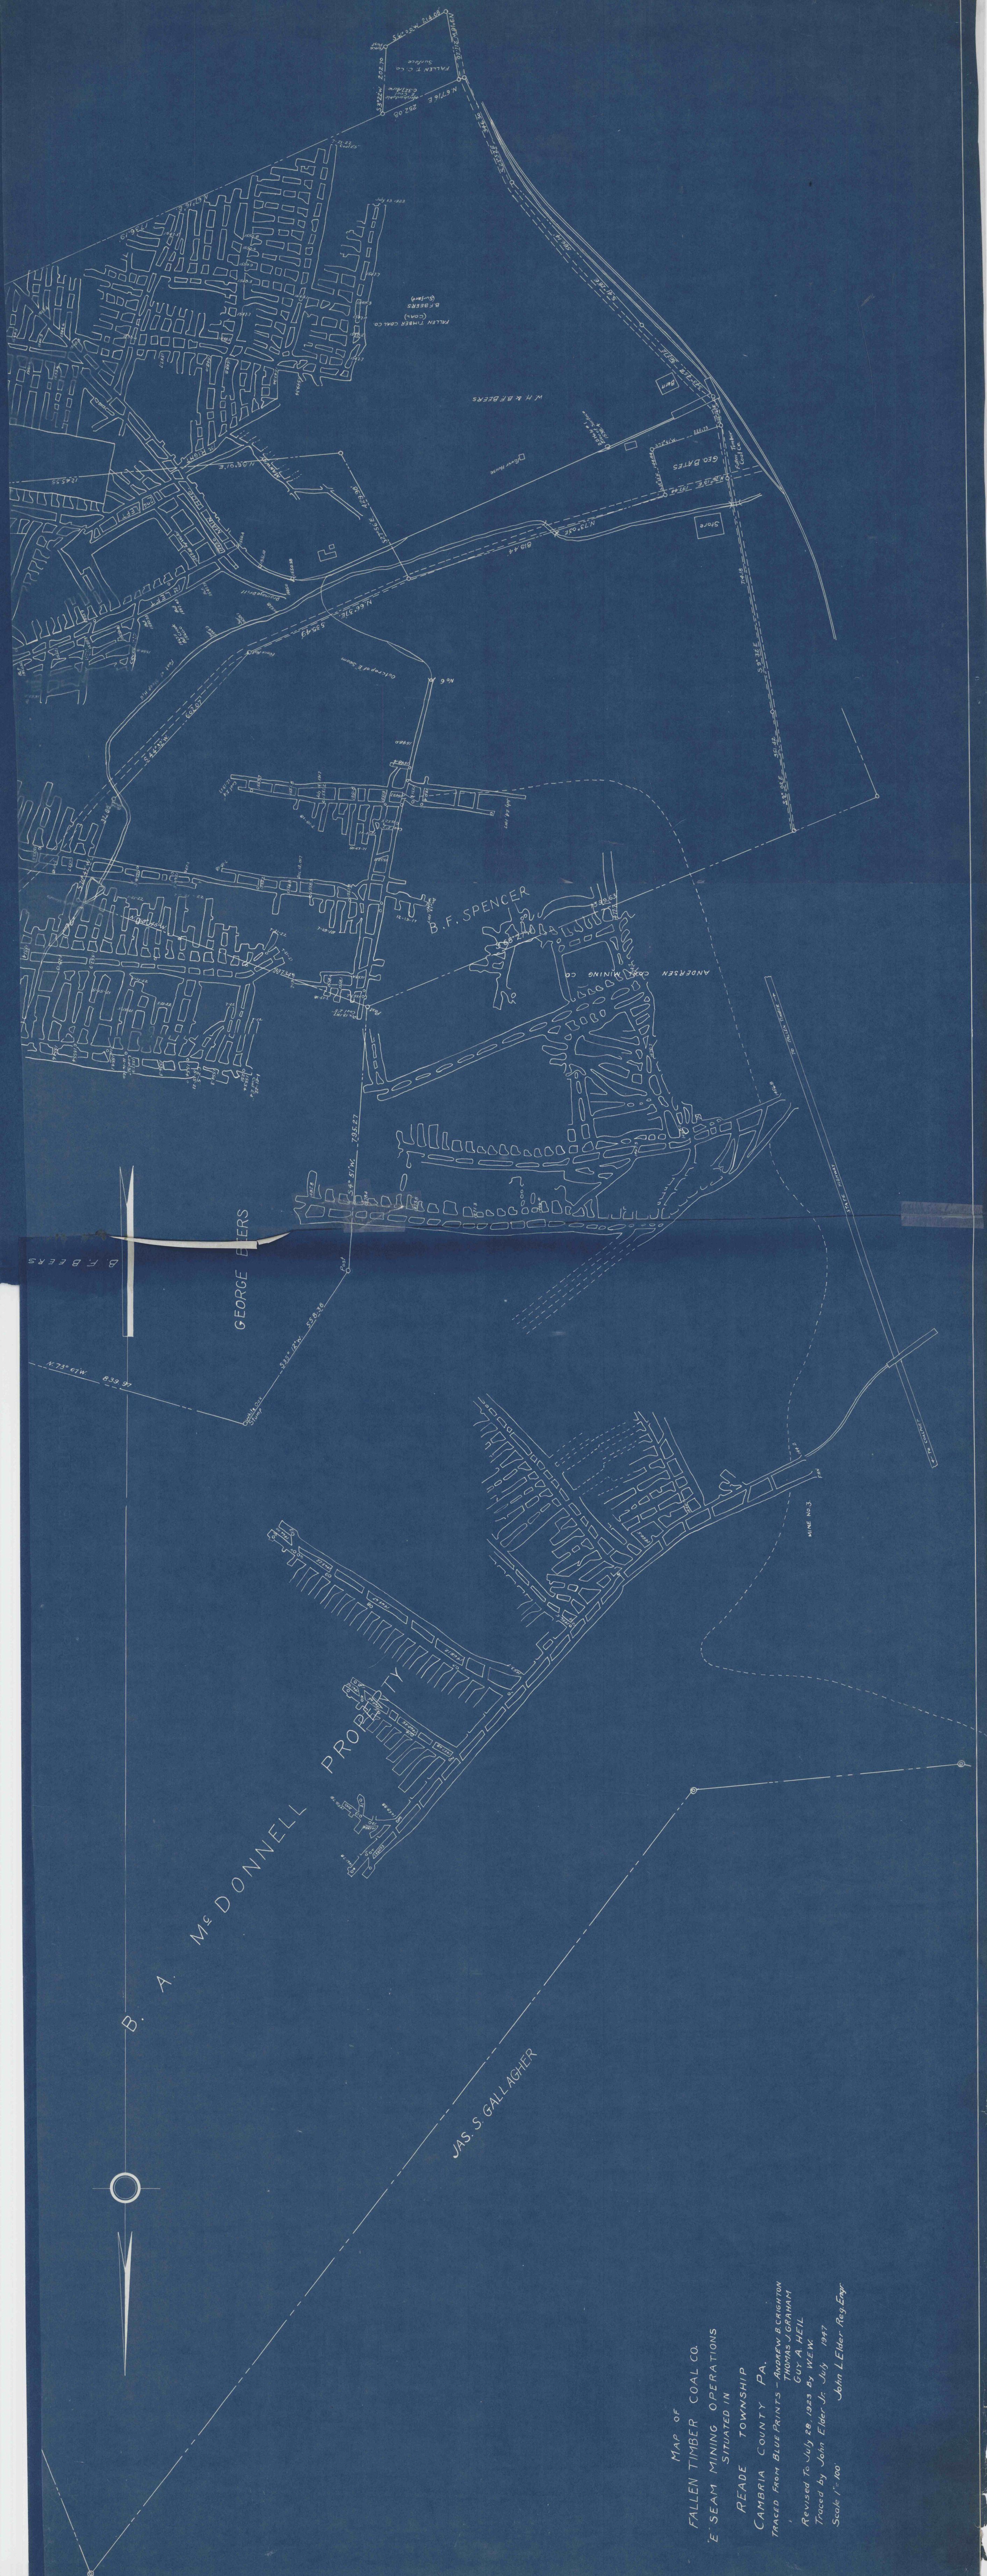

MAP OF
 FALLEN TIMBER COAL CO.
 'E' SEAM MINING OPERATIONS
 SITUATED IN
 READE TOWNSHIP
 CAMBRIA COUNTY PA.
 TRACED FROM BLUE PRINTS - ANDREW B. CRIGHTON
 THOMAS J. GRAHAM
 GUY A. HEIL
 Revised To July 28, 1923 BY WEW
 Traced by John Elder Jr. July 1927
 Scale 1" = 100' John L. Elder Reg. Eng.