


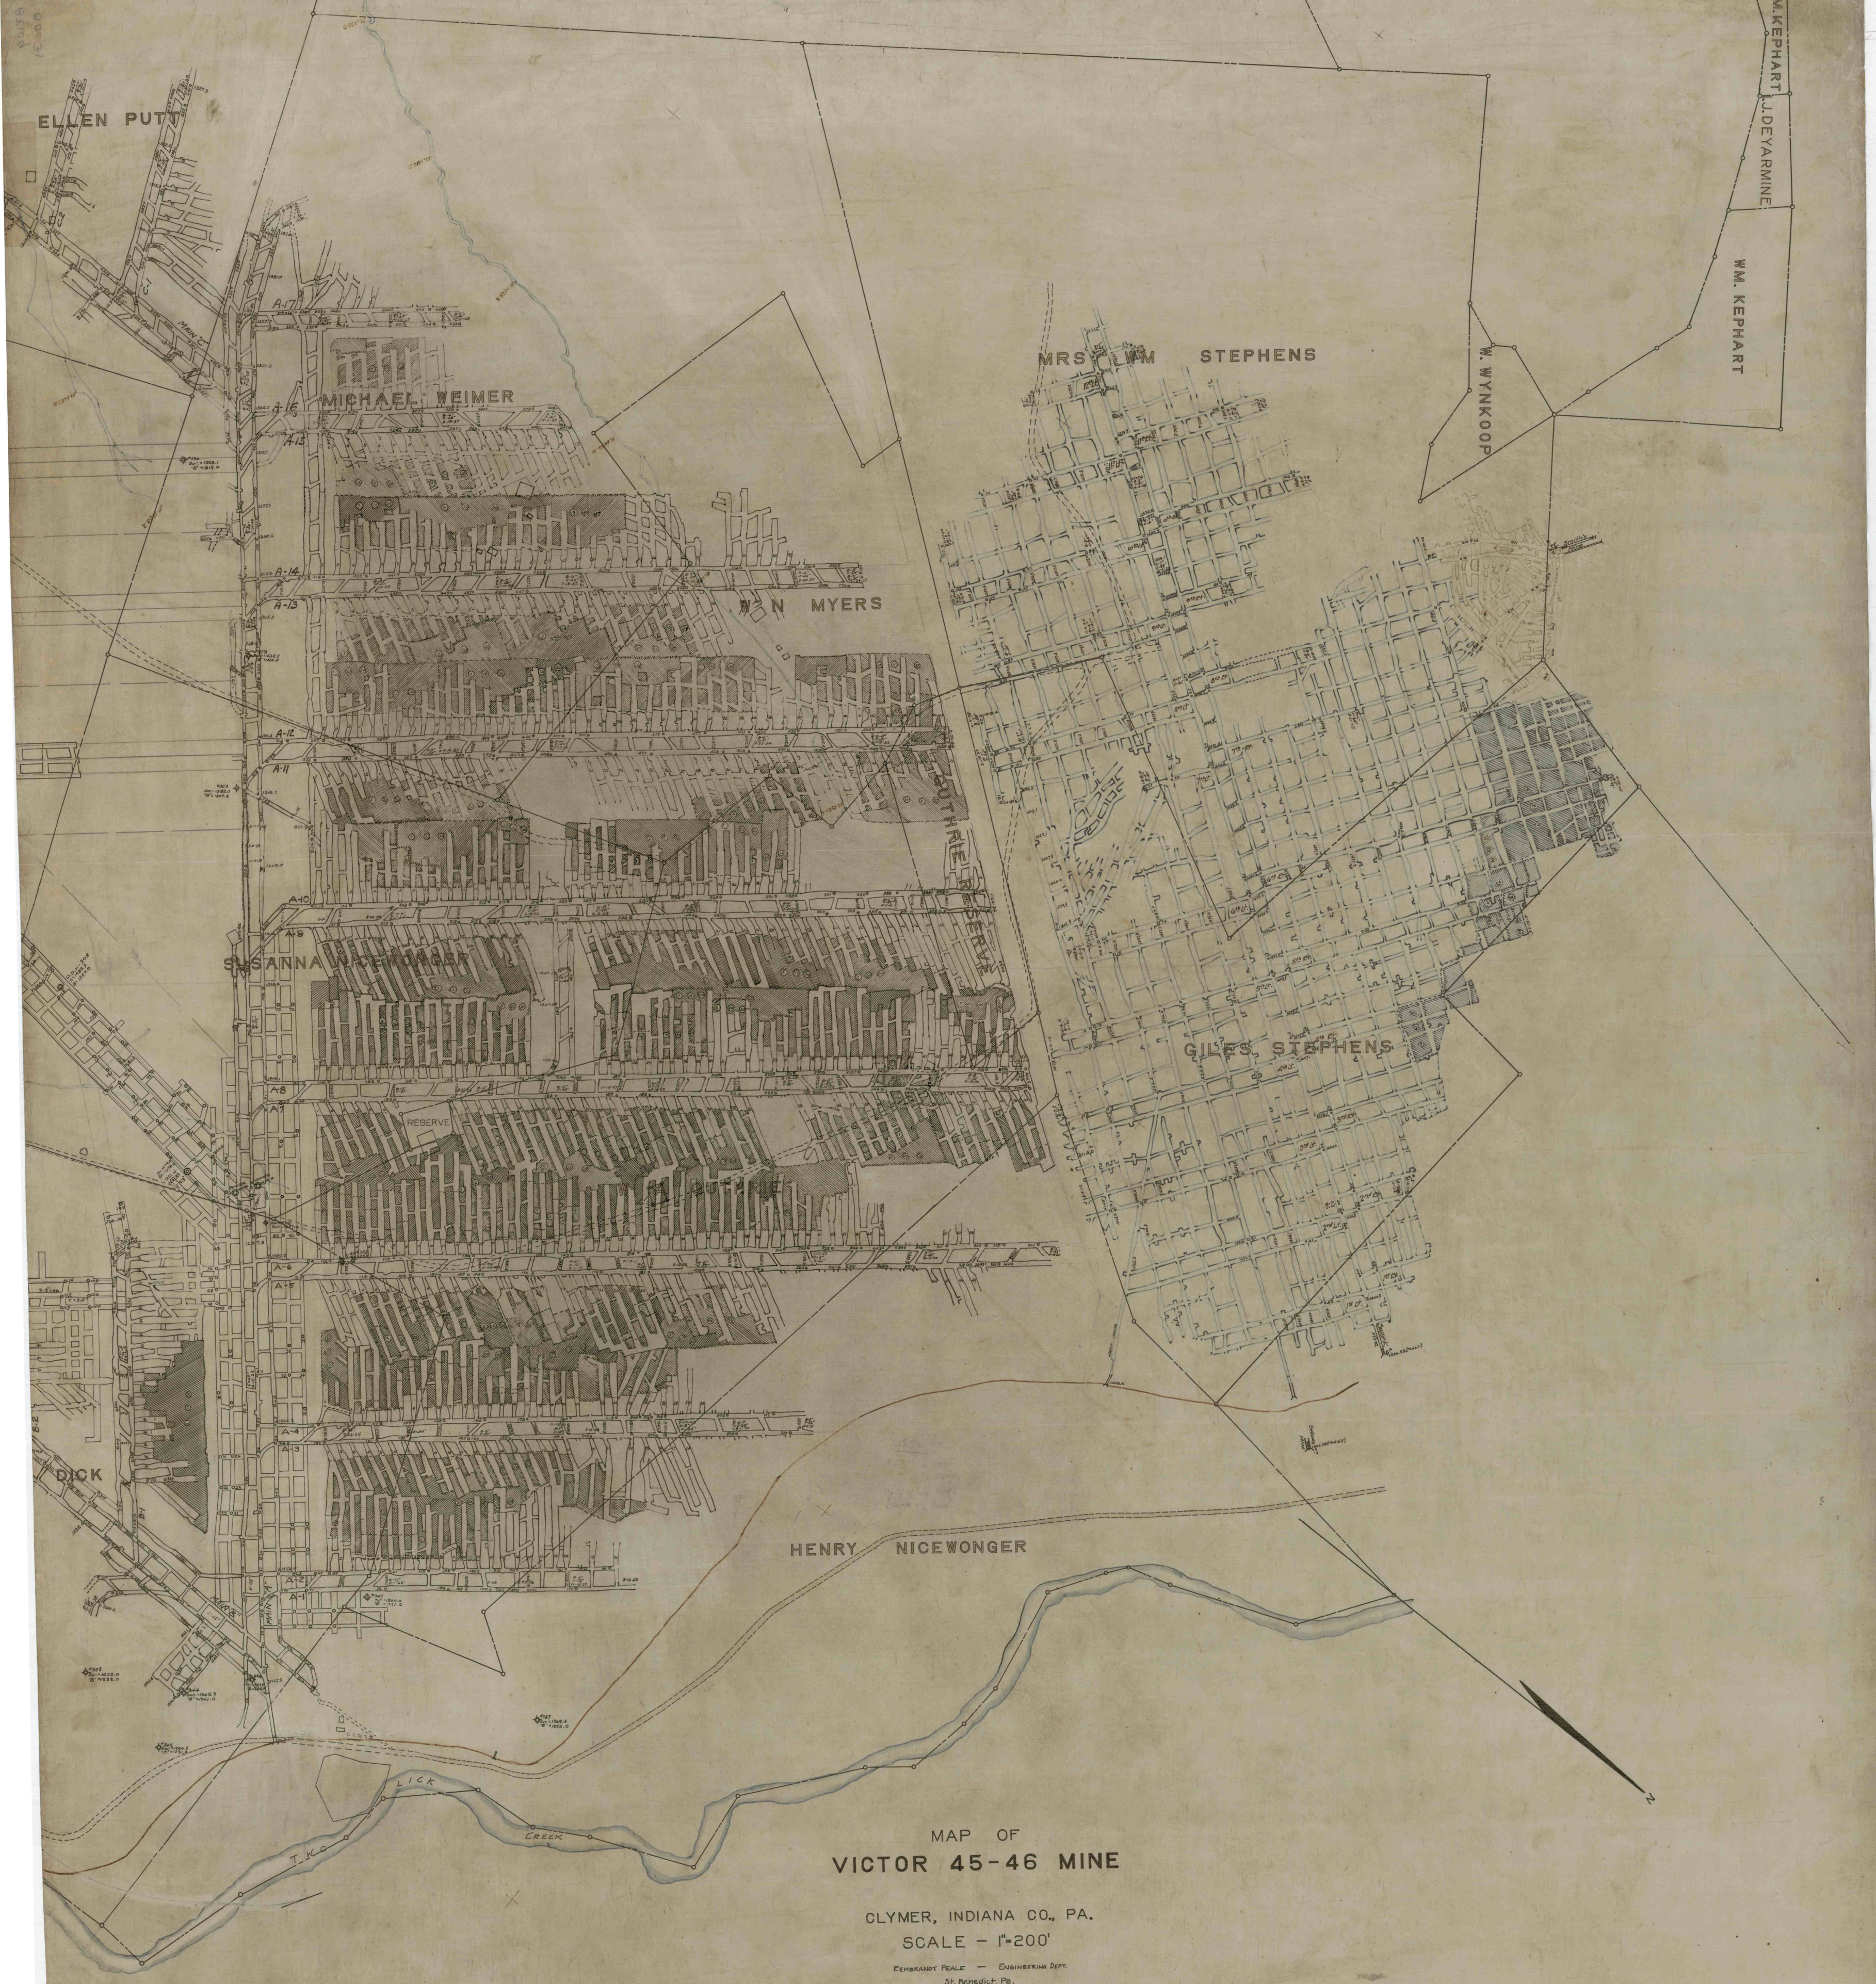

MAP OF
VICTOR 45-46 MINE

CLYMER, INDIANA CO., PA.
SCALE - 1"=200'

KEMBRANDT PEASE - ENGINEERING DEPT.
St. Benedict, Pa.