


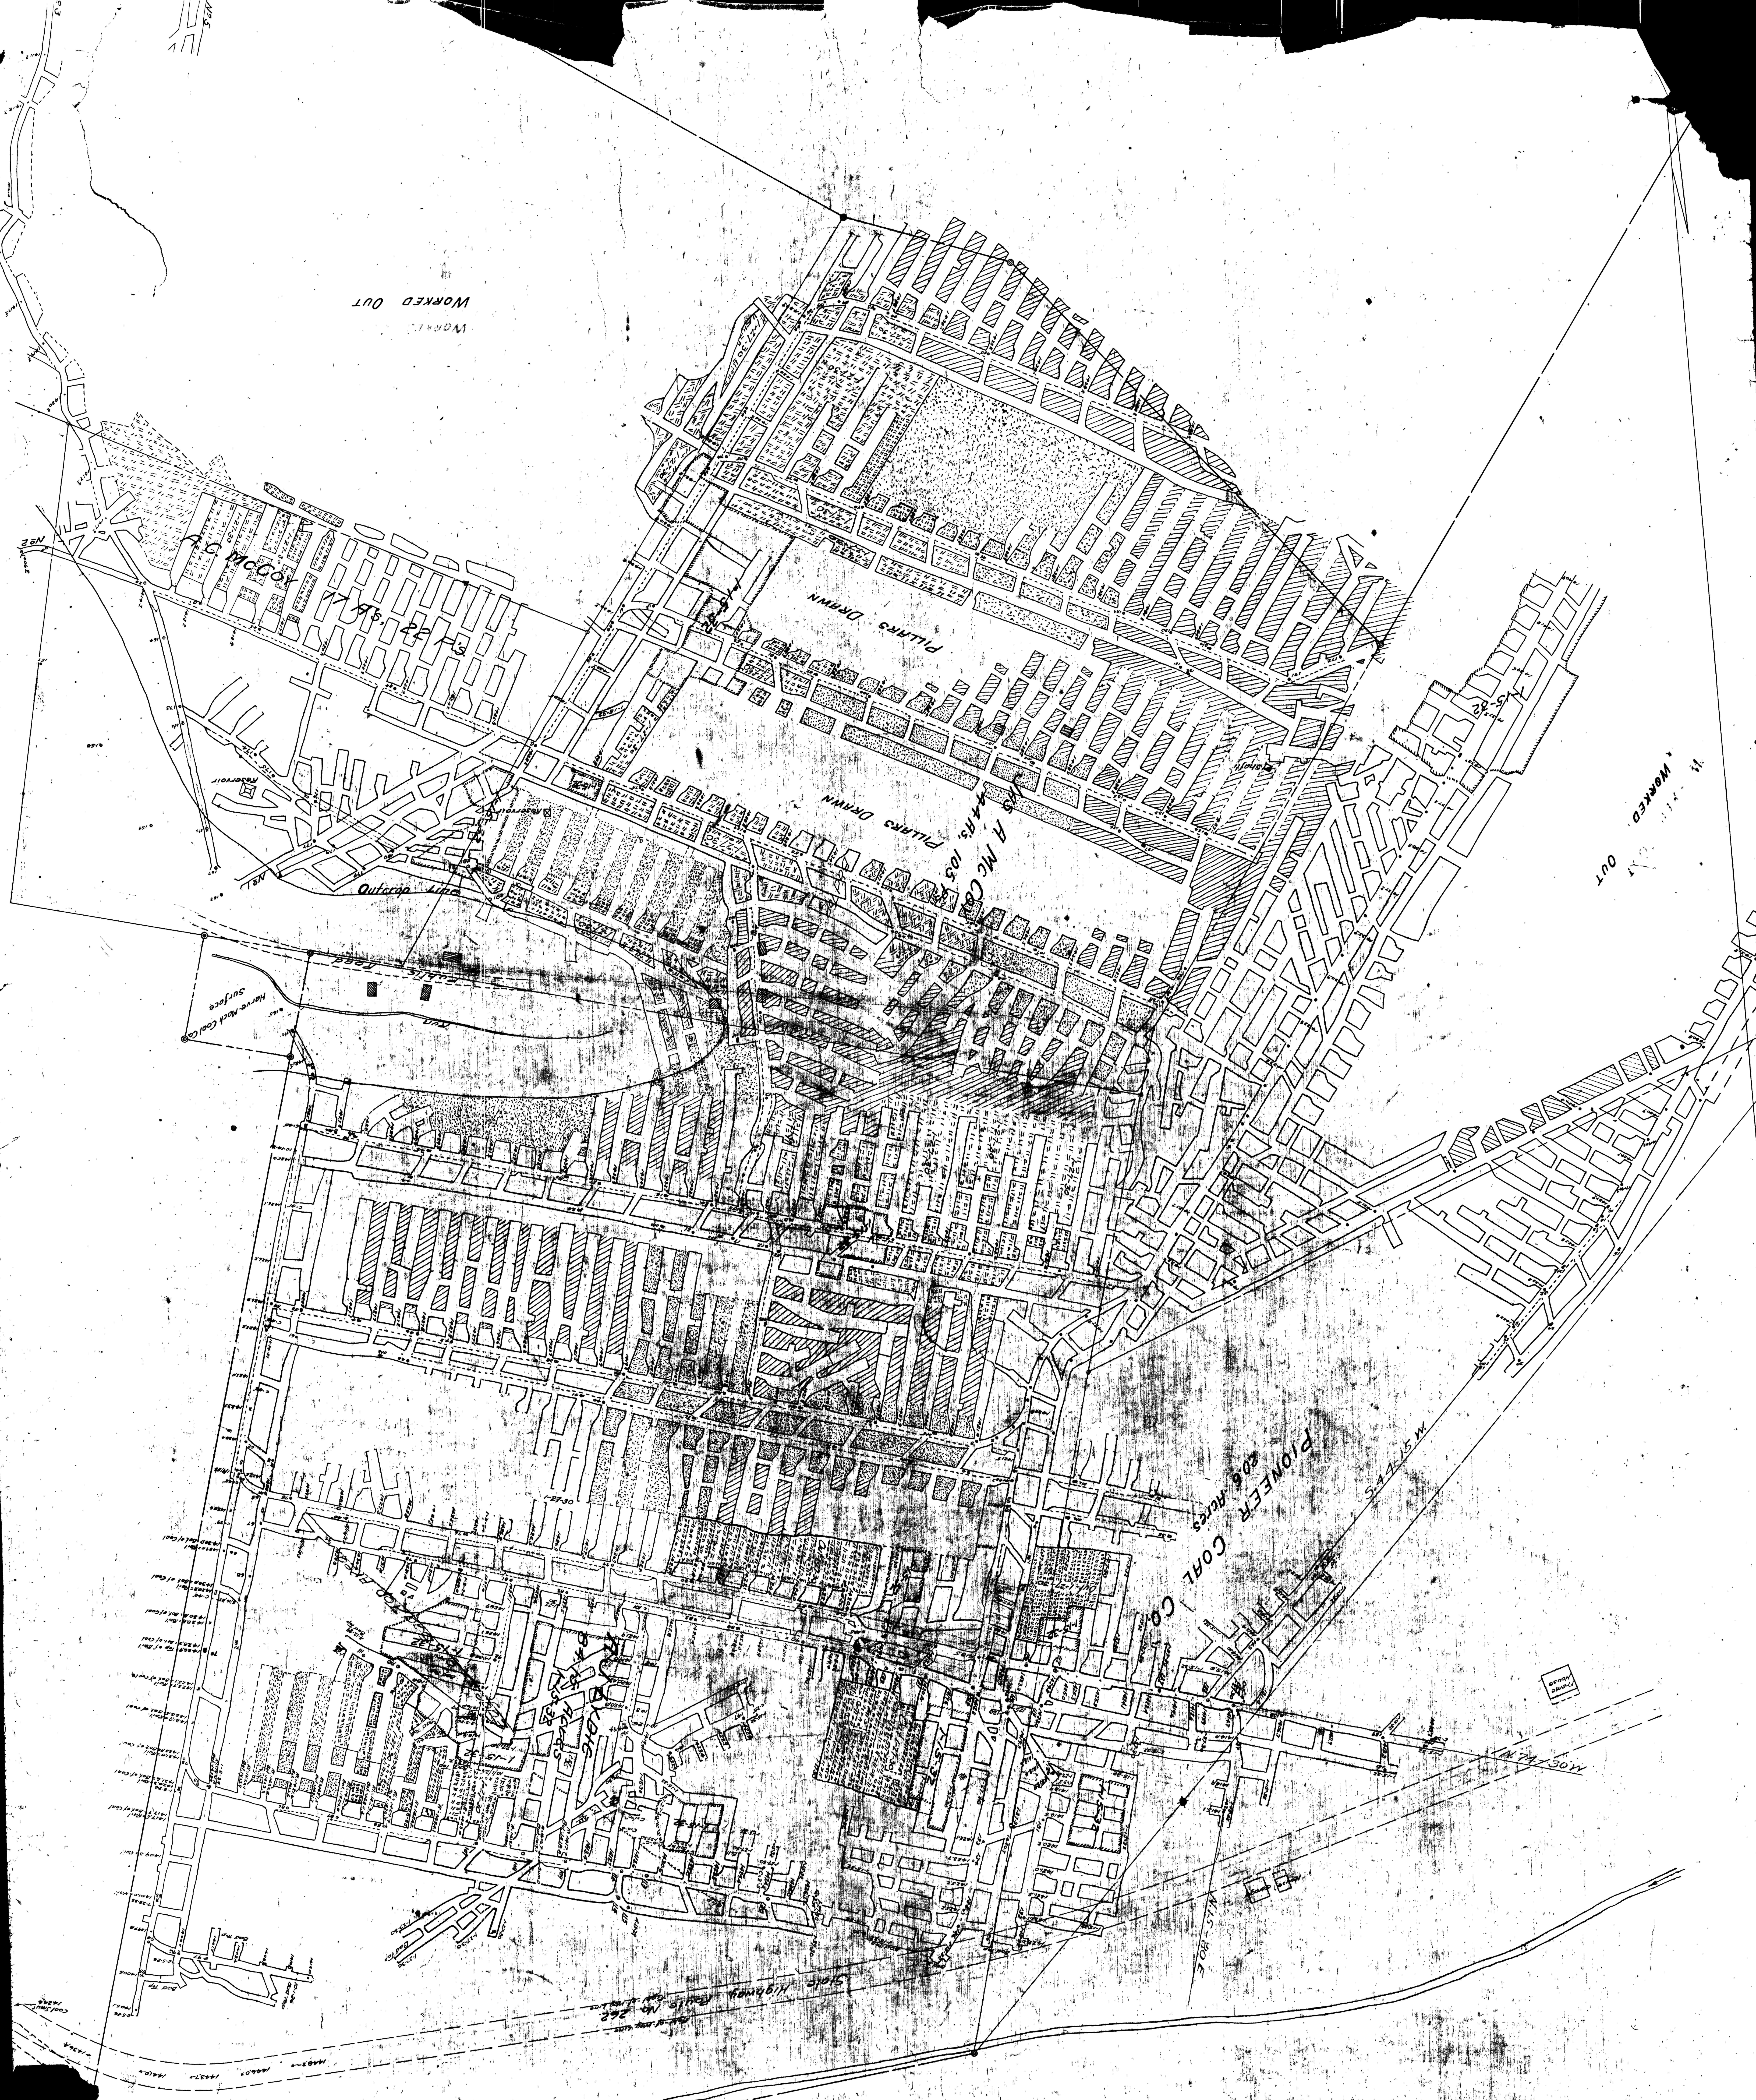



HARVE-MACK COAL CO.
STARFORD, INDIANA CO. PA.
Scale: 1 in. = 100 ft.
Thomas Feeler, Civ. Engr.
Posted Oct. 1, 1926
Jan. 27, 1930
15, 1932