


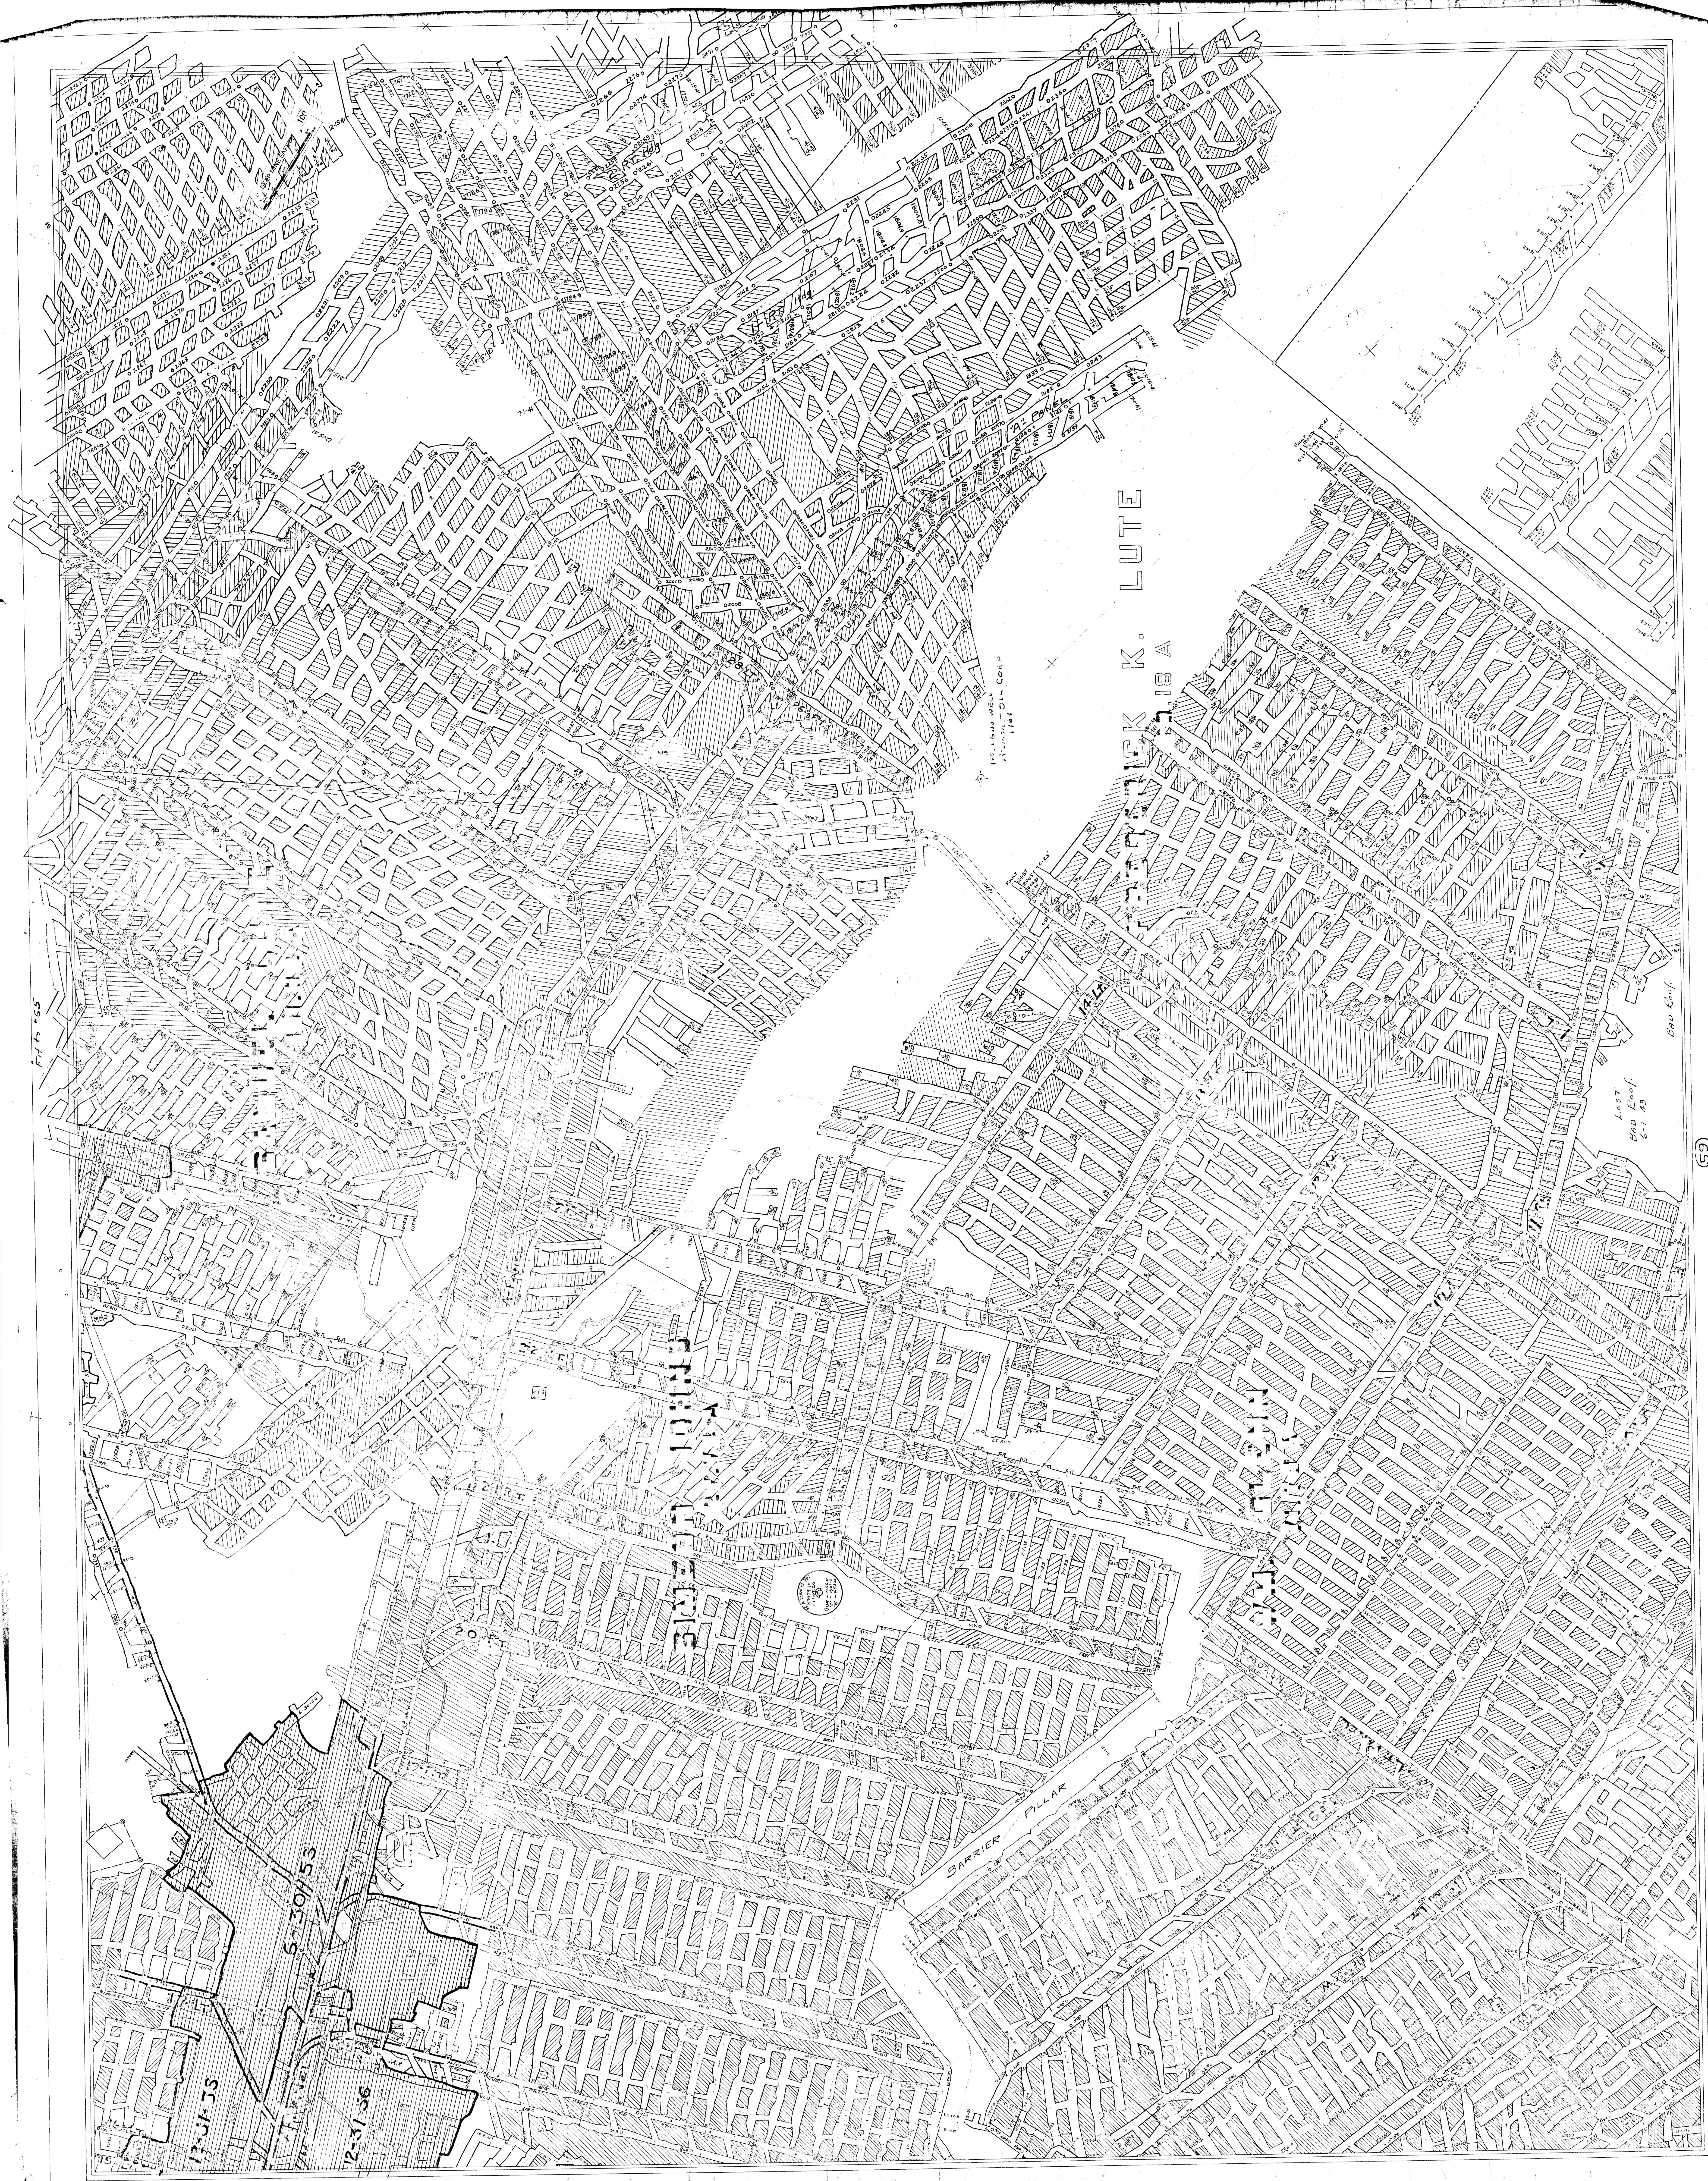

12-31-55

12-31-56

12-31-55

BARRIER PILLAR

K. LUTE

K. LUTE

Lost
Bad Roof
6-1-43