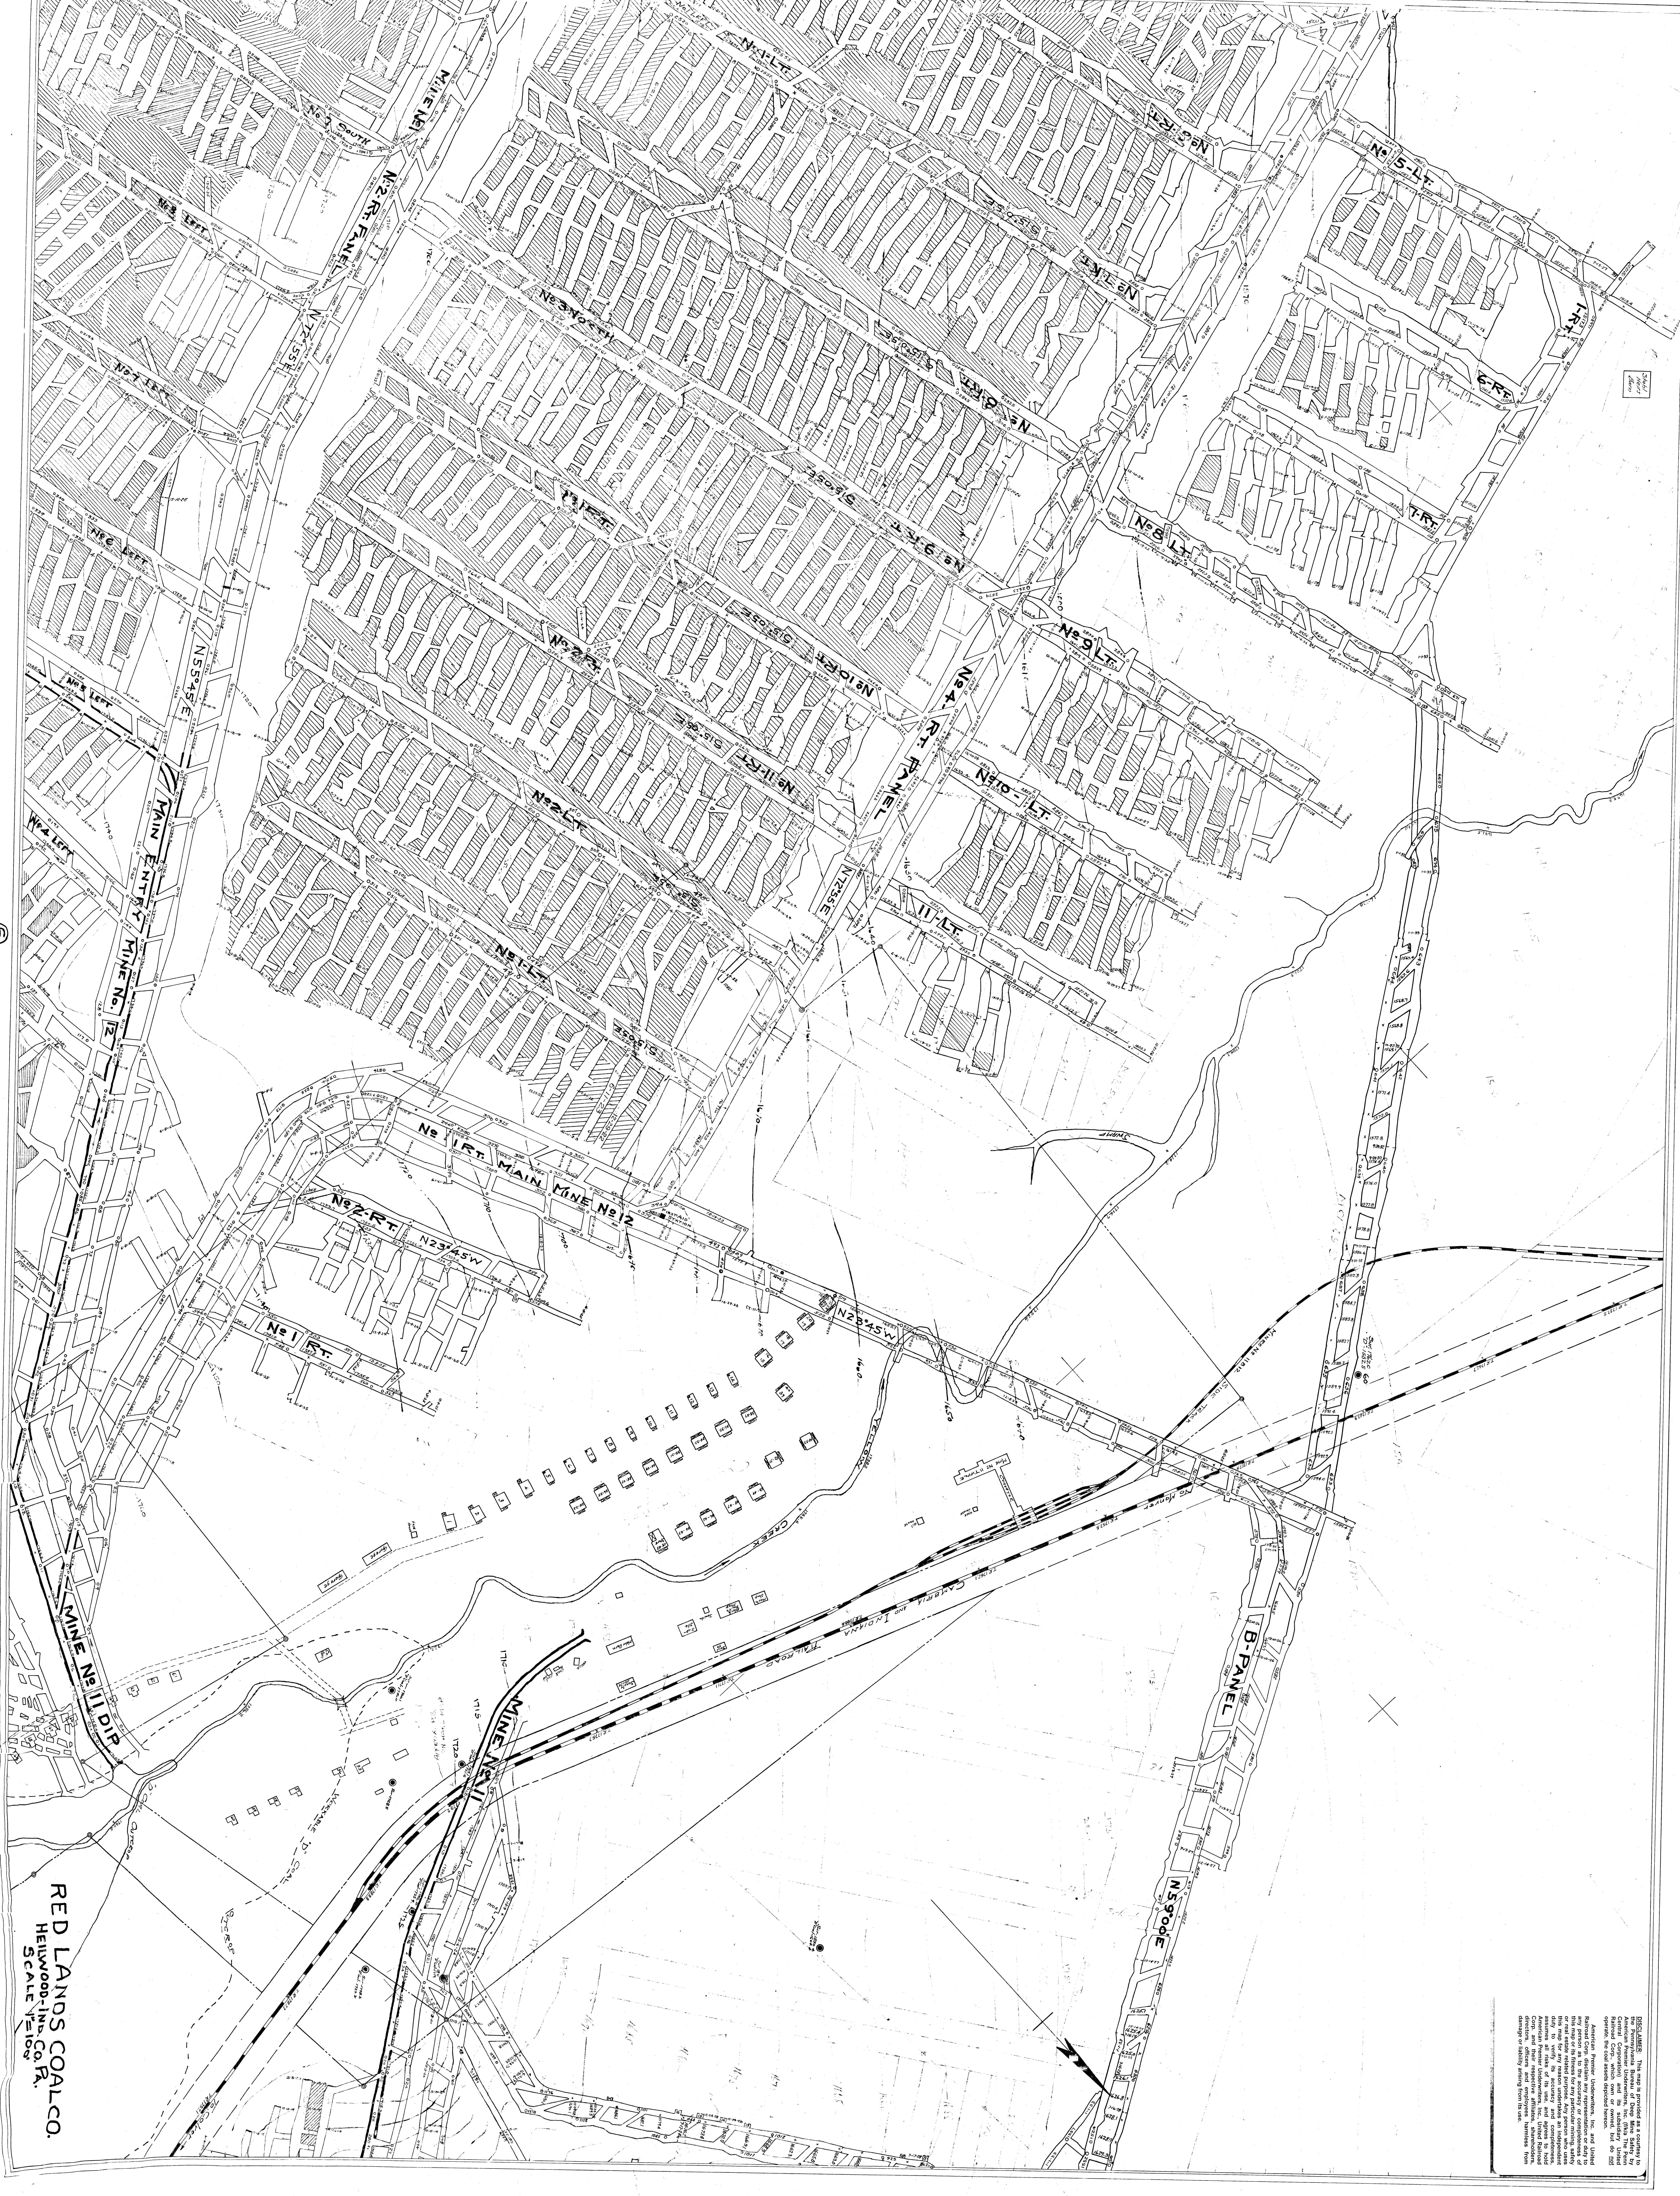
Mine No 1
No 7 South
No 2 Rt. Panel
N72°55'E
No 8 Left
No 7 Left
No 6 Left
No 5 Left
No 4 Left
N55°45'E
Main Entry Mine No. 12
No 1 Lt.
No 3 North
No 2 Rt.
No 3 Rt.
No 10 Rt.
No 11 Rt.
No 9 Rt.
No 8 Rt.
No 7 Rt.
No 6 Rt.
No 5 Lt.
1 Rt.
6 Rt.
7 Rt.
No 8 Lt.
No 9 Lt.
No 10 Lt.
11 Lt.
No 4 Rt. Panel
N72°55'E
No 2 Lt.
No 1 Lt.
S15°05'E
No 1 Rt. Main Mine No 12
First Aid Station
No 2 Rt.
N23°45'W
No 1 Rt.
N23°45'W
Yellow Creek
Swamp
Side Track Mines No 11 & 12
Mine No 11 Tipple
To Manver
Cambria and Indiana Railroad
Garage
Garage
Oil House
Mach Shop
Black Smith Shop
Supply House
Office
Mine No 11 Dip
Mine No 11
Workable "D" Coal
"D" Coal Outcrop
Outcrop
To Colver
B-Panel
N59°00'E
Stable Hens Barn

# RED LANDS COAL CO.
HEILWOOD-IND. CO. PA.
SCALE 1"=100'

⑥

Fit to 5

Fit to 32

Fit to 3

DISCLAIMER: This map is provided as a courtesy to the Pennsylvania Bureau of Deep Mine Safety by American Premier Underwriters, Inc. (f/k/a The Penn Central Corporation) and its subsidiary United Railroad Corp., which own or owned, but do not operate, the coal assets depicted hereon.

American Premier Underwriters, Inc. and United Railroad Corp. disclaim any representation or duty to any person as to the accuracy or completeness of this map or its fitness for any particular mining, safety or real estate related purpose. Any person who uses this map for any reason undertakes an independent duty to verify its accuracy and completeness, assumes all risks of its use, and agrees to hold American Premier Underwriters, Inc., United Railroad Corp. and their respective affiliates, shareholders, directors, officers and employees harmless from damage or liability arising from its use.