
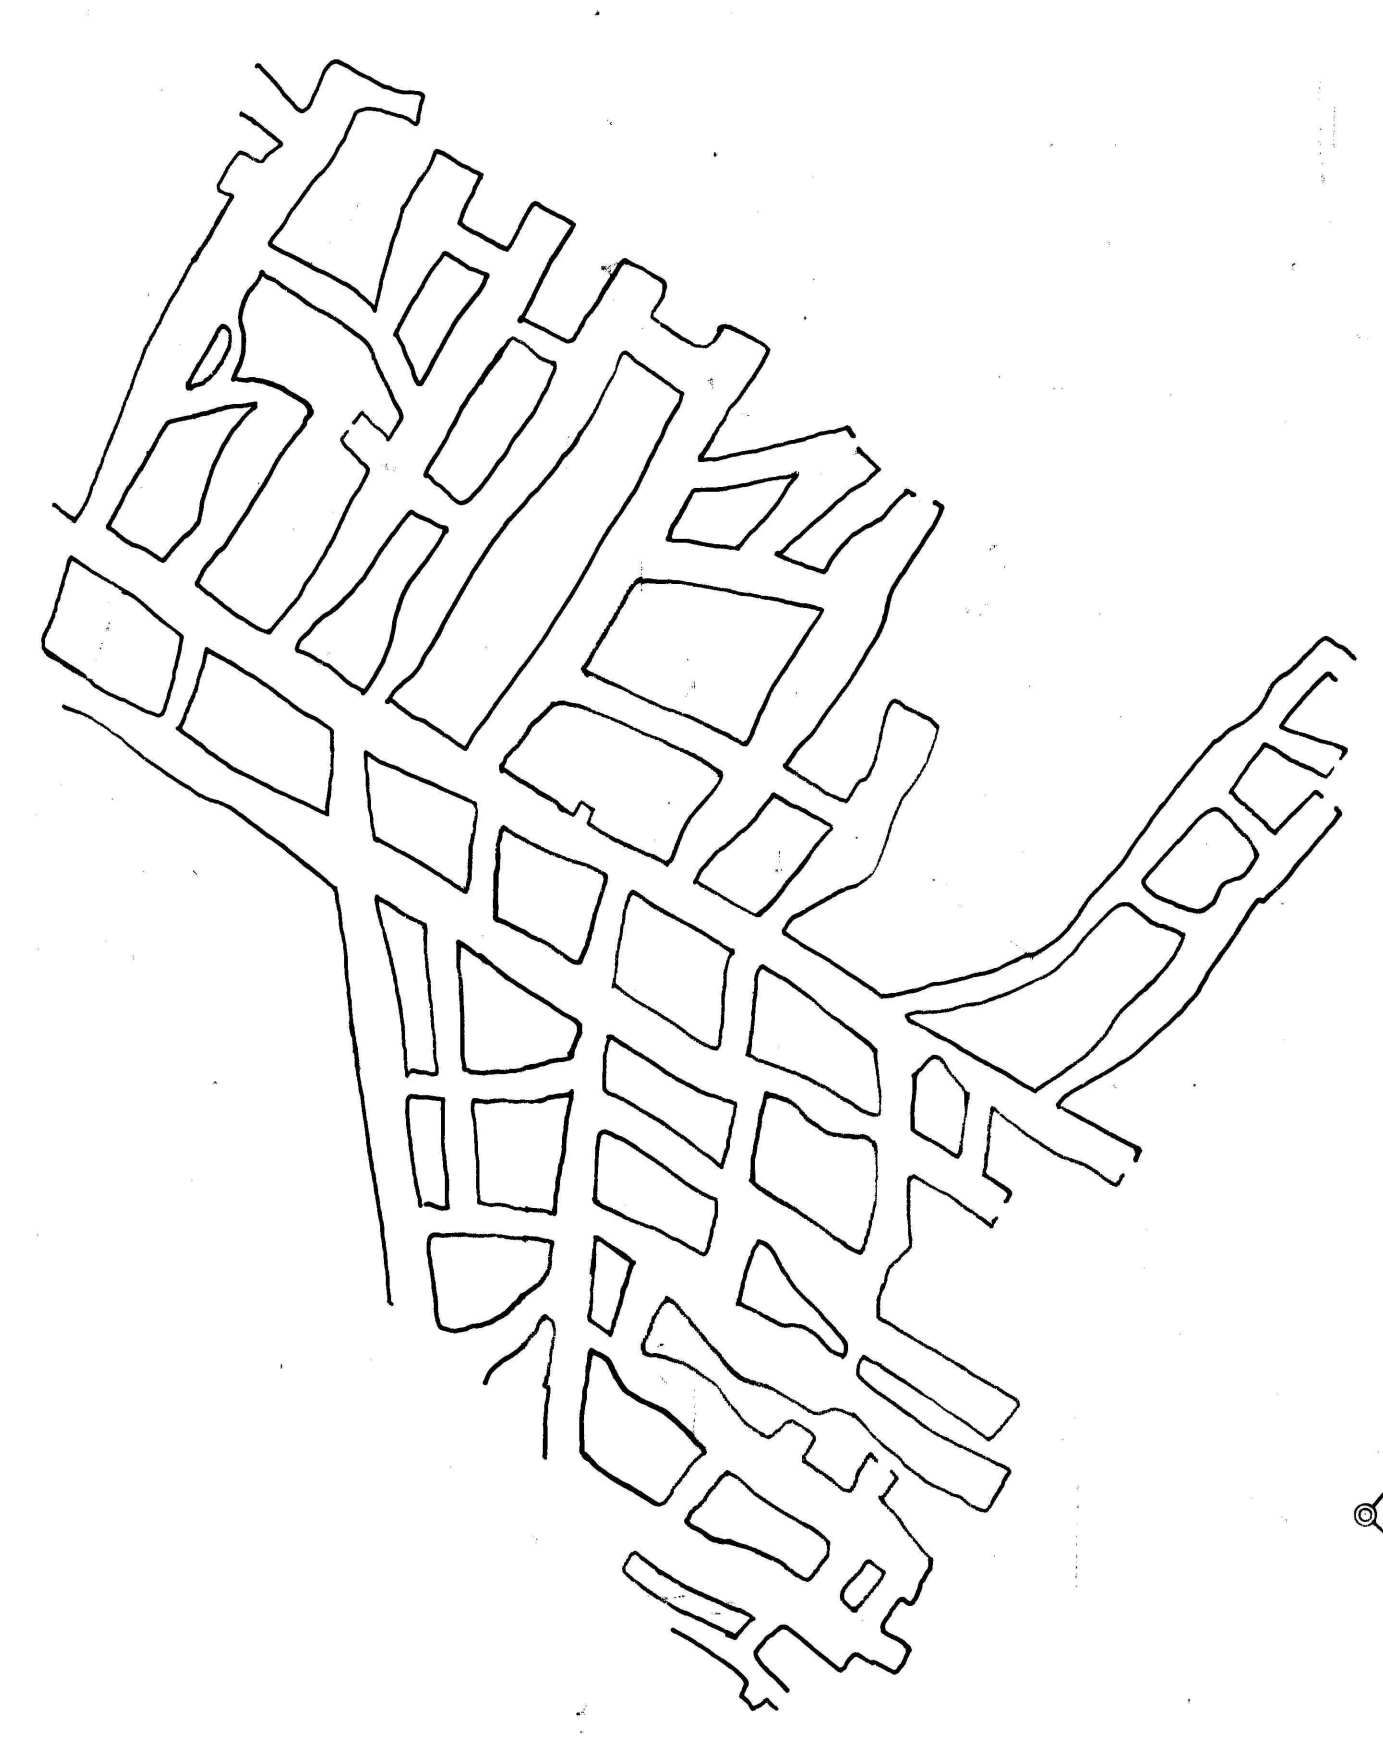


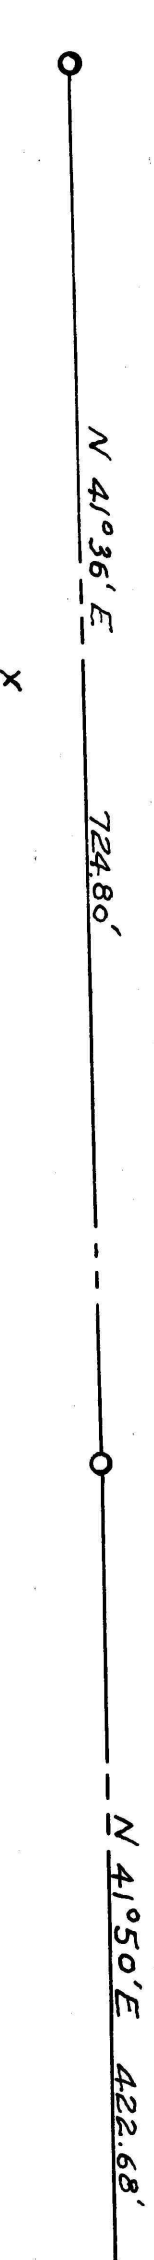

D. D. Hole © 166
Sur: 1802.4
D. Coal: 1598.6

DISCLAIMER: This mail is provided as a courtesy to the Pennsylvania Bureau of Deep Mine Safety by the American Railroad Corporation and its subsidiary United Railroad Corp., which own or owned, but do not operate, the coal assets depicted herein.

American Pennant Underwriters, Inc. and United Railroad Corp. disclaim any representation or duty to any person or entity for any particular mining, safety or real estate related purposes. Any person who uses this mail for any reason understands the disclaimer, assumes all risks of its use, and agrees to hold American Pennant Underwriters, Inc., United Railroad Corp. and their respective subsidiaries harmless from damage or liability arising from its use.