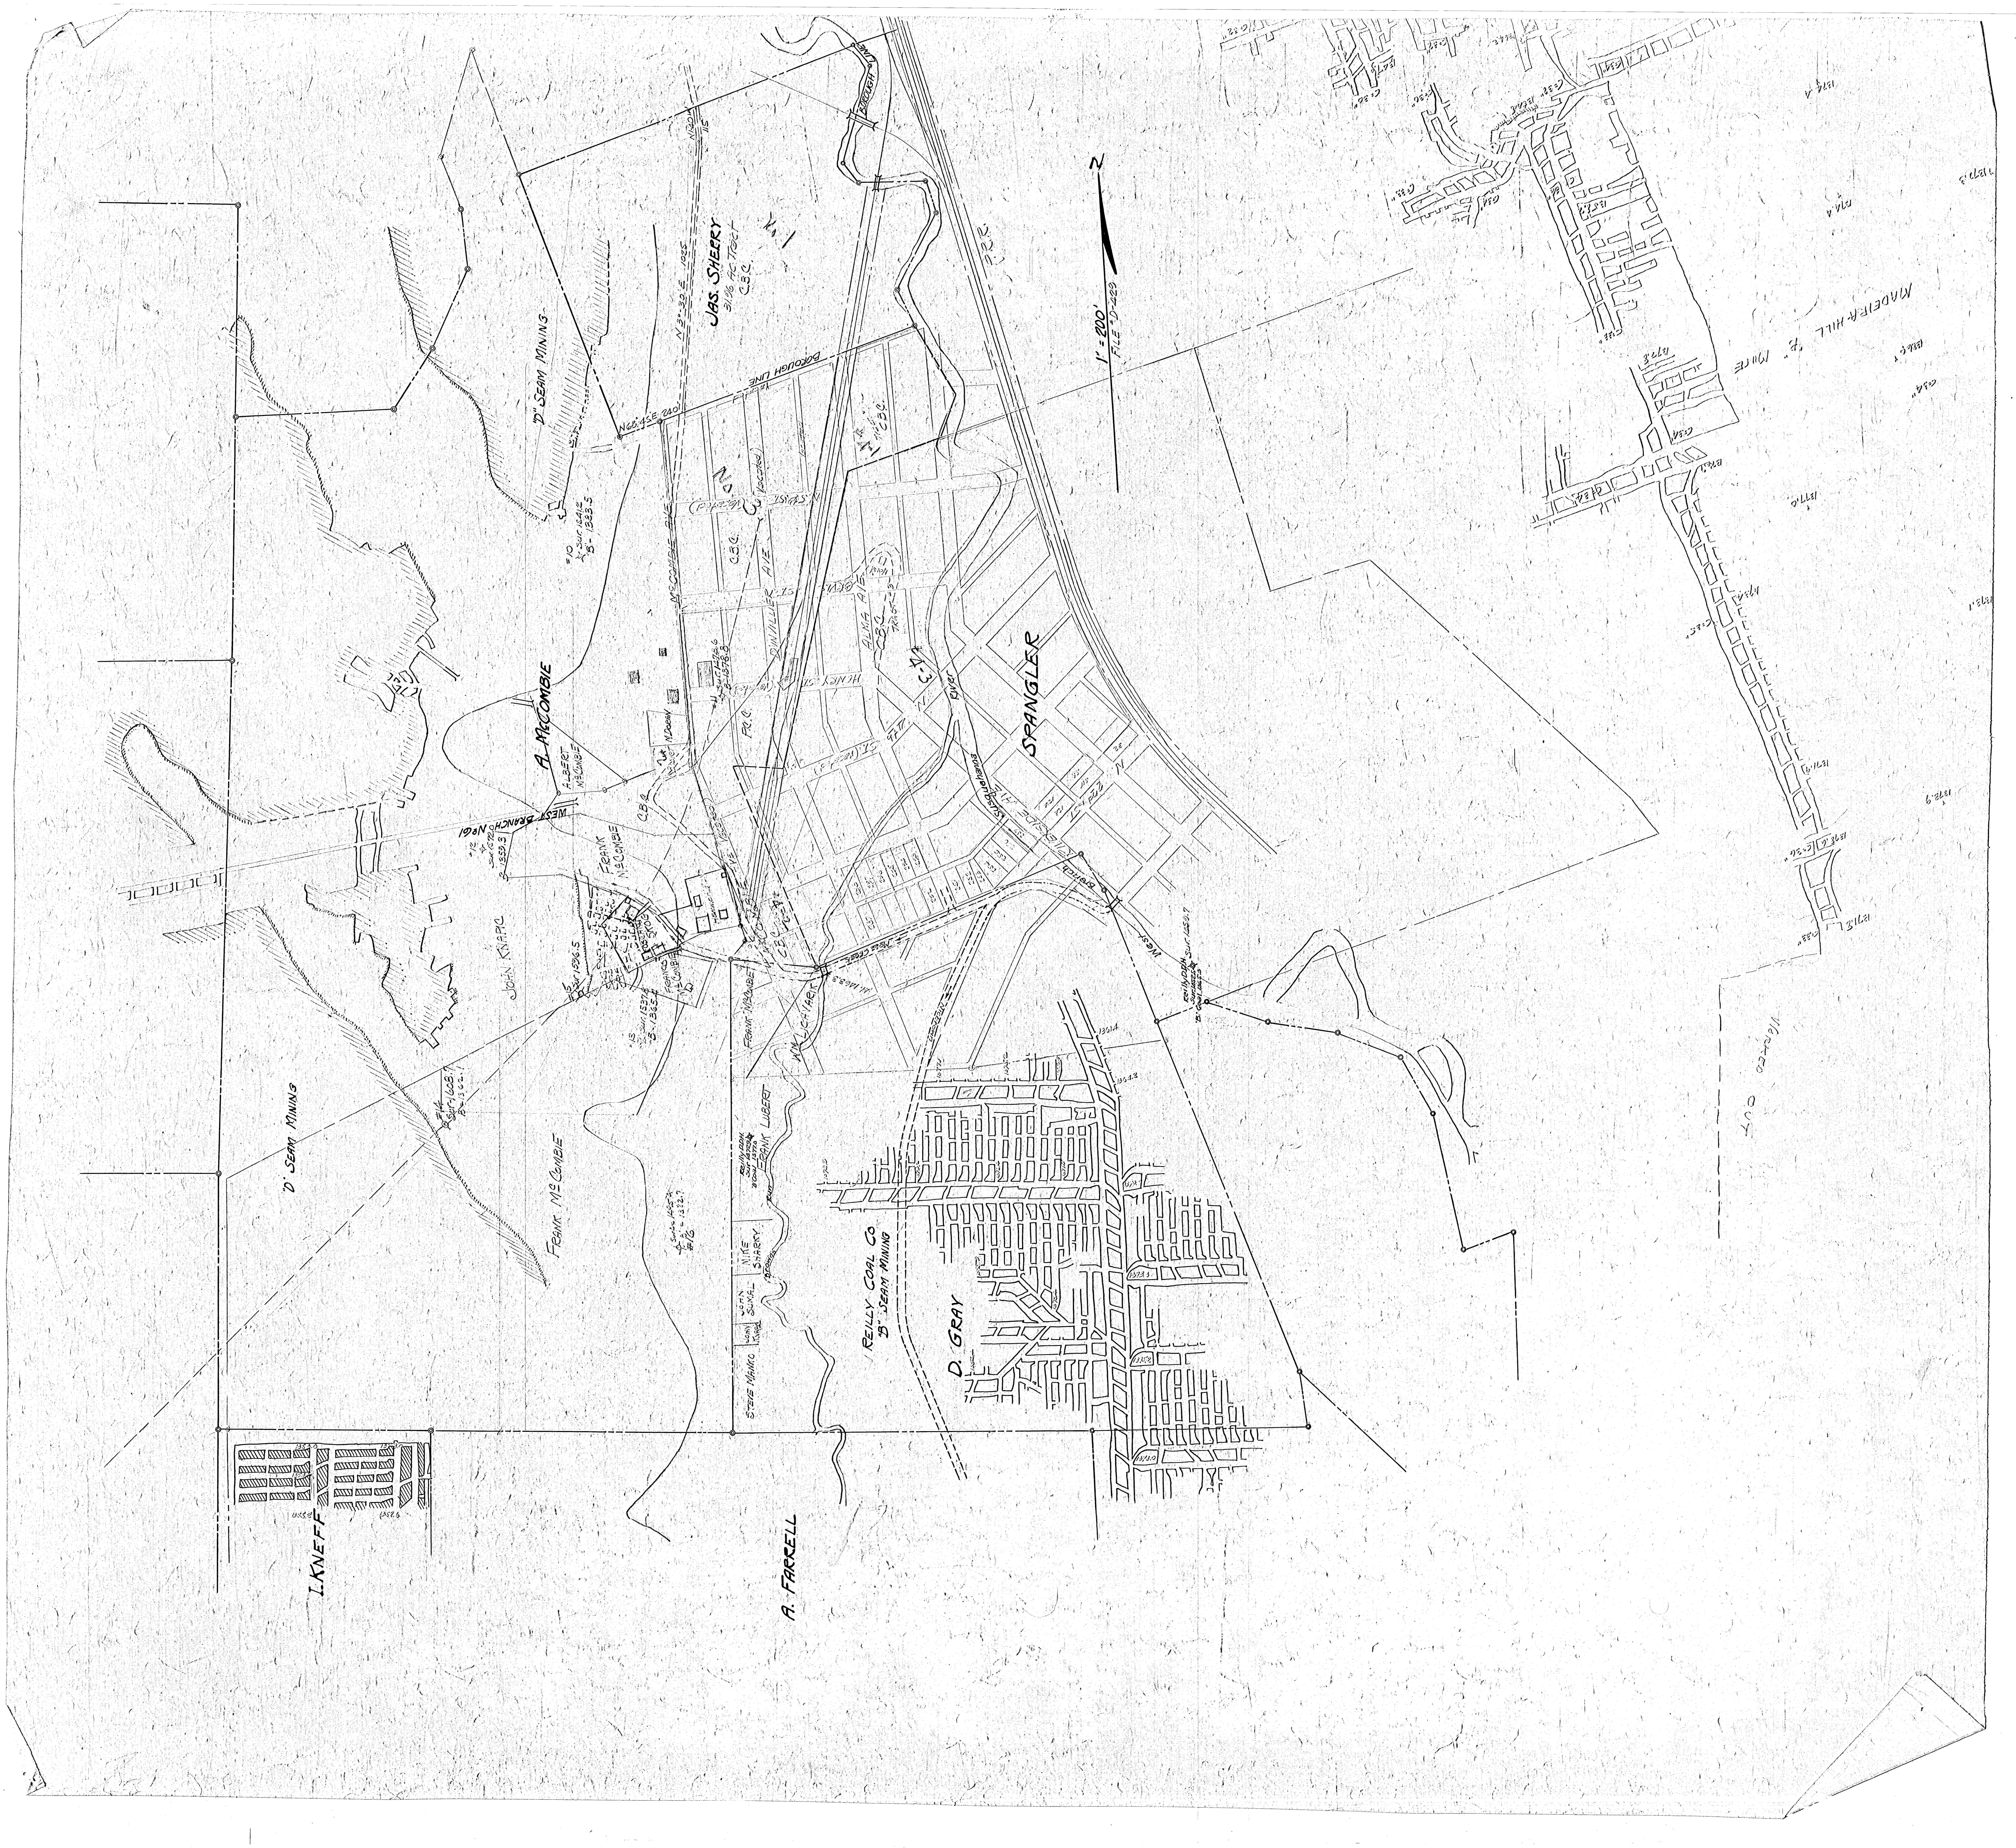
JAS. SHERRY
31.96 Ac. Tract
C.B.C.
N 3°-30' E 1025
N 20' 115
N 68°4' S E 240'
BOROUGH LINE
"D" SEAM MINING
#10 Sur. 1541.2 'B'-1383.5
A. McCOMBIE
ALBERT McCOMBIE
WEST BRANCH No 61
#12 Sur. 1570 1359.3
FRANK McCOMBIE
JOHN KNAPP
#15 Sur. 1596.5
FRANCIS McCOMBIE
#13 Sur. 1537.6 B-1365.4
#14 Sur. 1608.1 B-1362.1
'D' SEAM MINING
FRANK McCOMBIE
#16 Sur. 1405.4 'B'-1382.7
I. KNEFF
1353.0
1352.2
1352.6
McCOMBIE AVE
No 3
C.B.C.
DINWILLER AVE
HENRY ST
ALMA AVE
C.B.C.
C-3
C-4
P.R.C.
SPANGLER
RIVERSIDE AVE
Susquehanna River
West Branch
Moss Creek
P.R.R.
N
1" = 200'
FILE #D-409
FRANK McCOMBIE
WM. LICHVARIK
Reilly DDH Sur. 1472.9 B Coal 1377.0
FRANK LUBERT
MIKE SHARKY
JOHN SUMAL
JOHN KNAPP
STEVE MANKO
REILLY COAL CO
'B' SEAM MINING
D. GRAY
Reilly DDH Sur. 1459.7 'B' Coal 1363.3
1361.4
1364.2
1373.3
1373.2
1373.0
A. FARRELL