


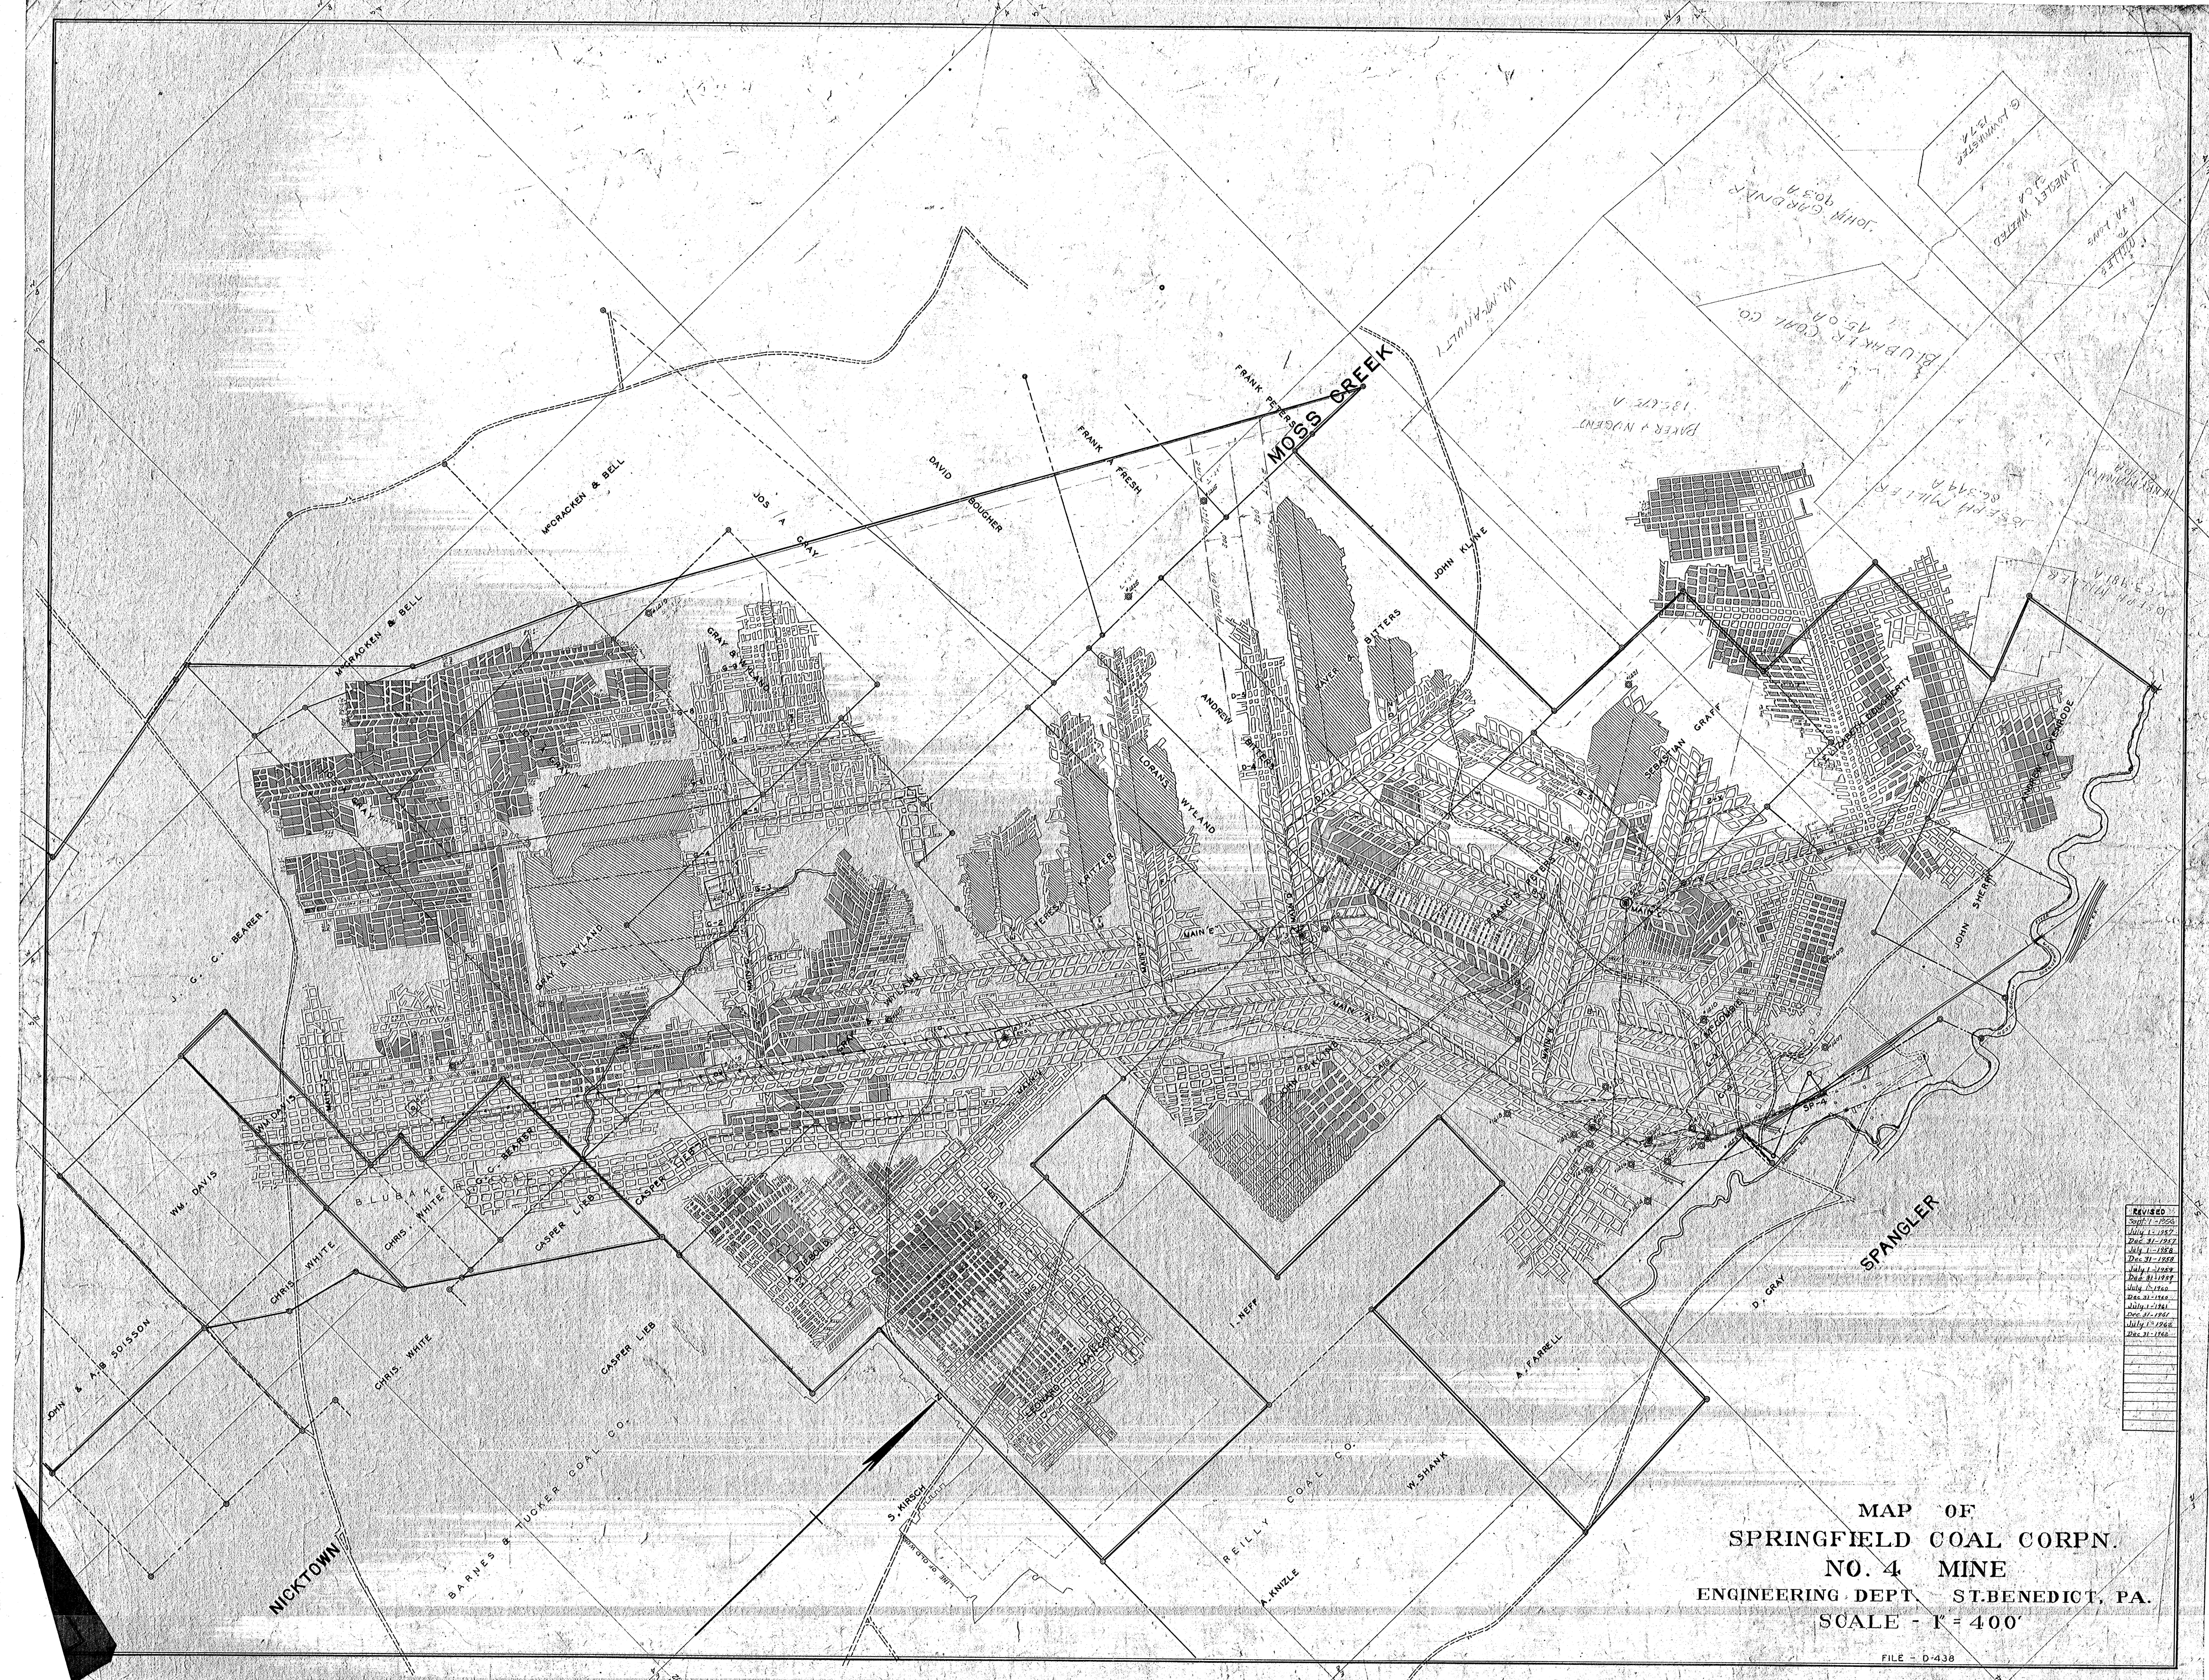

REVISED

MAP OF
SPRINGFIELD COAL CORPN.
NO. 4 MINE
ENGINEERING DEPT. ST. BENEDICT, PA.
SCALE - 1" = 400'