


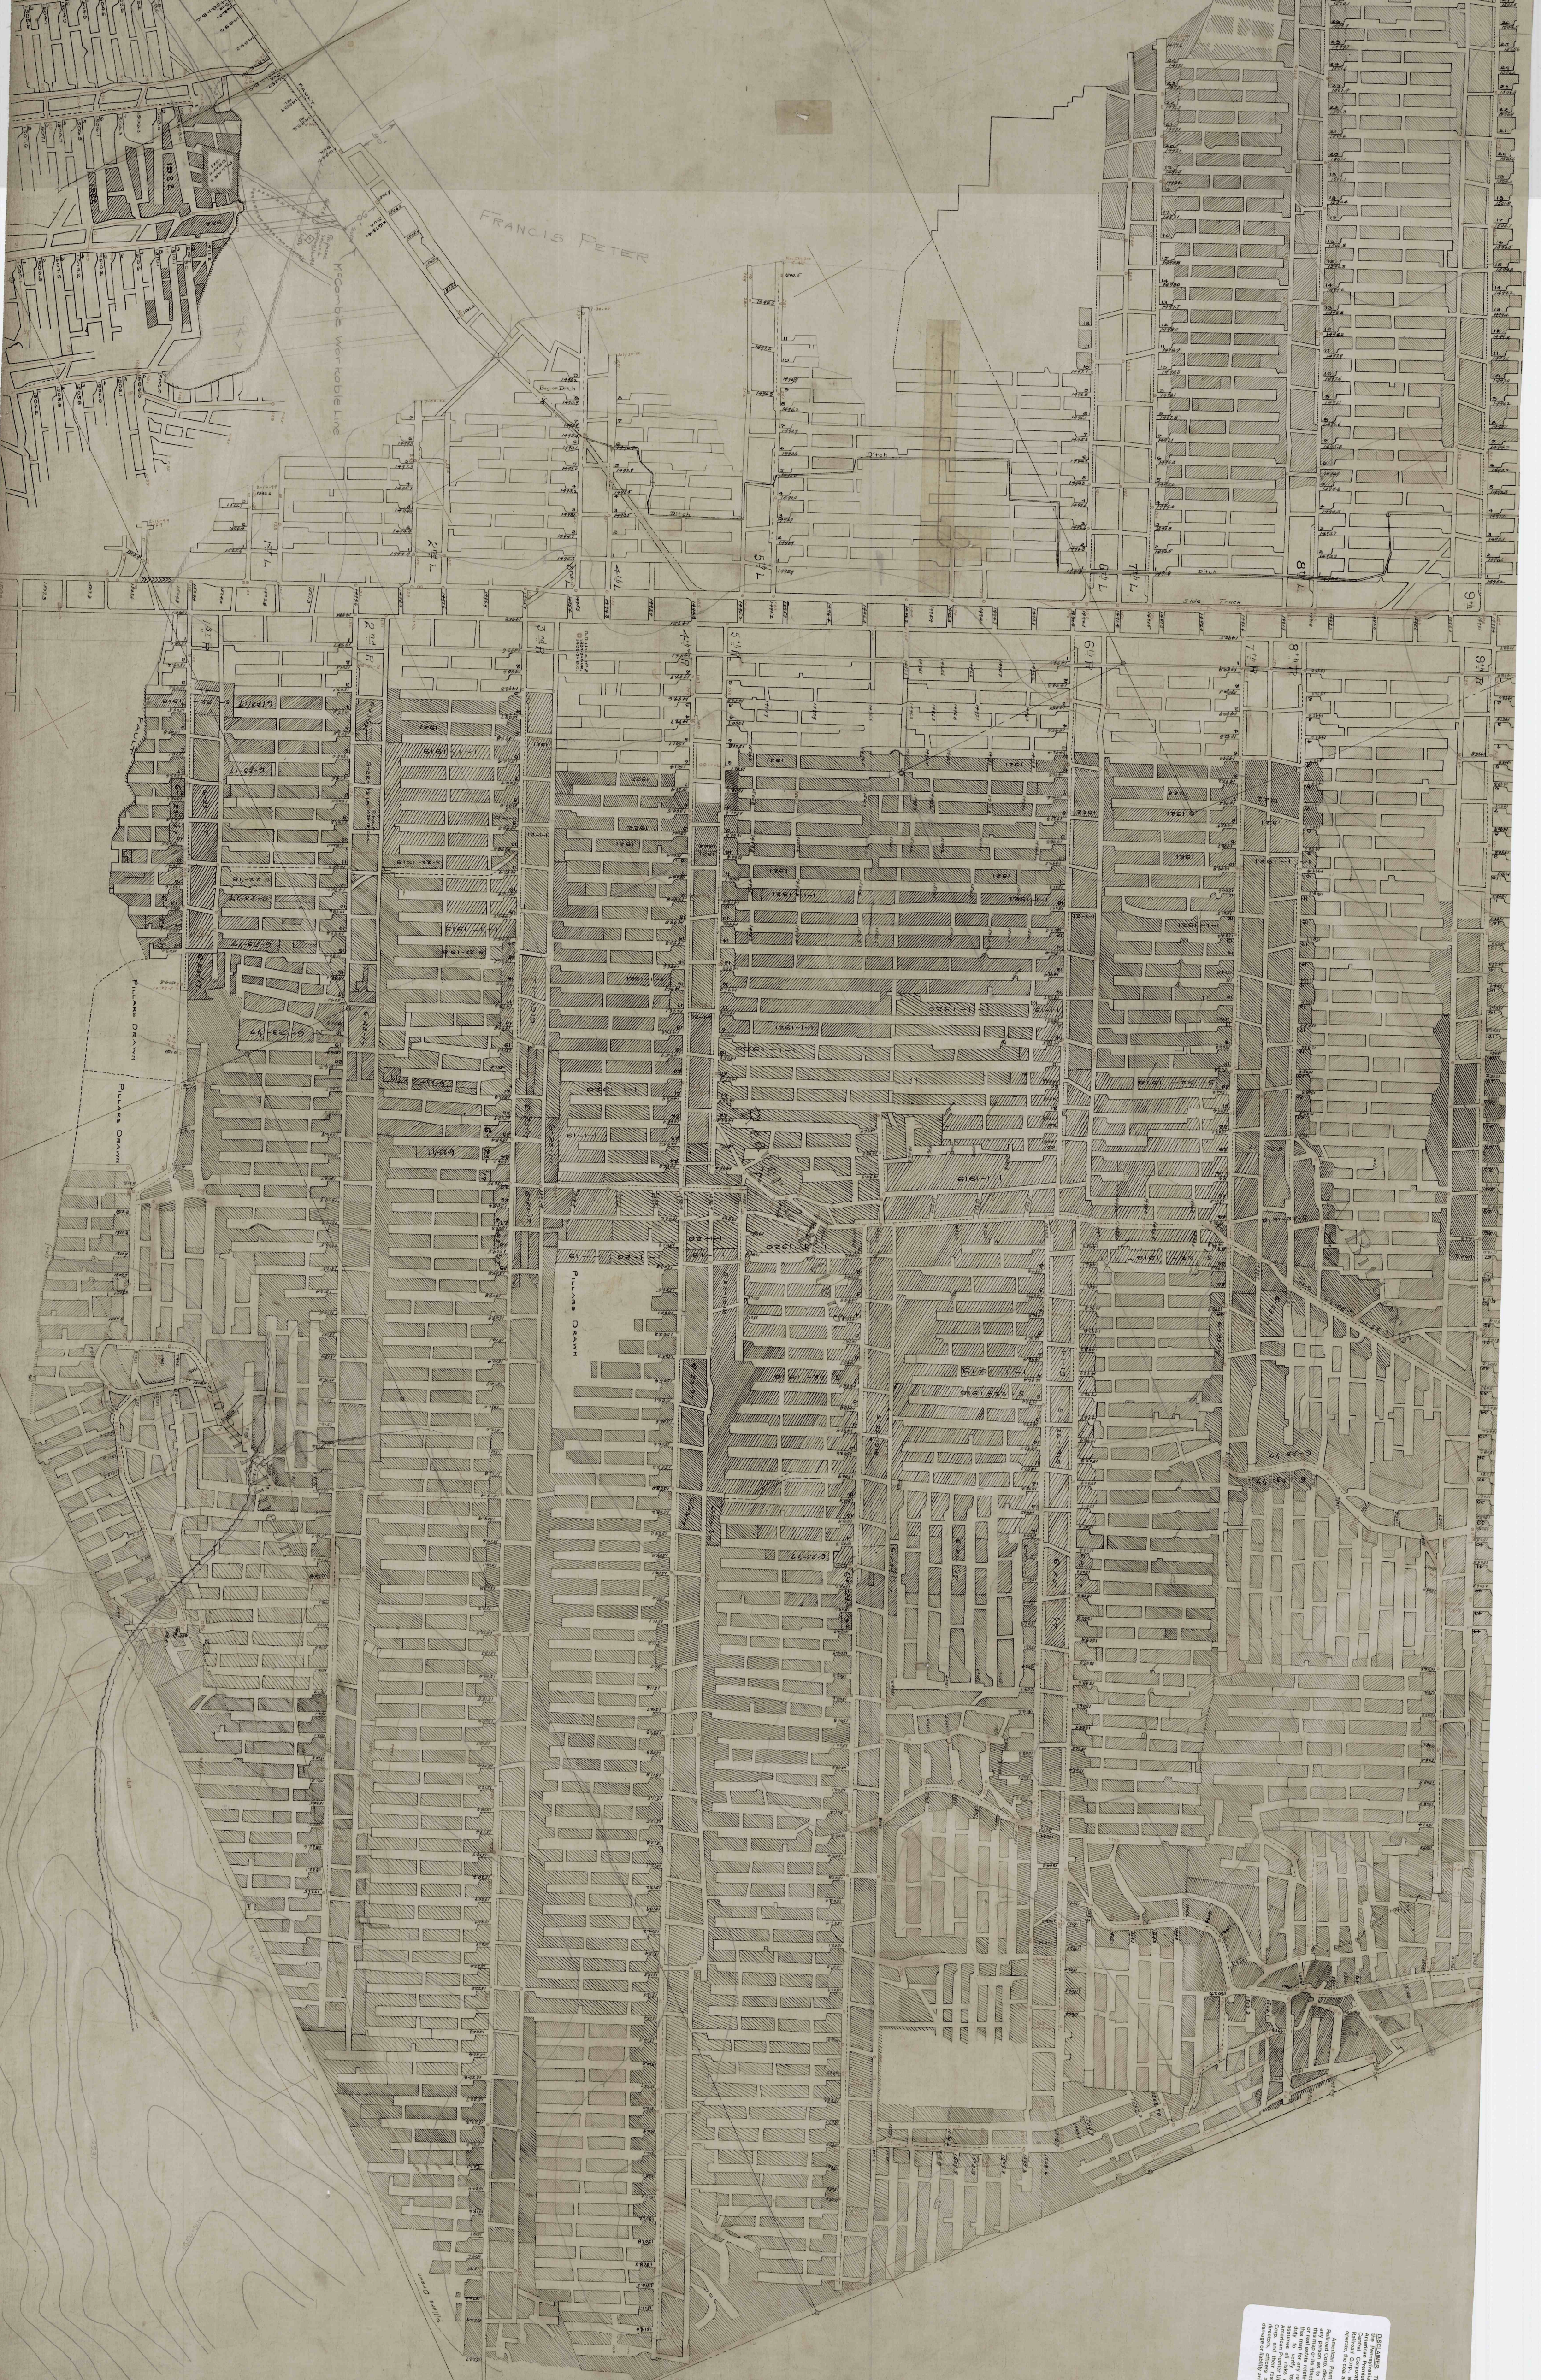

6-500 ACRES, LEASED TO THE WASH. & SOUTHERN A.L.S. CO. JUNE - 1914