


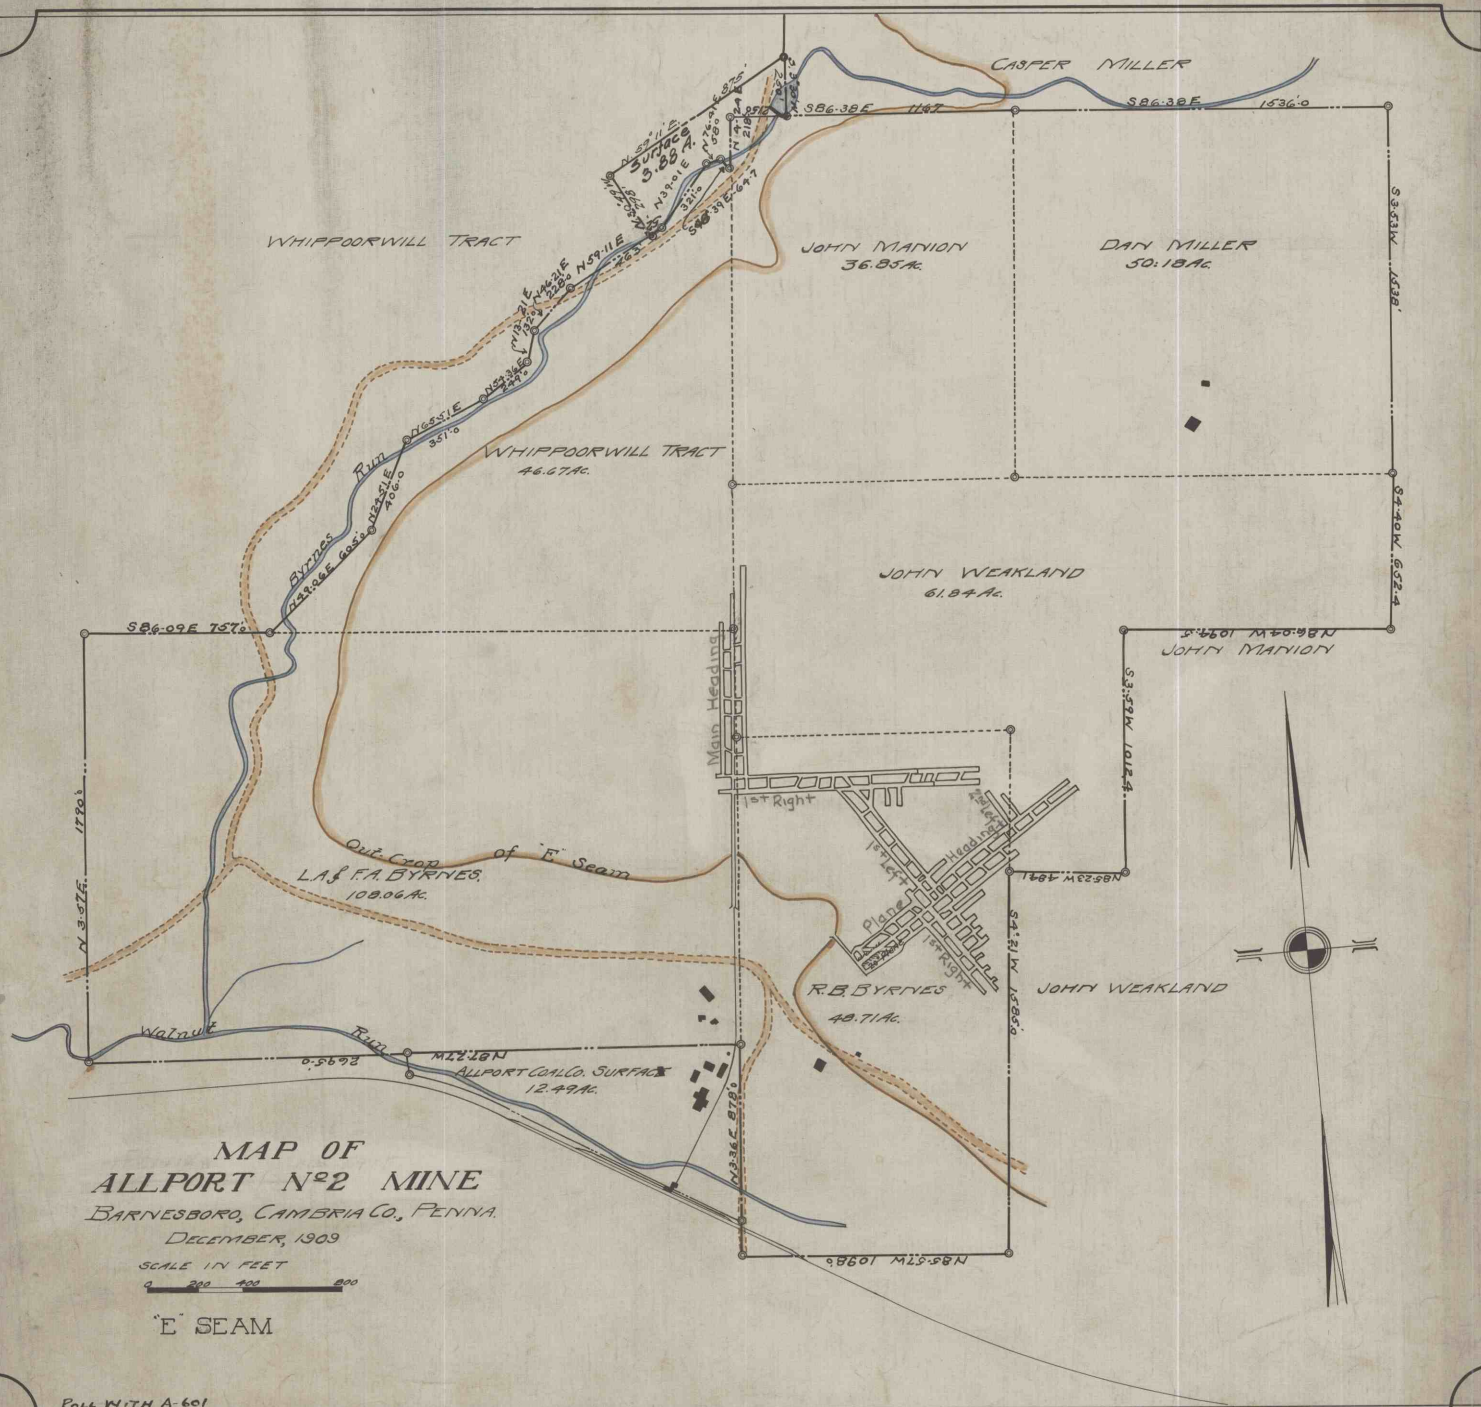

D-215