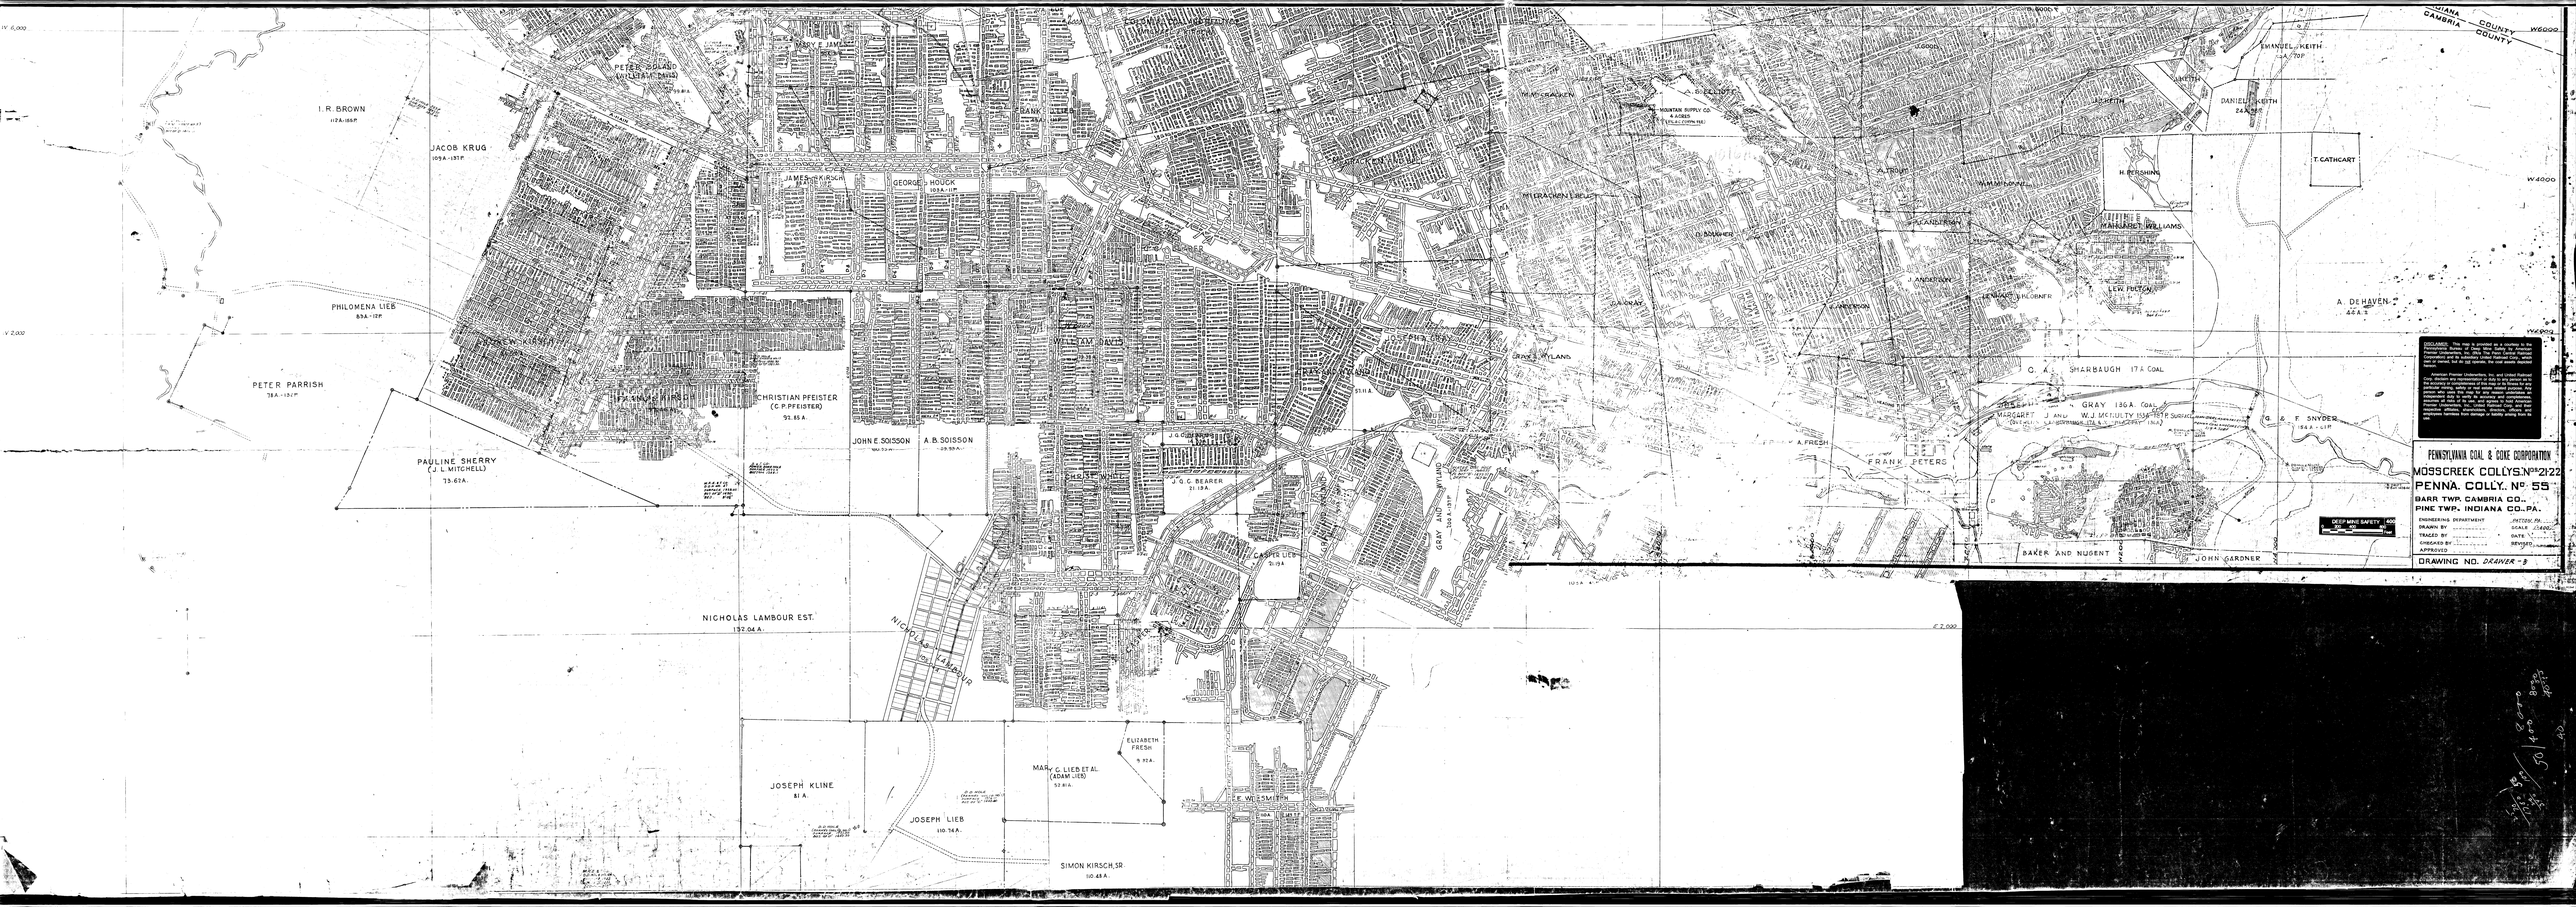

PETER PARRISH 78A.-131P.
PHILOMENA LIEB 83A.-131P.
I. R. BROWN
JACOB KRUG
PAULINE SHERRY (C. L. MITCHELL) 73.67A.
NICHOLAS LAMBOUR EST.
JOSEPH KLINE 81A.
CHRISTIAN PFEISTER (C. PFEISTER) 91.8A.
JOHN E. SOSSON
A. B. SOSSON
JOSEPH LIEB 110.14A.
MARY G. LIEB ET AL (ADAM LIEB) 52.9A.
SIMON KIRSCH, SR. 10.4A.
ELIZABETH FRESH
GEORGE HOUCK
GRAY AND WYLAND 200 A.-131P.
A. FRESH
BAKER AND NUGENT
JOHN GARDNER
G. A. SHARBAUGH 17A. COAL
GRAY 136A. COAL
W. J. MCNULTY
& F. SNYDER 154 A.-61P.
DD HOLE NO.192 SURF. EL. 1180.63 BOT. 'B' 1433.93
'B' DRIFT 'B' BOT. 1458.46
A. DEHAVEN 44A.±
T. CATHCART
DANIEL KEITH
EMANUEL KEITH
INDIANA COUNTY
CAMBRIA COUNTY
N4200
E2000
W2000
W4000
W6000
DEEP MINE SAFETY
400
0 200 400 600 Feet

DISCLAIMER: This map is provided as a courtesy to the Pennsylvania Bureau of Deep Mine Safety by American Premier Underwriters, Inc. (f/k/a The Penn Central Railroad Corporation) and its subsidiary United Railroad Corp., which own or owned, but do not operate, the coal assets depicted hereon.

American Premier Underwriters, Inc. and United Railroad Corp. disclaim any representation or duty to any person as to the accuracy or completeness of this map or its fitness for any particular mining, safety or real estate related purpose. Any person who uses this map for any reason undertakes an independent duty to verify its accuracy and completeness, assumes all risks of its use, and agrees to hold American Premier Underwriters, Inc., United Railroad Corp. and their respective affiliates, shareholders, directors, officers and employees harmless from damage or liability arising from its use.

PENNSYLVANIA COAL & COKE CORPORATION

MOSSCREEK COLLY'S. N^OS. 21-22
PENNA. COLL'Y. N^O. 55
BARR TWP. CAMBRIA CO.
PINE TWP. INDIANA CO., PA.

ENGINEERING DEPARTMENT — PATTON, PA.
DRAWN BY — SCALE 1"=400'
TRACED BY — DATE
CHECKED BY — REVISED
APPROVED

DRAWING NO. DRAWER-3

50/400
8000
40