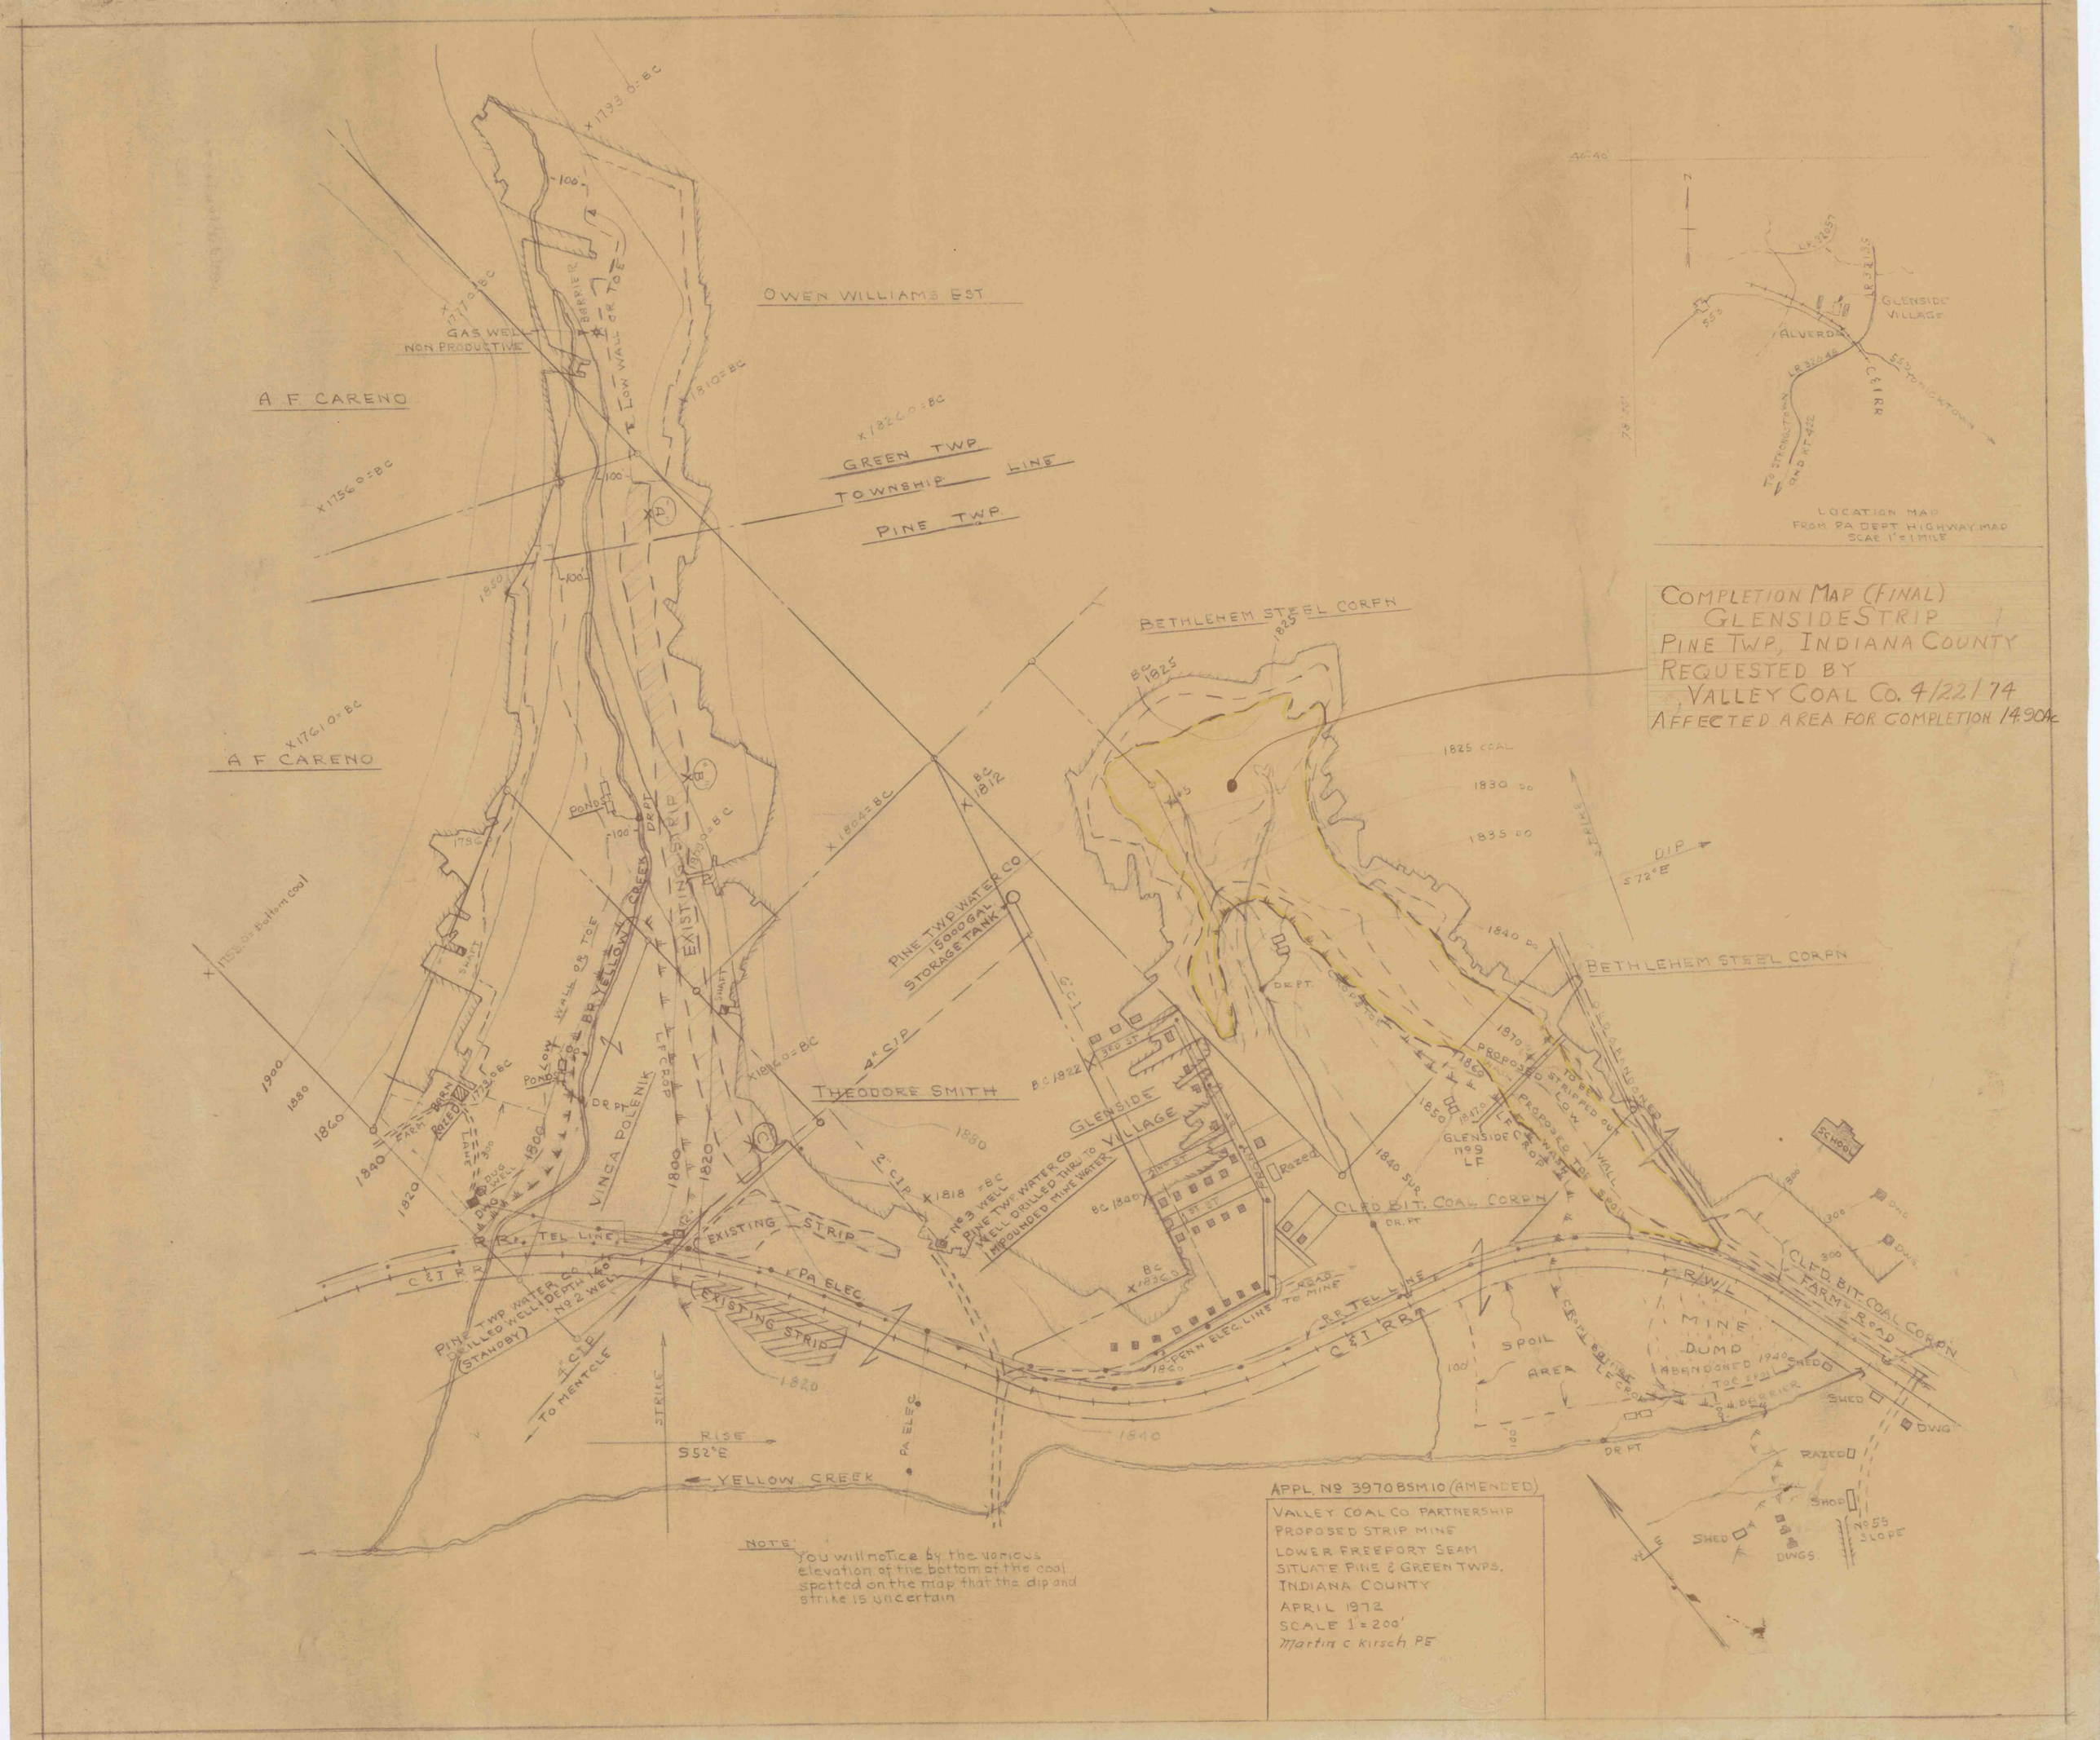
OWEN WILLIAMS EST
A F CARENO
GAS WELL NON PRODUCTIVE
BARRIER
LOW WALL OR TOE
GREEN TWP
TOWNSHIP LINE
PINE TWP
BETHLEHEM STEEL CORPN
1825 COAL
1830 DO
1835 DO
1840 DO
STRIKE
DIP
S72°E
PINE TWP WATER CO 15000 GAL STORAGE TANK
THEODORE SMITH
GLENSIDE VILLAGE
PINE TWP WATER CO WELL DRILLED THRU TO IMPOUNDED MINE WATER
No 3 WELL
CLFD BIT. COAL CORPN
PROPOSED STRIPPED OUT LOW WALL
SCHOOL
EXISTING STRIP
PA ELEC
R.R. TEL LINE
C&I RR
PINE TWP WATER CO DRILLED WELL DEPTH 140' No 2 WELL (STANDBY)
TO MENTCLE
VINCA POLENIK
BR YELLOW CREEK
YELLOW CREEK
RISE
S52°E
PENN ELEC. LINE
ROAD TO MINE
SPOIL AREA
MINE DUMP ABANDONED 1940
CLFD BIT. COAL CORPN FARM ROAD
R/W L
No 55 SLOPE
DWGS.
SHED
RAZED
DR PT
NOTE: You will notice by the various elevation of the bottom of the coal spotted on the map that the dip and strike is uncertain
APPL. No 3970BSM10 (AMENDED)
VALLEY COAL CO. PARTNERSHIP
PROPOSED STRIP MINE
LOWER FREEPORT SEAM
SITUATE PINE & GREEN TWPS.
INDIANA COUNTY
APRIL 1972
SCALE 1" = 200'
Martin C Kirsch PE
LOCATION MAP
FROM PA DEPT HIGHWAY MAP
SCALE 1" = 1 MILE
GLENSIDE VILLAGE
ALVERDA
C&I RR
To STONYCREEK
To STONYTOWN
COMPLETION MAP (FINAL)
GLENSIDE STRIP
PINE TWP, INDIANA COUNTY
REQUESTED BY
VALLEY COAL CO. 4/22/74
AFFECTED AREA FOR COMPLETION 14.90Ac