


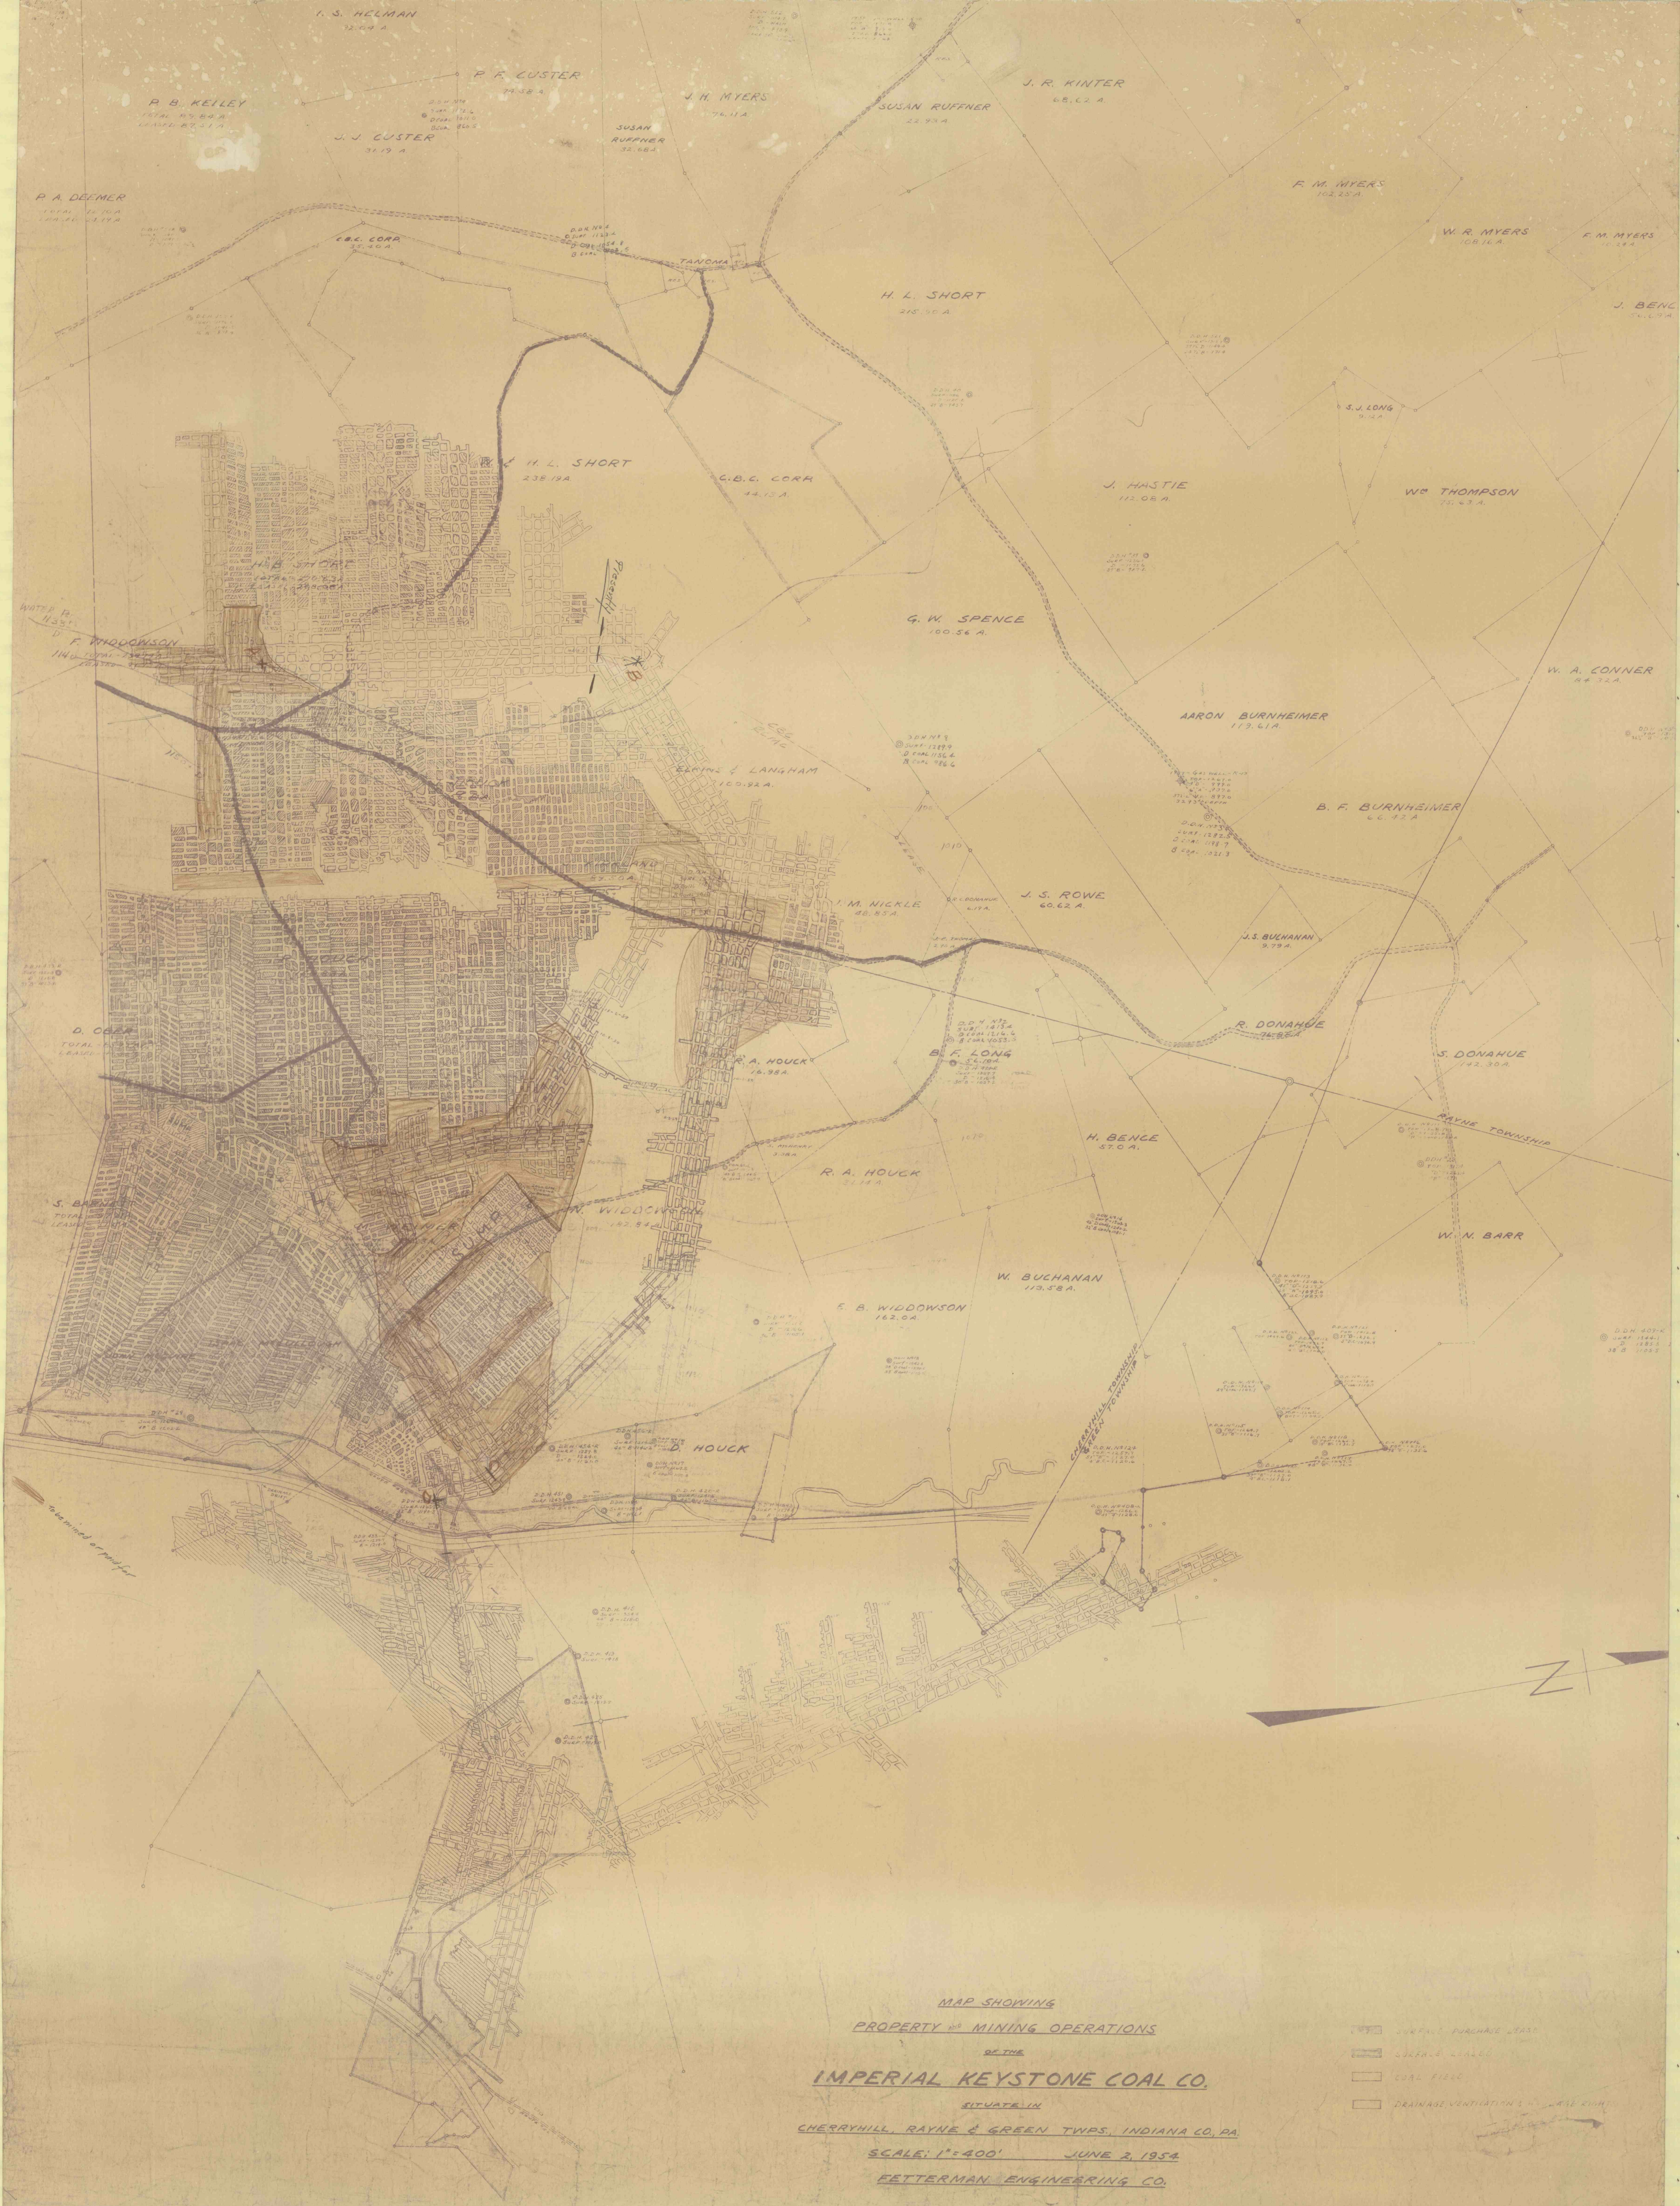

MAP SHOWING
PROPERTY AND MINING OPERATIONS
OF THE

IMPERIAL KEYSTONE COAL CO.
SITUATE IN

CHERRYHILL, RAYNE & GREEN TOWNSHIPS, INDIANA CO., PA.

SCALE: 1"=400' JUNE 2, 1954

FETTERMAN ENGINEERING CO.

- ✓ SURFACE PURCHASE LEASE
- ✓ QUARRY & WAREHOUSE
- ✓ COAL FIELD
- ✓ DRAINAGE VENTILATION & WASTE RIGHT