


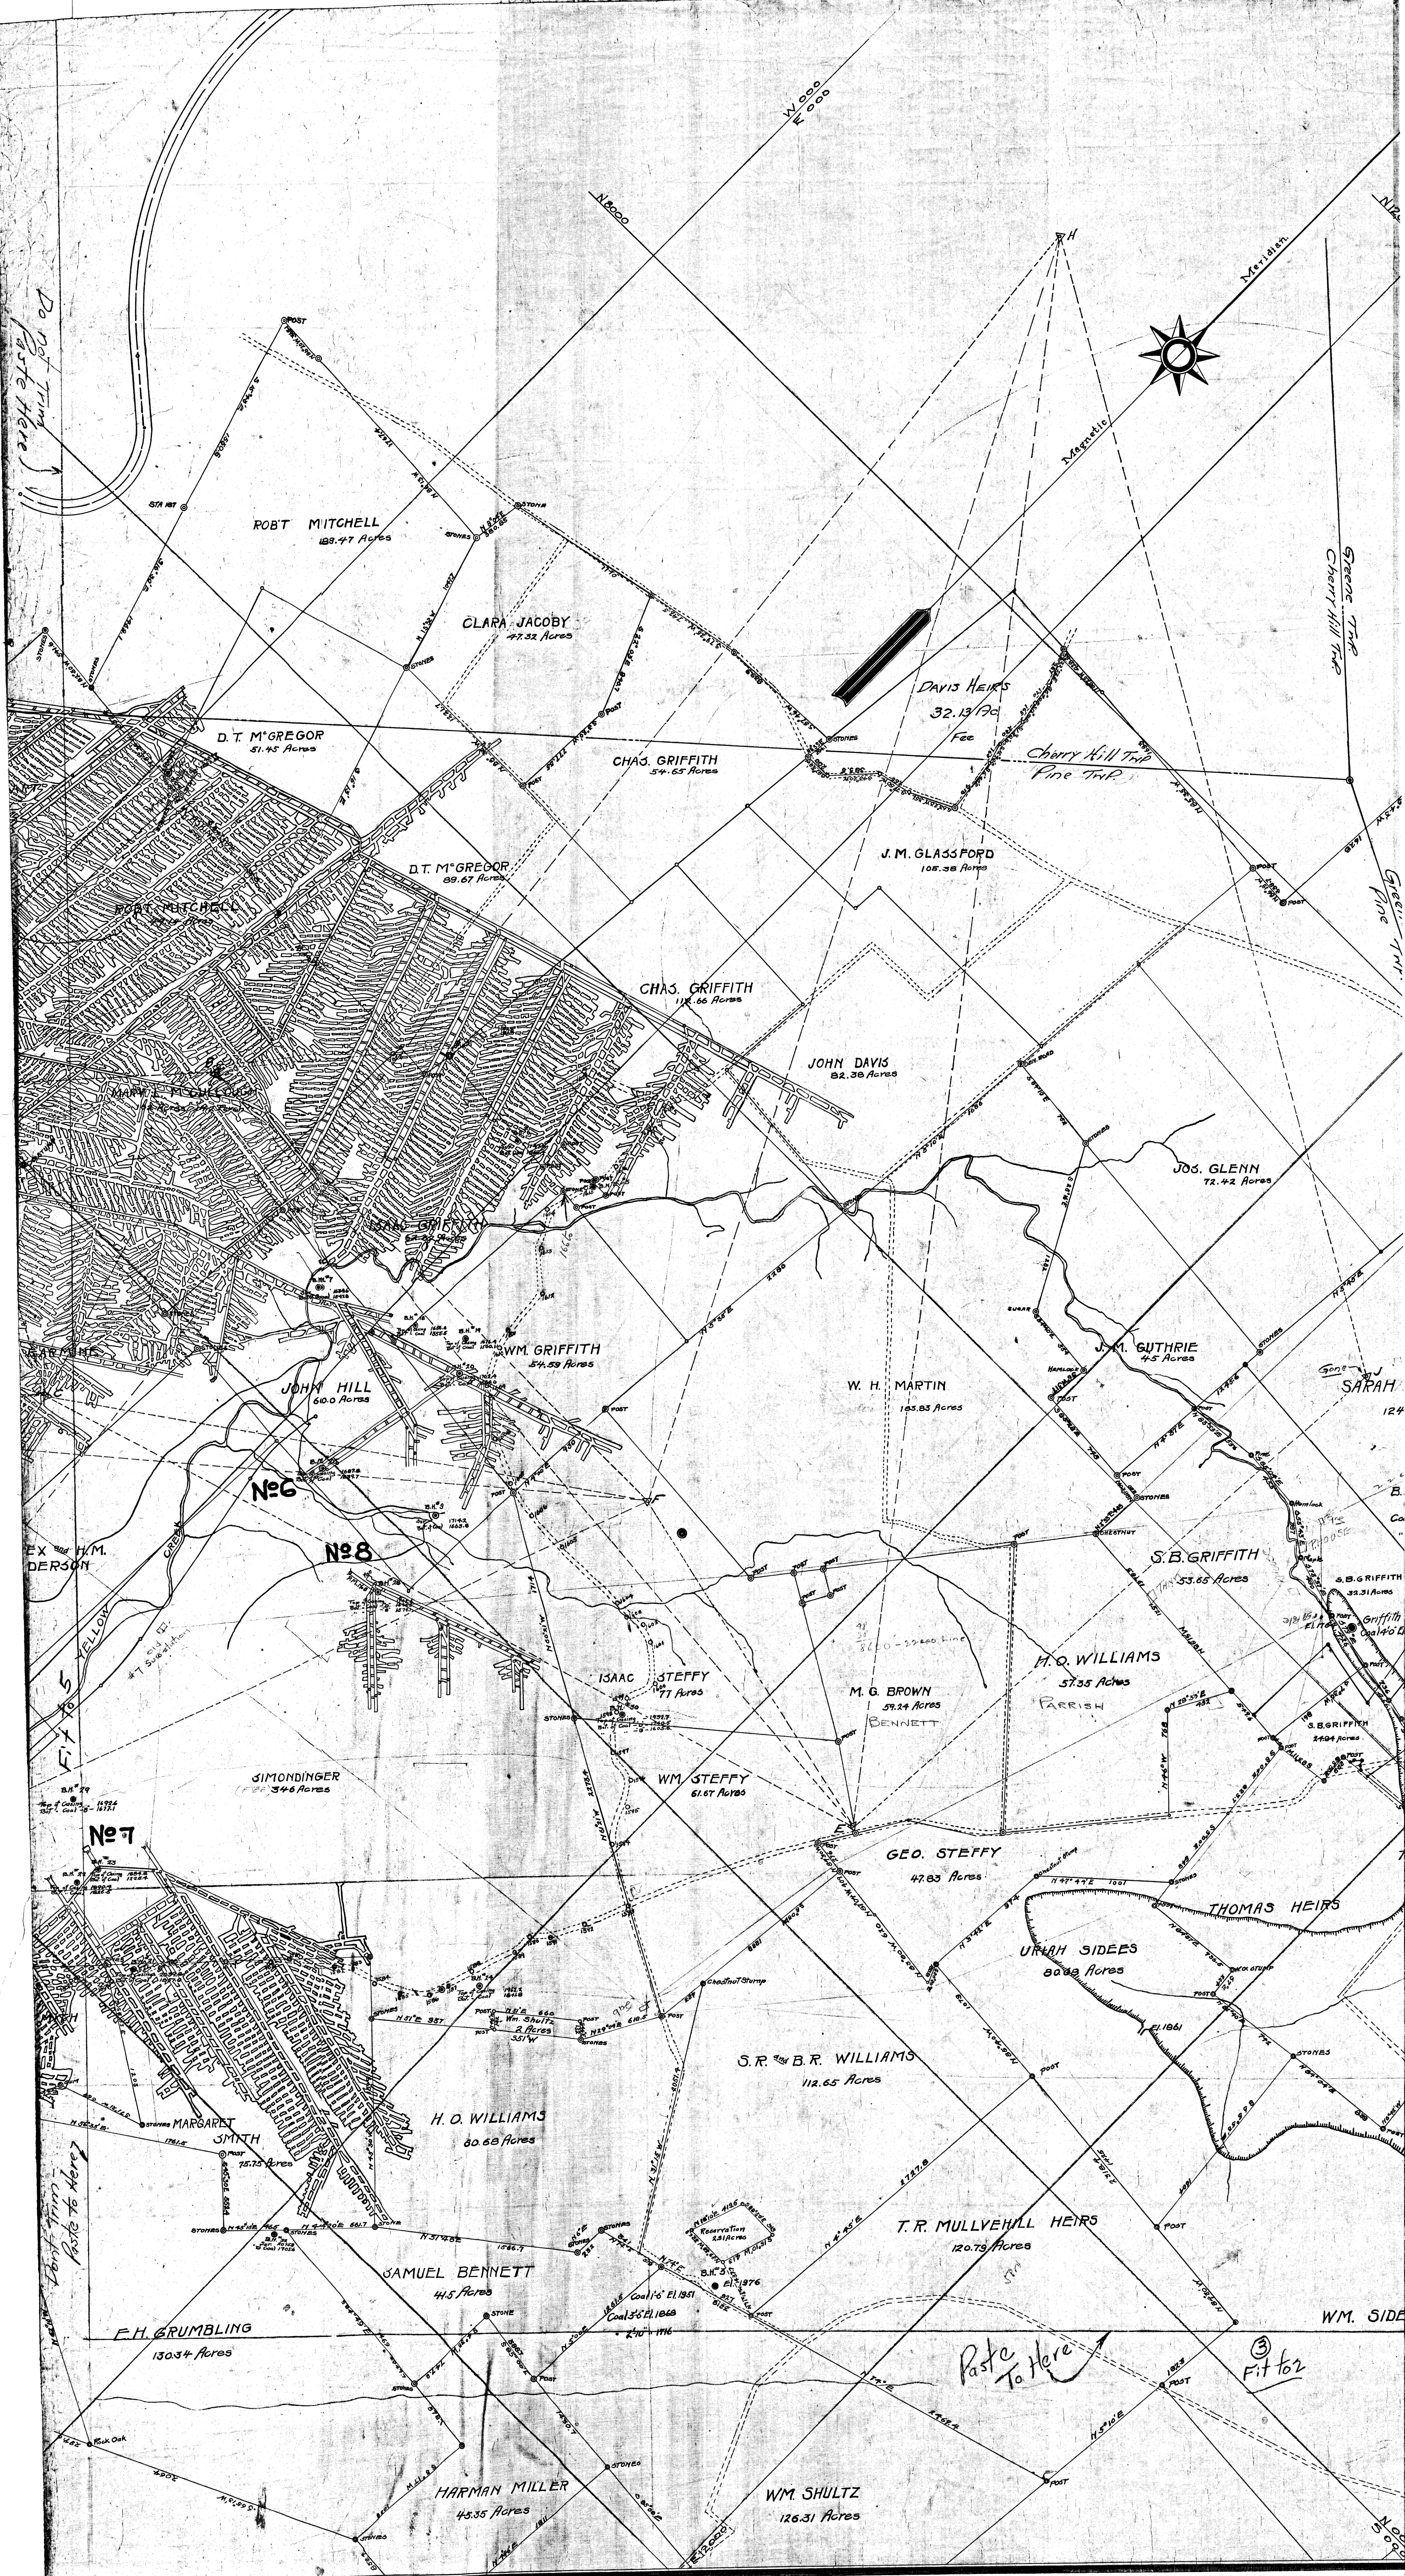

Do not trim
paste here

Paste
to Here

③
Fit to 2

ROBT MITCHELL
89.47 Acres

CLARA JACOBY
47.32 Acres

D. T. M'GREGOR
51.45 Acres

D. T. M'GREGOR
89.67 Acres

CHAS. GRIFFITH
54.65 Acres

DAVIS HEIRS
32.1975
Fee

Cherry Hill Trp
Pine Trp

J. M. GLASSFORD
105.38 Acres

CHAS. GRIFFITH
112.66 Acres

JOHN DAVIS
82.38 Acres

JOS. GLENN
72.42 Acres

JOHN HILL
60.0 Acres

WM. GRIFFITH
54.59 Acres

W. H. MARTIN
105.83 Acres

J. M. GUTHRIE
4.5 Acres

S. B. GRIFFITH
53.65 Acres

H. O. WILLIAMS
57.55 Acres

M. G. BROWN
57.24 Acres

BENNETT

ISAAC STEFFY
77 Acres

WM. STEFFY
61.67 Acres

GEO. STEFFY
47.83 Acres

THOMAS HEIRS

URAH SIDES
80.0 Acres

S. R. & B. R. WILLIAMS
112.65 Acres

H. O. WILLIAMS
80.63 Acres

SAMUEL BENNETT
44.5 Acres

T. R. MULLVEHILL HEIRS
120.75 Acres

F. H. GRUMBLING
130.34 Acres

HARMAN MILLER
45.35 Acres

WM. SHULTZ
126.31 Acres

WM. SIDE