


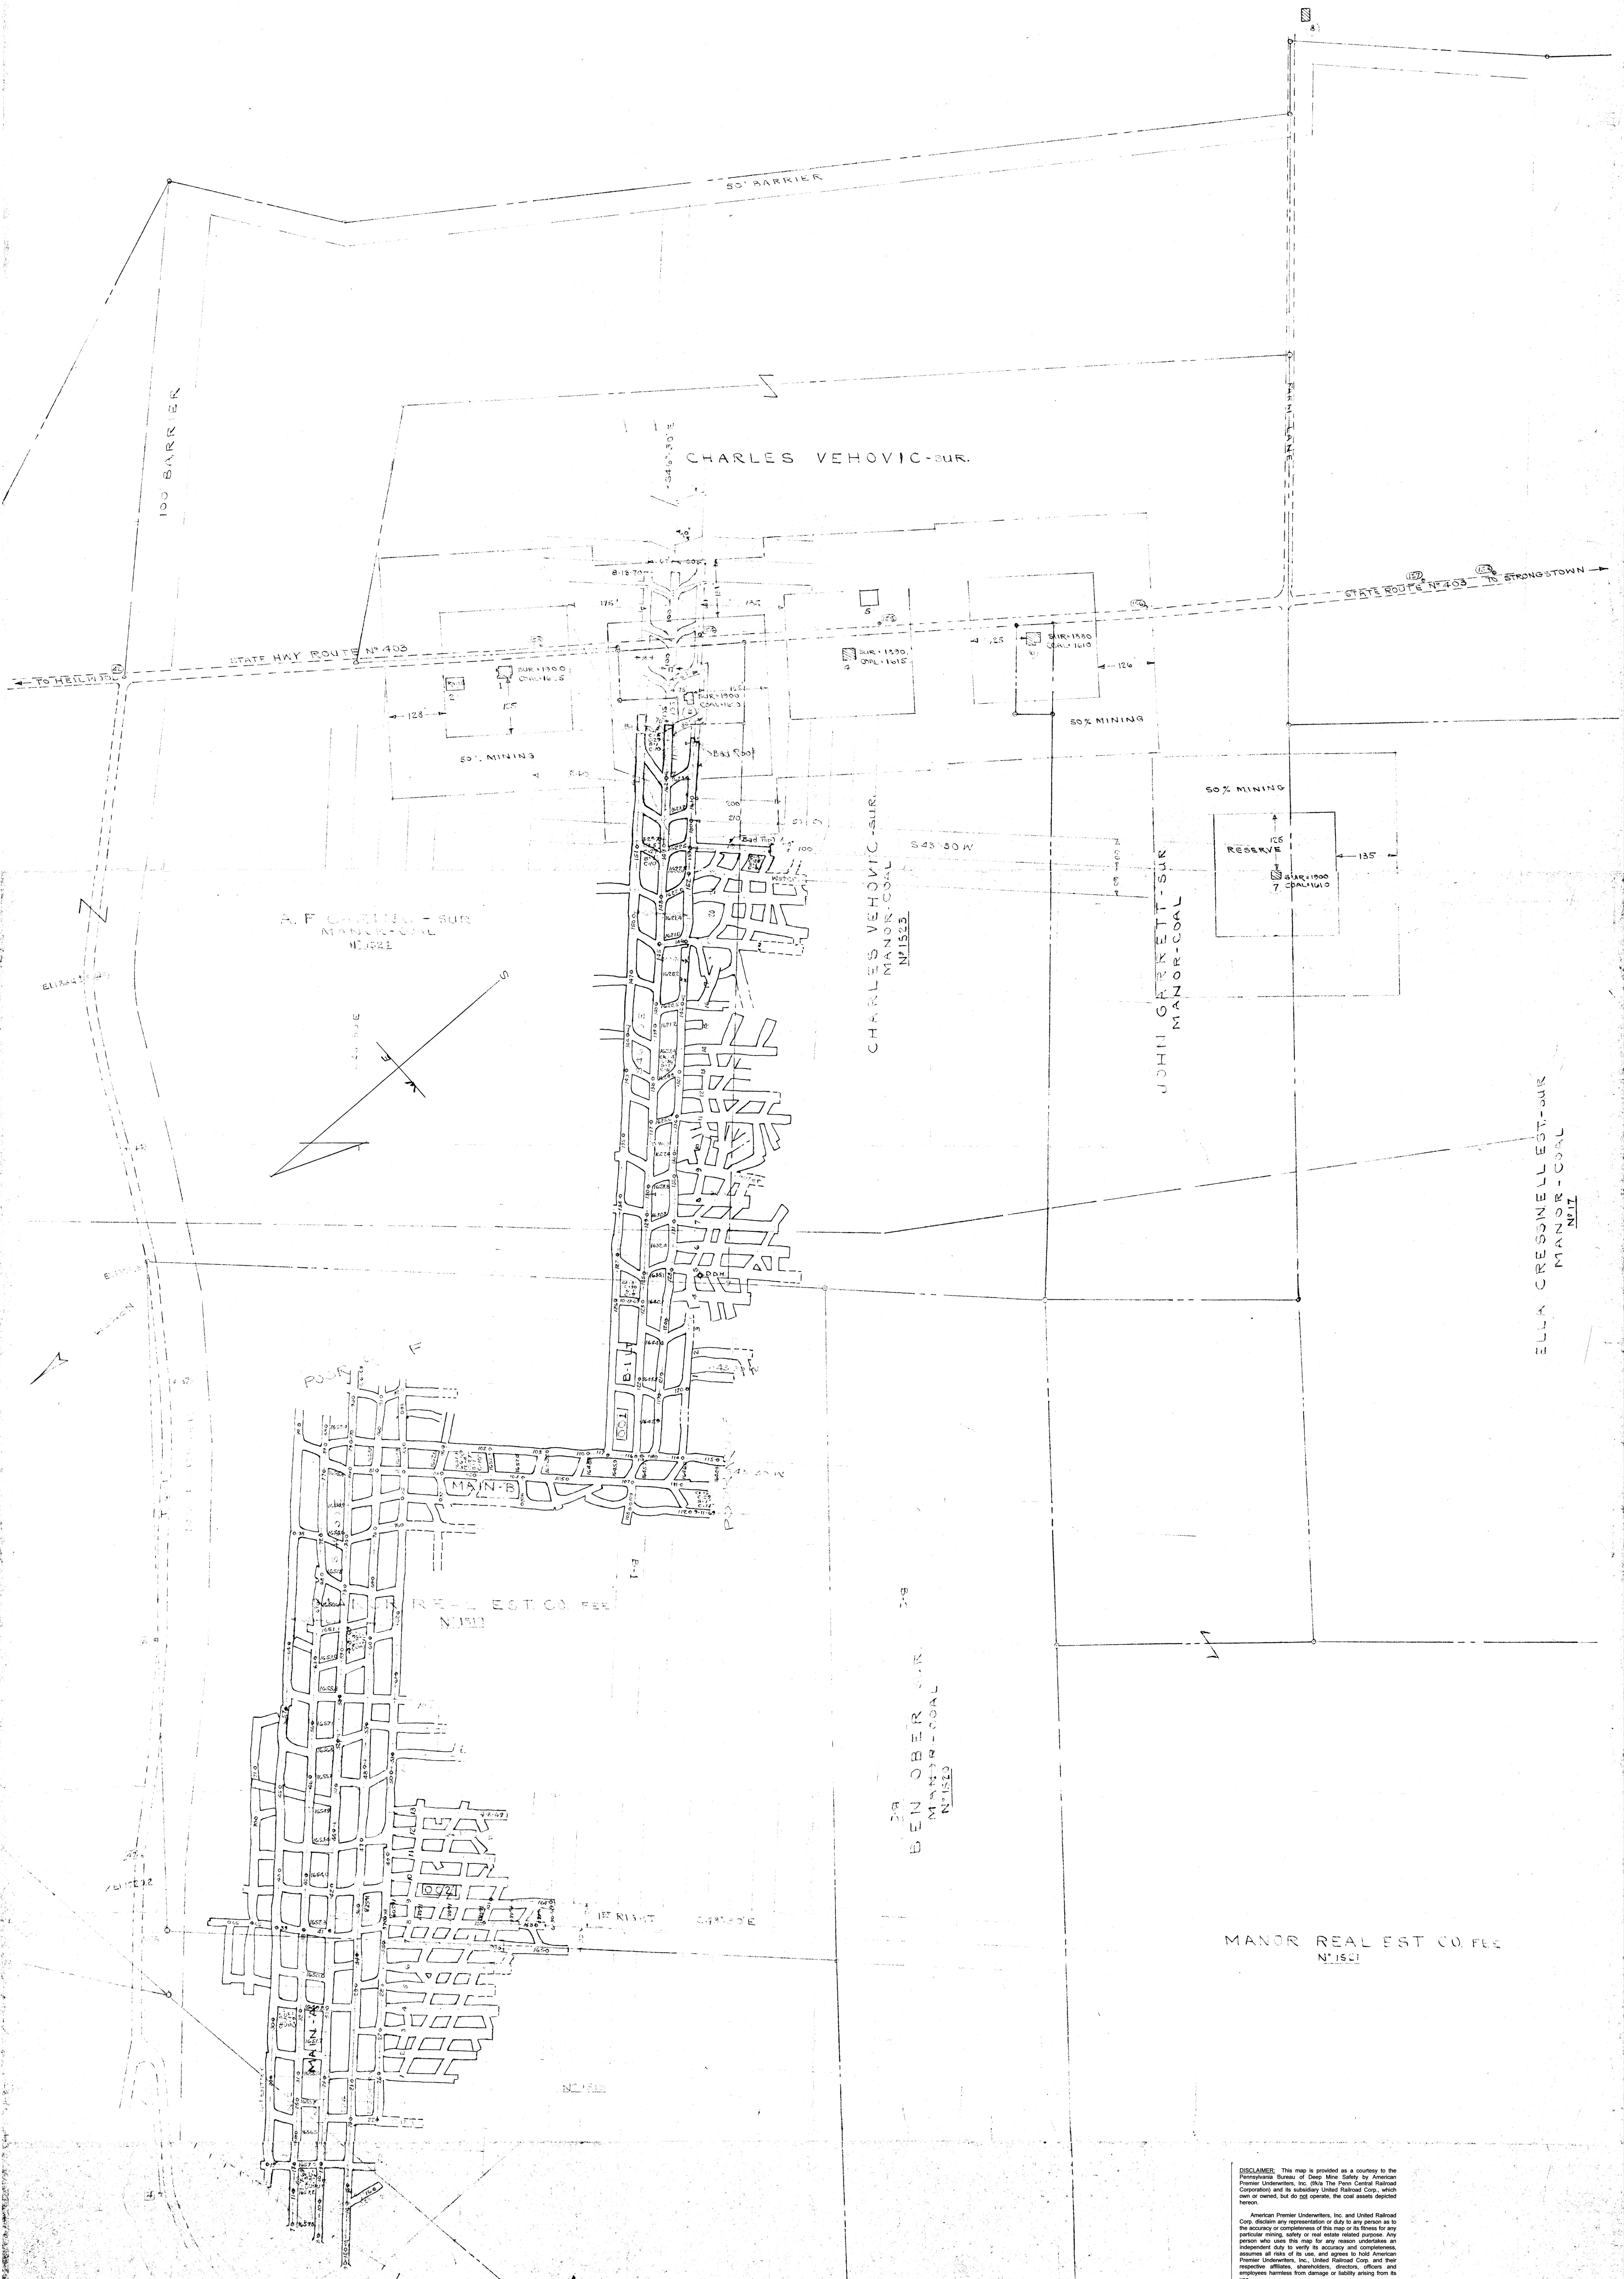

PERMIT N#25.3 PROJECTION N#1
VALLEY COAL CO.
N#12 MINE
LOWER FREEPORT
PING TWP INDIANA CO
NOV 1900 SCALE 1"=100'
Martin C. Kirsch P.E.
NED N#3 3-02397

LEGEND
PROJECTED MINING AREA
FROM
OUTLINED IN BROWN
BLDN PROTECTION AREA
OUTLINED IN RED

DEEP MINE SAFETY 100'

DISCLAIMER: This map is provided as a courtesy to the Pennsylvania Bureau of Deep Mine Safety by American Premier Underwriters, Inc. (APA), The Pennsylvania Railroad Corporation and its subsidiary United Railroad Corp., which own or owned, but do not operate, the coal assets depicted herein.
American Premier Underwriters, Inc. and United Railroad Corp. disclaim any representation or duty to any person as to the accuracy or completeness of this map or its use for any particular mining, safety or real estate related purpose. Any person who uses this map for any reason undertakes an independent duty to verify its accuracy and completeness, assumes all risks of its use, and agrees to hold American Premier Underwriters, Inc., United Railroad Corp. and their respective officers, shareholders, directors, officers and employees harmless from damage or liability arising from its use.