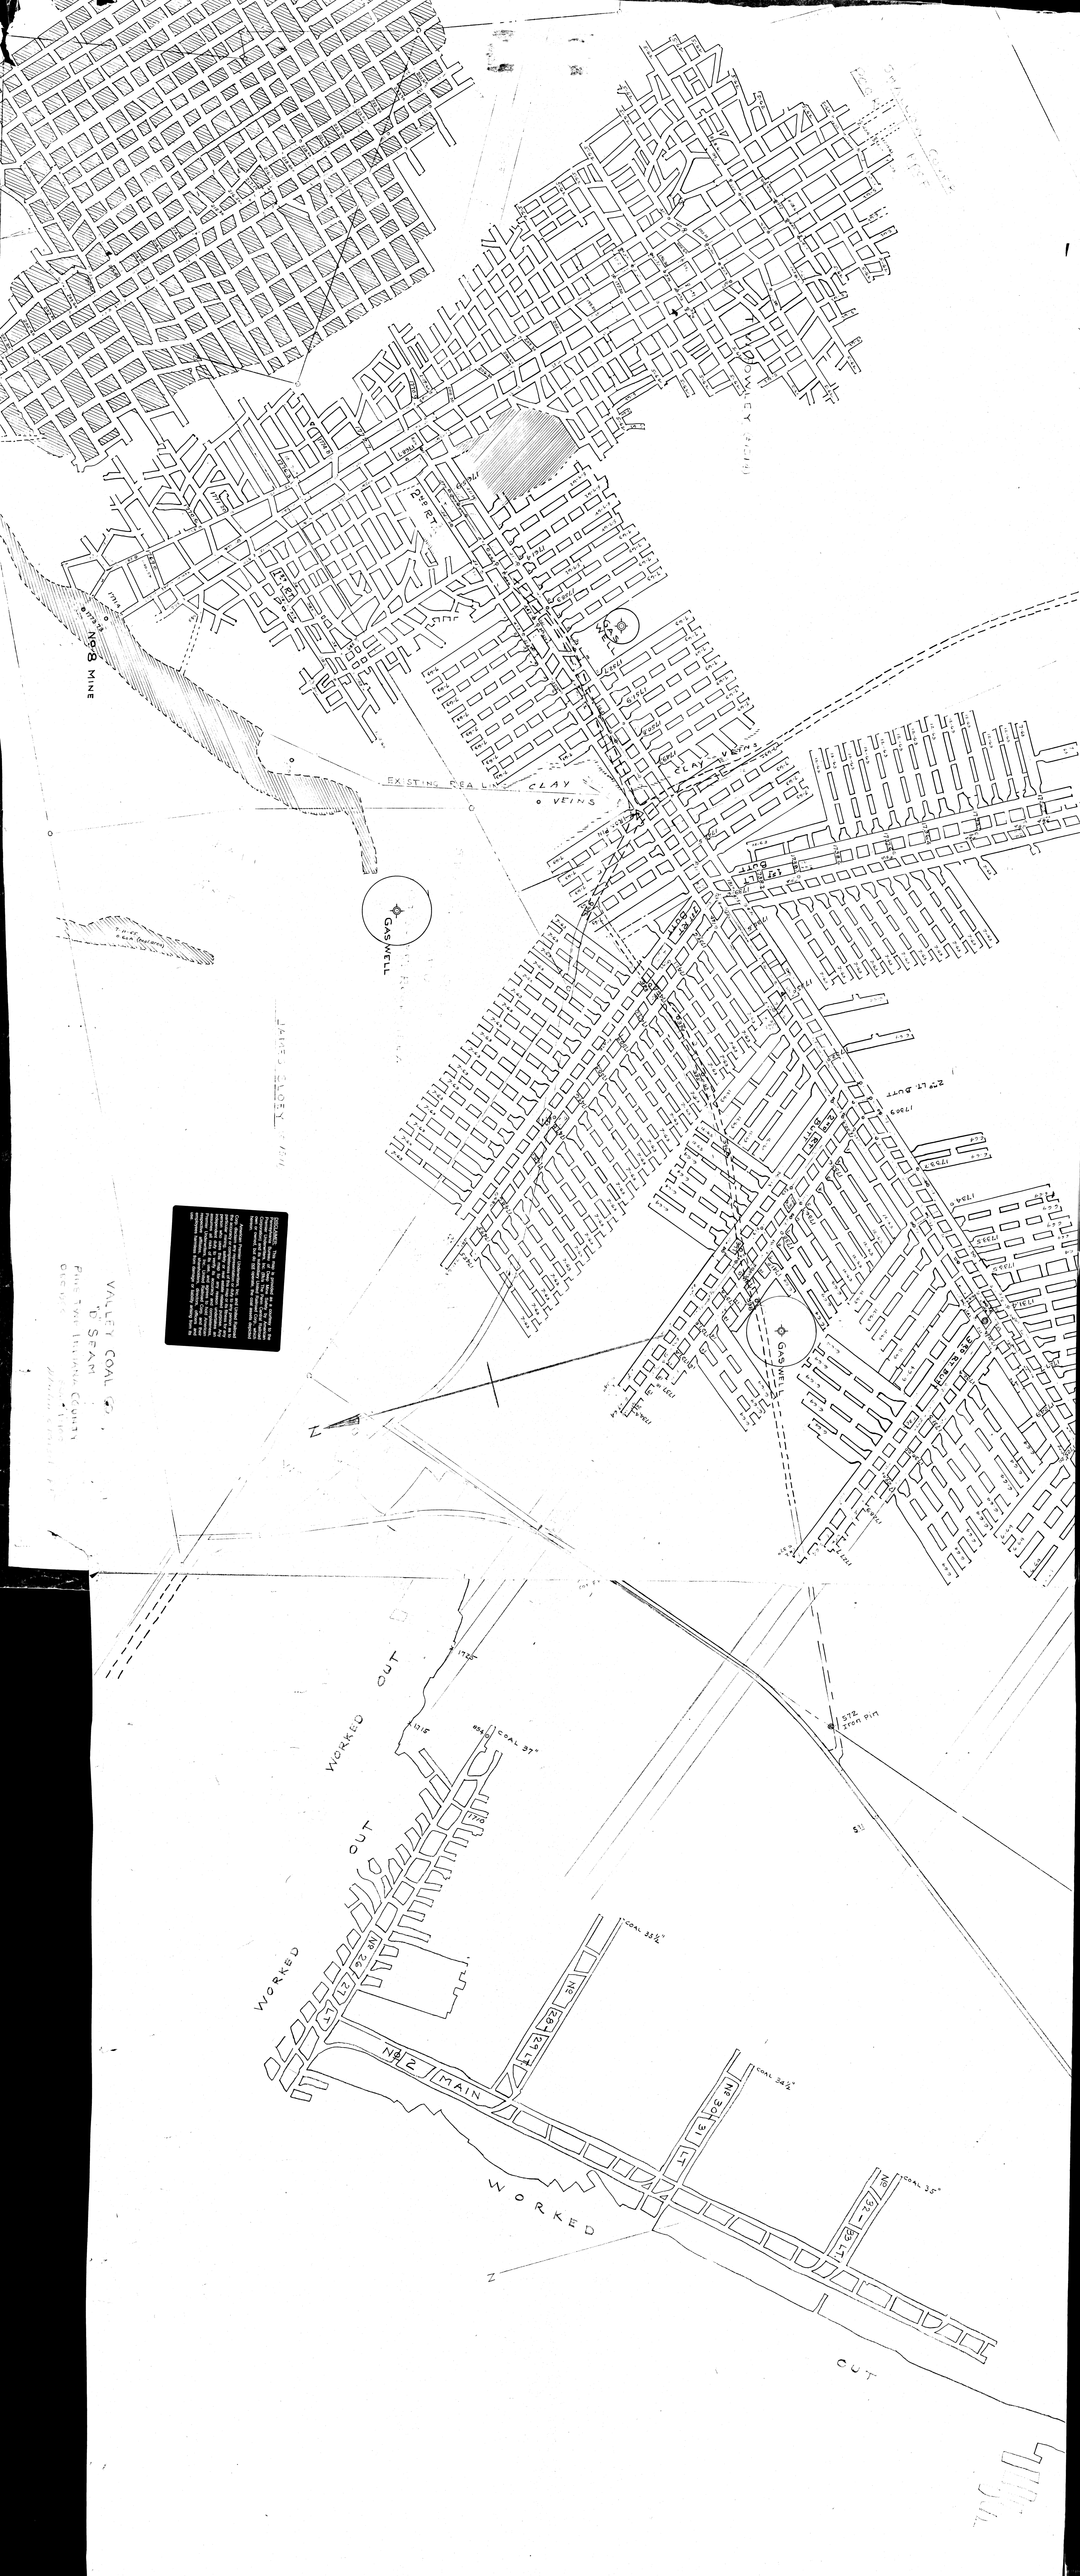

NO 8 MINE
EXISTING REALIGNED CLAY VEINS
CLAY VEINS
GASWELL
GAS WELL
2ND LT DUFF
WORKED OUT
WORKED OUT
WORKED OUT
NO 2 MAIN
COAL 37°
COAL 33½°
COAL 34½°
COAL 35°
STR IRON PIN
VALLEY COAL CO.
"D" SEAM