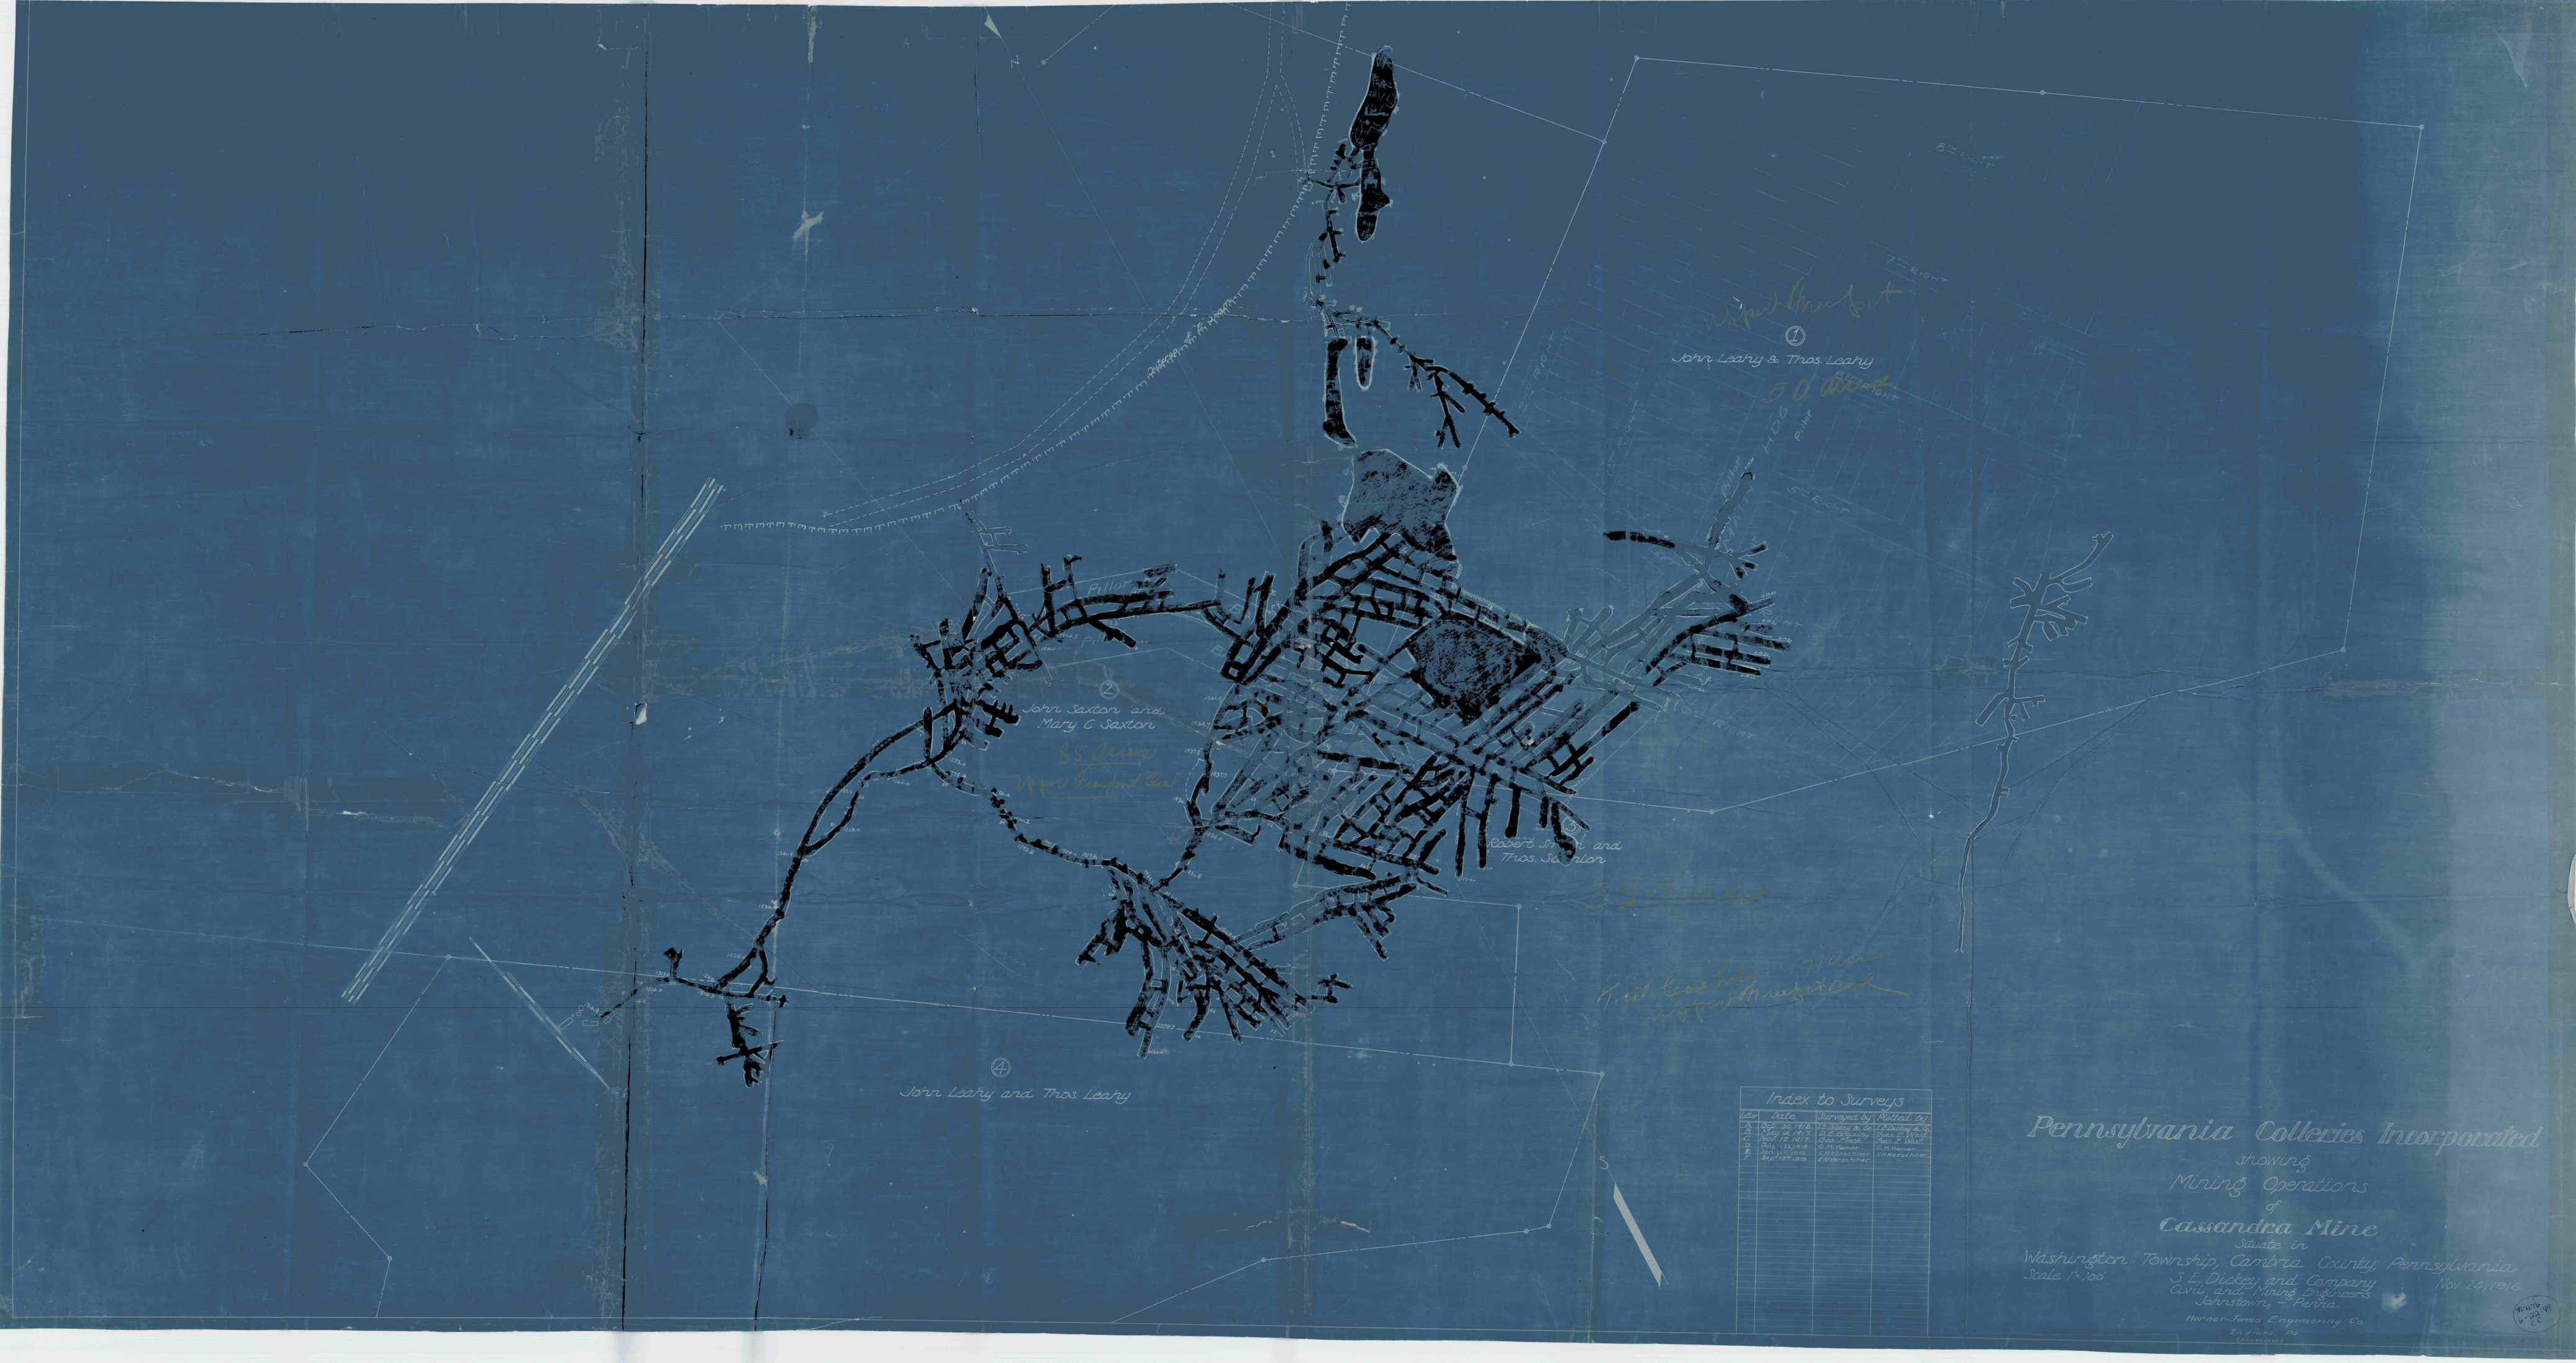
John Leahy & Thos Leahy
John Sexton and
Mary C. Sexton
John Leahy and Thos. Leahy
Index to Surveys
Pennsylvania Collieries Incorporated
showing
Mining Operations
of
Cassandra Mine
Situate in
Washington Township, Cambria County, Pennsylvania
Scale 1" = 100'
S. E. Dicey and Company
Civil and Mining Engineers
Johnstown, Penna.
Nov. 23, 1916
Herner-Jones Engineering Co.