


11-A

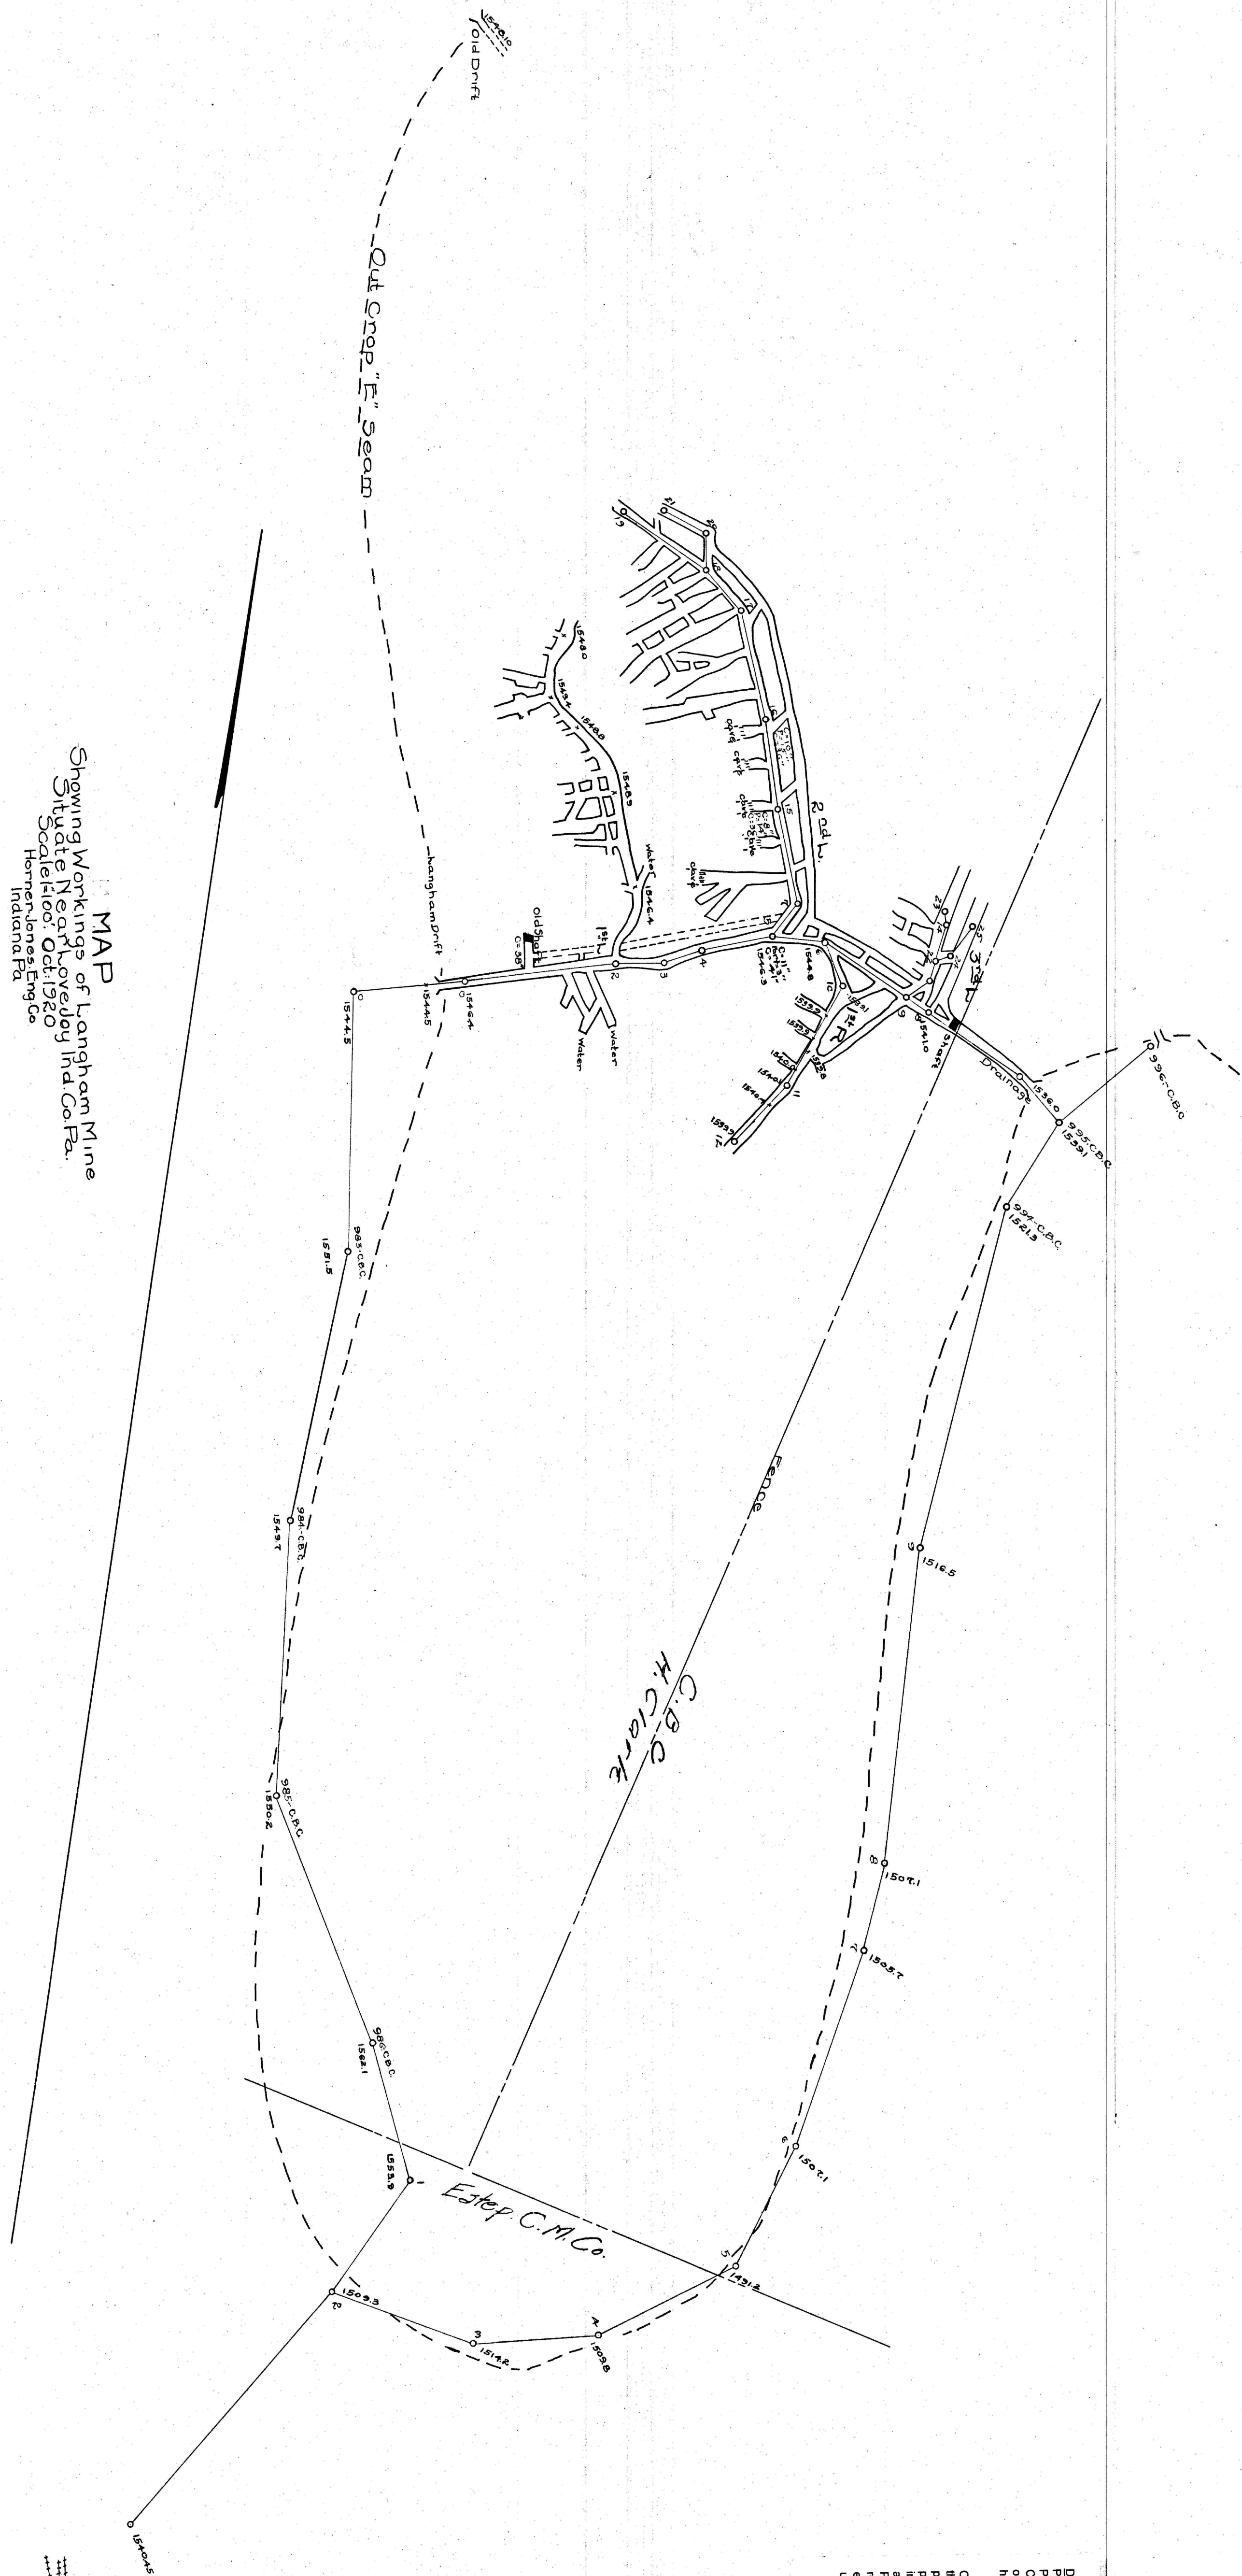

DISCLAIMER: This map is provided as a courtesy to the Pennsylvania Bureau of Deep Mine Safety by American Premier Underwriters, Inc. (aka The Penn Central Railroad Corporation) and its subsidiary United Railroad Corp. which own or owned, but do not operate, the coal assets depicted herein.

American Premier Underwriters, Inc. and United Railroad Corp. disclaim any representation or duty to any person as to the accuracy or completeness of this map as it relates to any particular mining, safety or health issue. This disclaimer is not intended to constitute an admission of fault, nor does it constitute an independent duty to verify its accuracy and completeness, assumes all risks of its use, and agrees to hold American Premier Underwriters, Inc., United Railroad Corp. and their respective affiliates, shareholders, directors, officers and employees harmless from damage or liability arising from its use.

Cpd From Blue Print - W.G.

2-11

D-11

11-D

D-11