


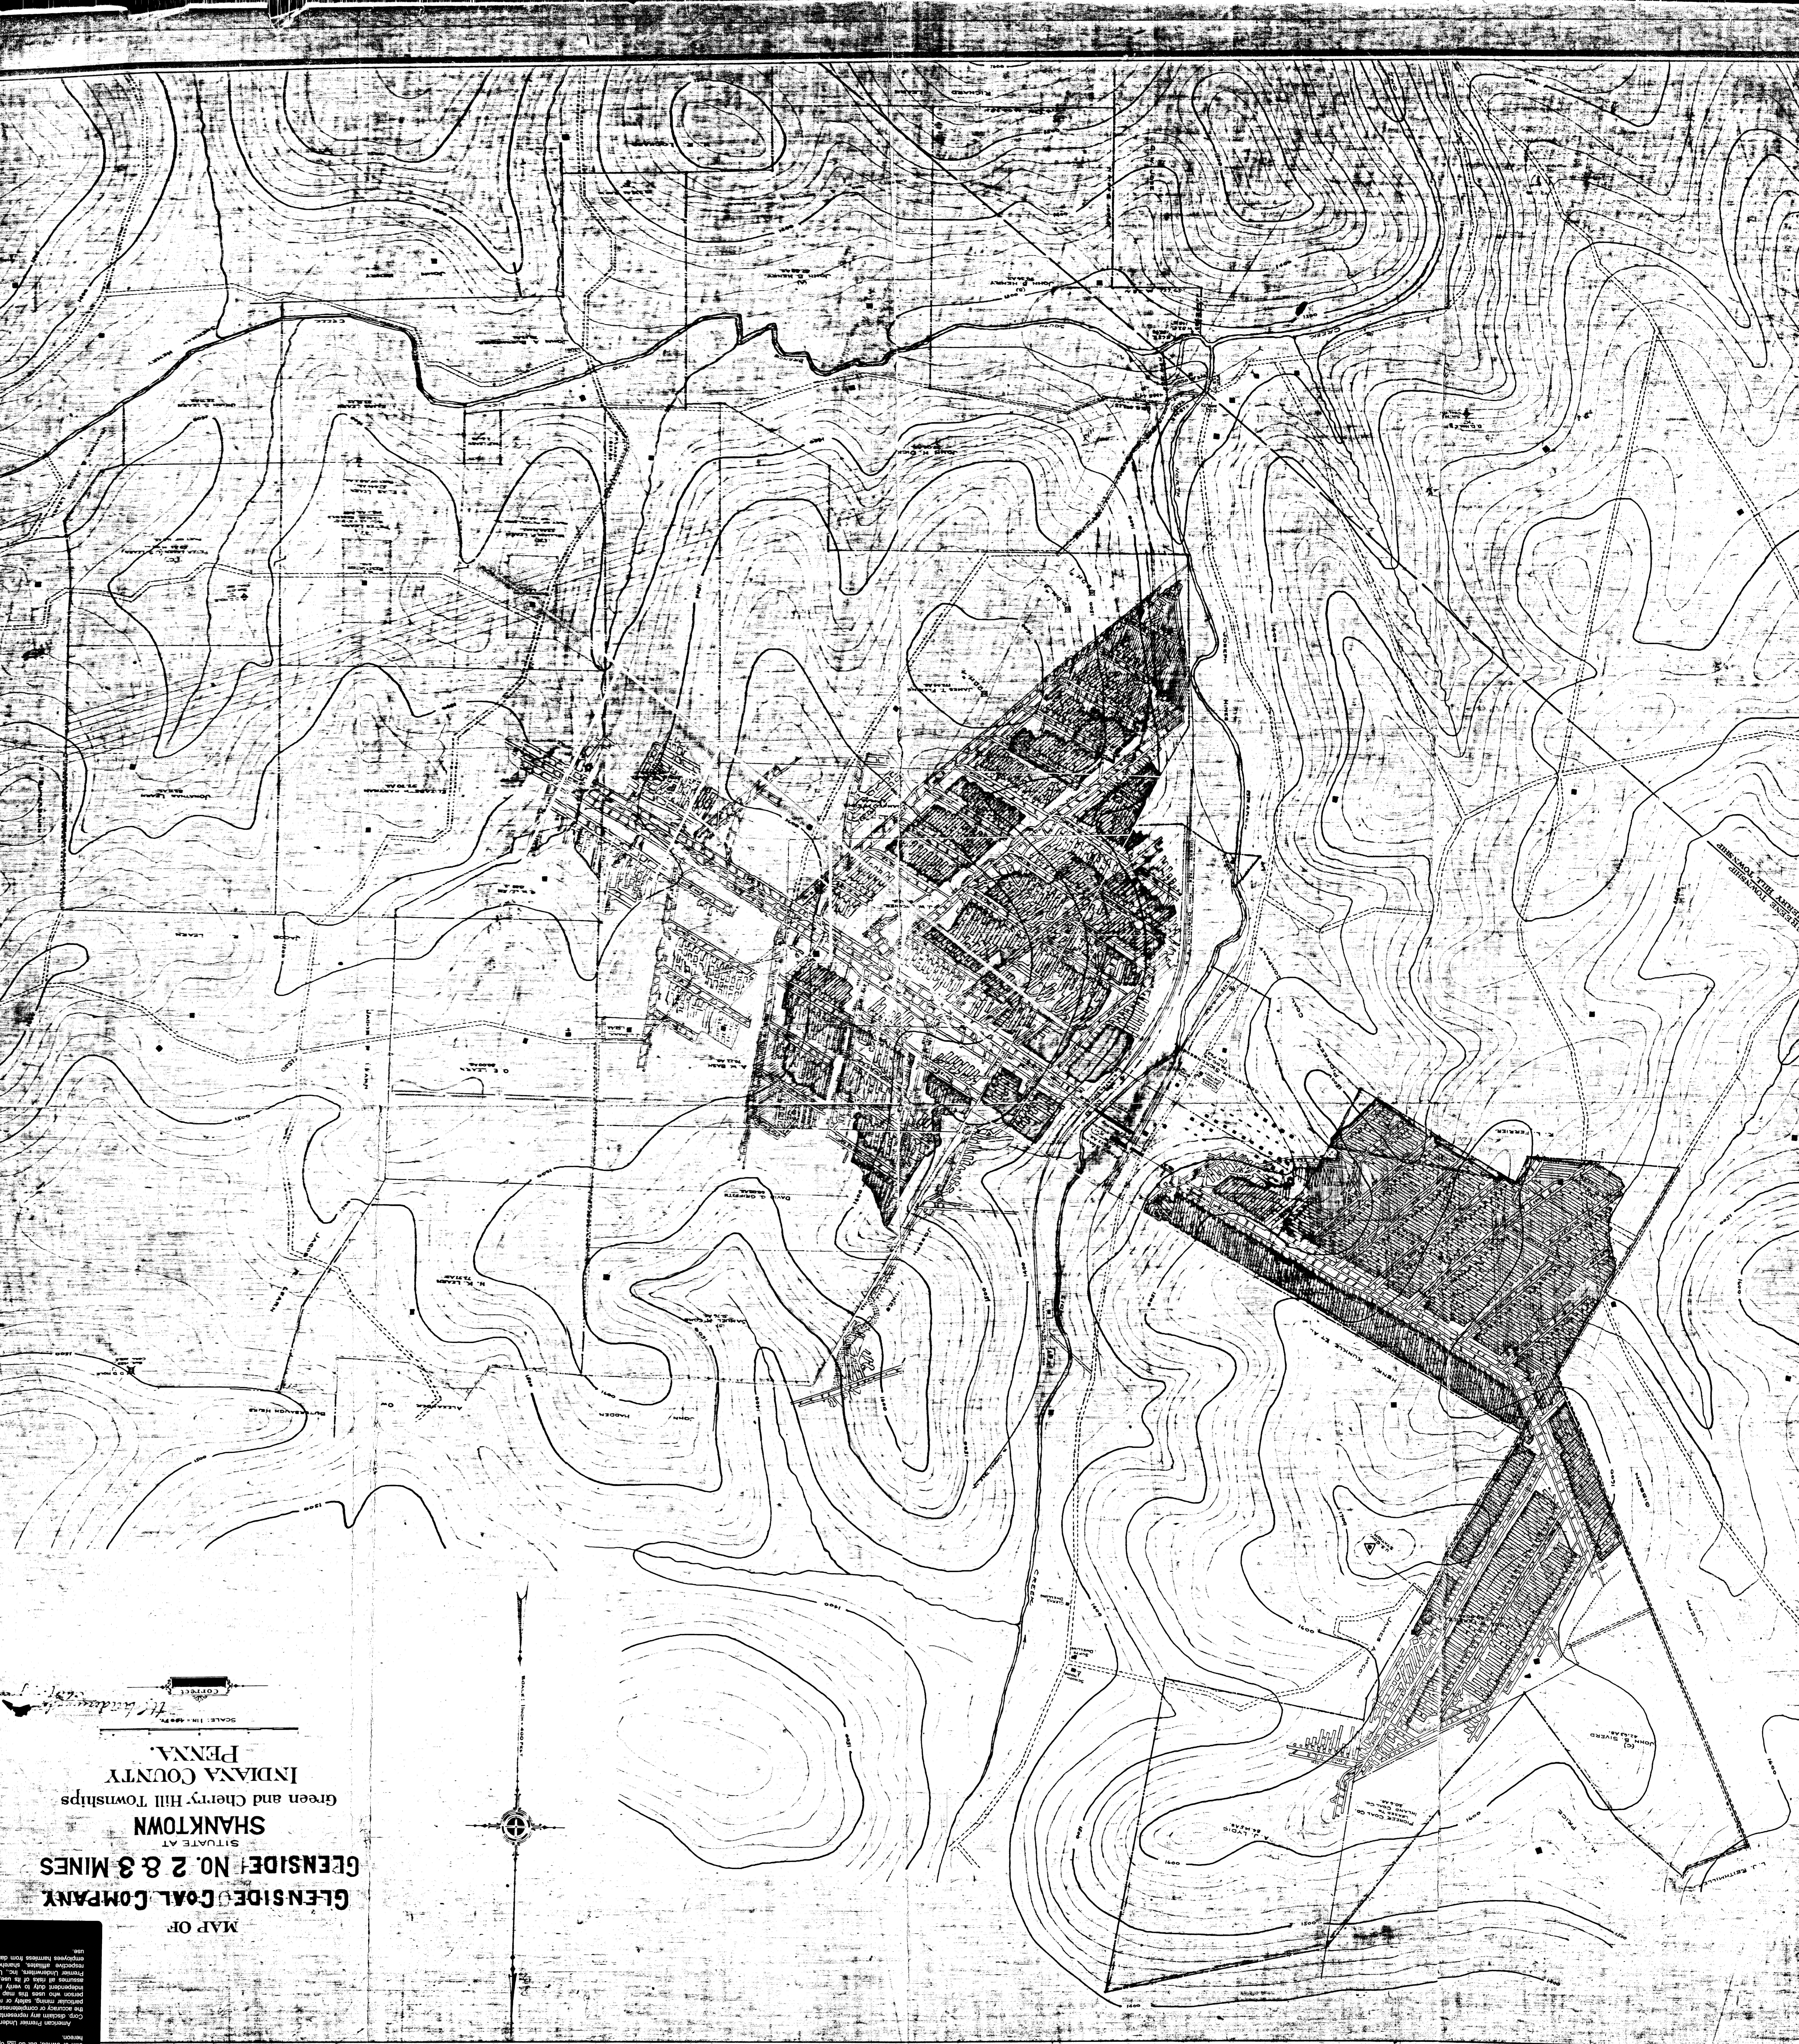

MAP OF
GLENSIDE COAL COMPANY
GLENSIDE NO. 2 & 3 MINES
SITUATE AT
SHANKTOWN
Green and Cherry Hill Townships
INDIANA COUNTY
PENNA.

