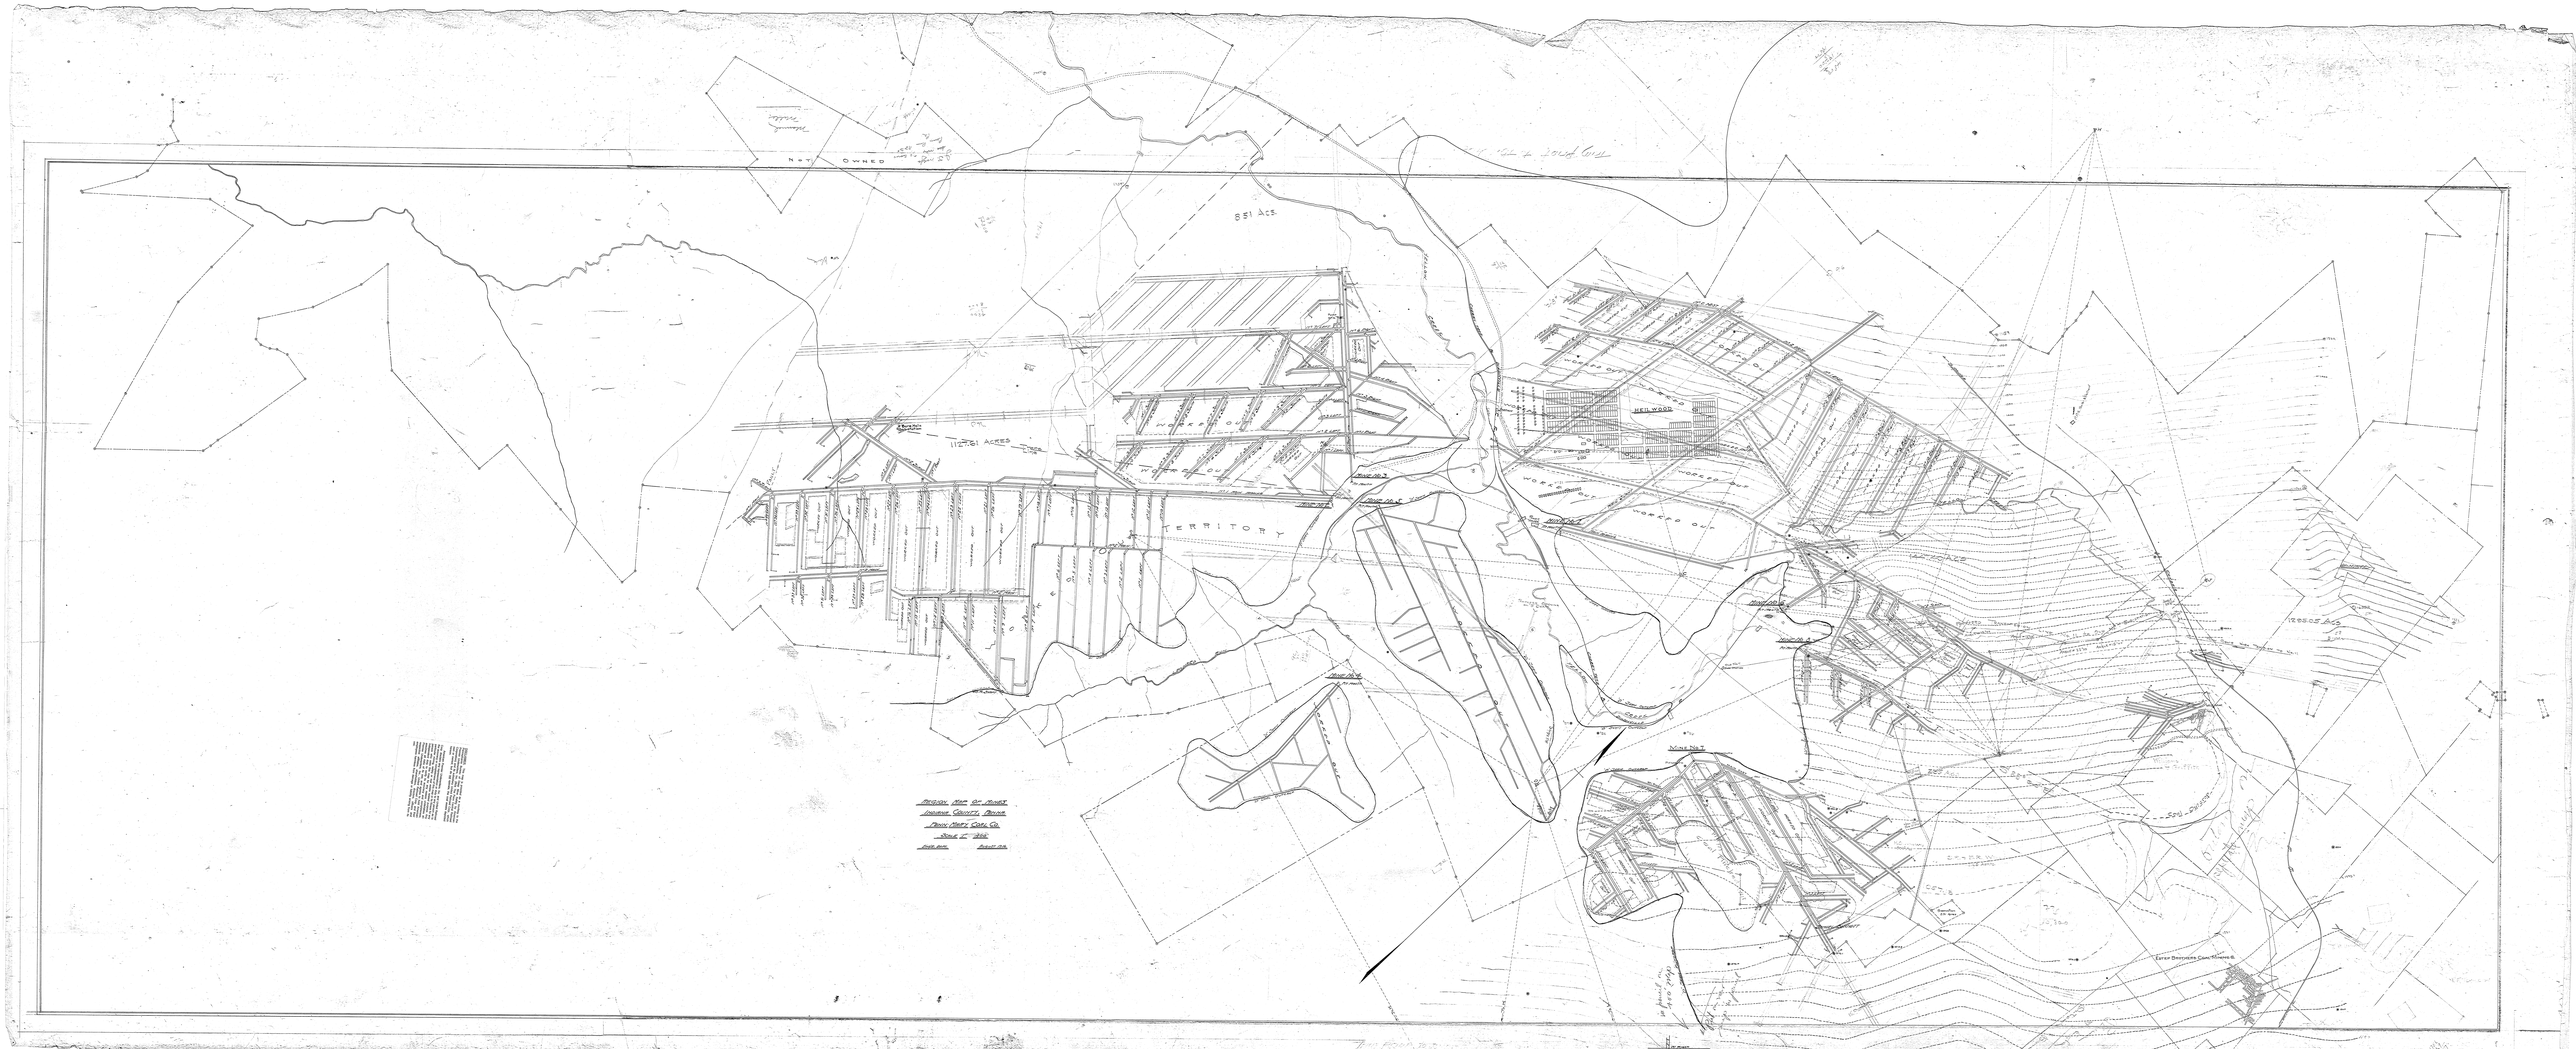NOT OWNED
851 Acs.
1127.61 ACRES
TERRITORY
WORKED OUT
HEILWOOD
Mine No. 7
Estep Brothers Coal Mining Co.
Region Map of Mines
Indiana County, Penna.
Penn Mary Coal Co.
Scale 1" =