
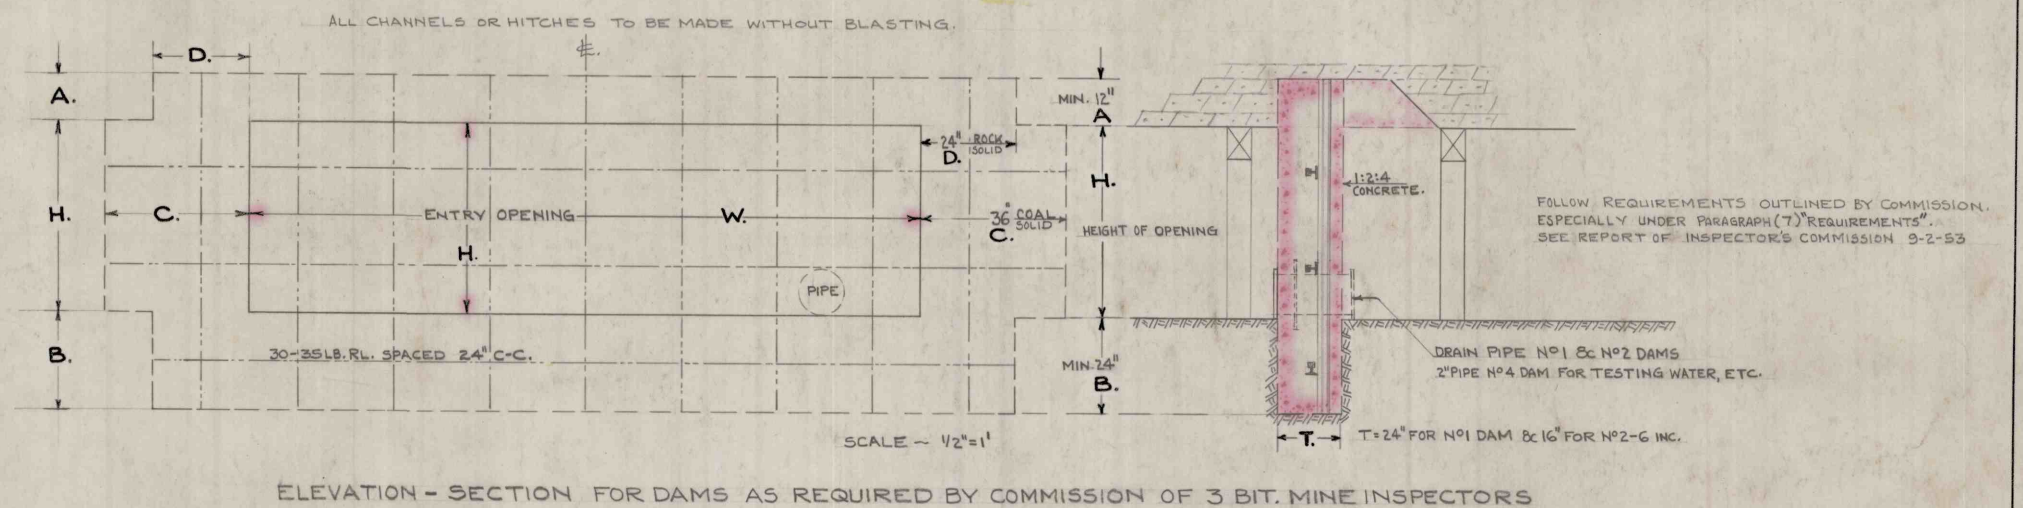


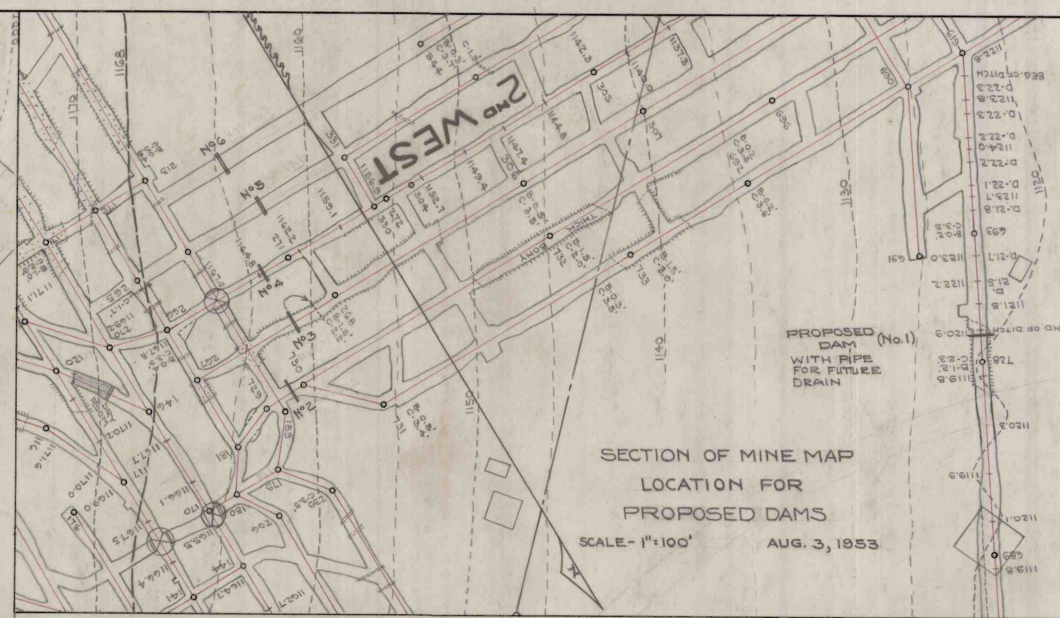

ELEVATION - SECTION FOR DAMS AS REQUIRED BY COMMISSION OF 3 BIT. MINE INSPECTORS

under construction
JAN-MAR. 1955

DISCLAIMER: This map is provided as a courtesy to the Pennsylvania Bureau of Deep Mine Safety by American Premier Underwriters, Inc. (USA The Penn Central Railroad Corporation) and its subsidiary United Railroad Corporation) and is not to be used for any purpose other than that for which it was intended. American Premier Underwriters, Inc. and United Railroad Corporation assume no liability for any error or omission in this map or for any damage or loss resulting from its use. This map is provided as a courtesy to the Pennsylvania Bureau of Deep Mine Safety by American Premier Underwriters, Inc. (USA The Penn Central Railroad Corporation) and its subsidiary United Railroad Corporation) and is not to be used for any purpose other than that for which it was intended. American Premier Underwriters, Inc. and United Railroad Corporation assume no liability for any error or omission in this map or for any damage or loss resulting from its use.

2-9-55 For J.D. LEADBETTER TO MAKE PERMANENT RECORD.
KEEP ONE PRINT FOR ALL RECORDS OF DAMS - SKETCH SIZES WITH HITCHES DETAILED AS TO DIMENSIONS, MATERIALS USED, ETC.

PROPOSED DAMS
2ND WEST ENTRIES
CLYMER NO. 2 MINE
CHERRYHILL TWP, INDIANA CO. PA.
SCALE - AS SHOWN AUG. 5 1953

ENGINEERING DEPARTMENT	CLEARFIELD BITUMINOUS COAL CORP.
REVISED 8-31-54 2-9-55	
PLAN - COMM. - PG.	DRAWN -
TRACED -	CHECKED -
Paul Hill ENGINEER	