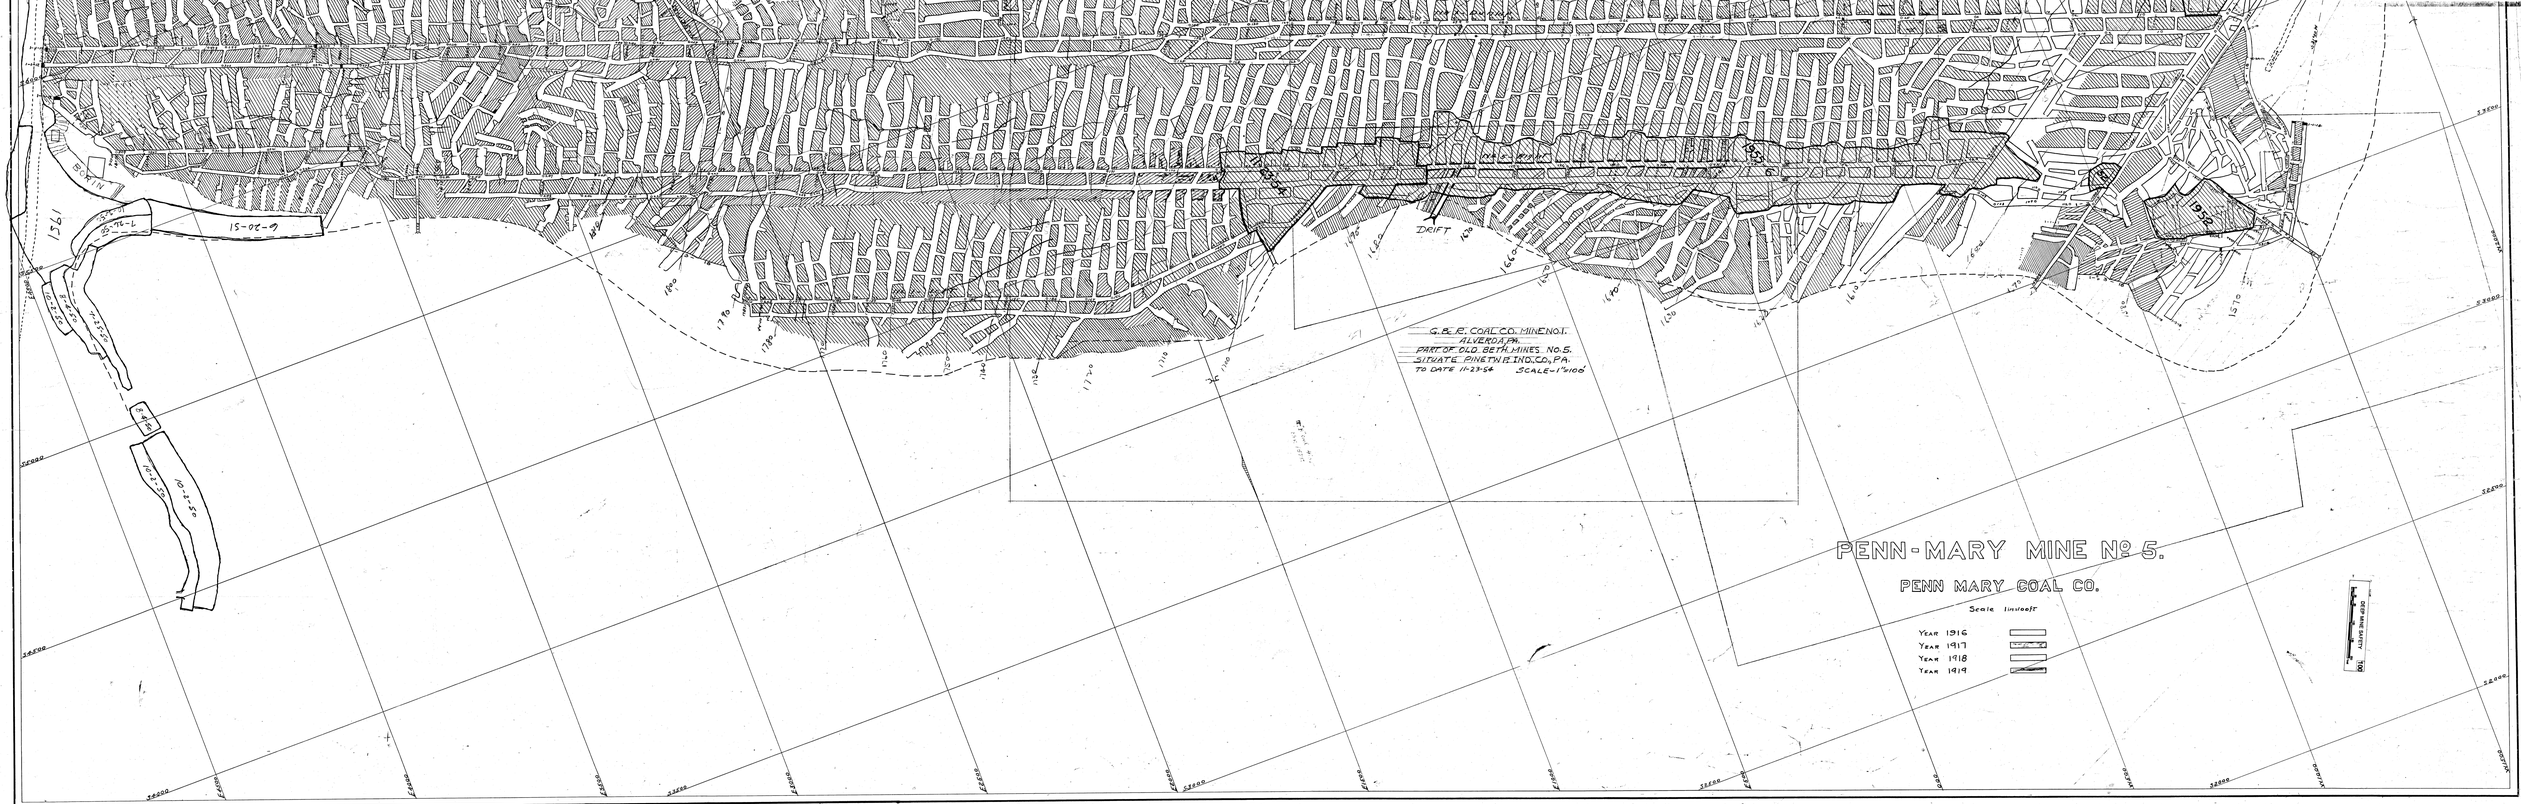

PENN-MARY MINE No. 5.

PENN MARY COAL CO.

Scale 1in.=100ft.

Year 1916
Year 1917
Year 1918
Year 1919

G.&R. COAL CO. MINE NO.1.
ALVERDA, PA.
PART OF OLD BETH. MINES NO.5.
SITUATE PINE TWP. IND. CO., PA.
TO DATE 11-23-54 SCALE-1"=100'

DEEP MINE SAFETY 100
0 25 50 100 150 200 Feet
S3500
S3000
S2500
S2000
W2000
W1500
W1000
W500
000
E500
E1000
E1500
E2000
E2500
E3000
E3500
E4000
E4500
S3000
S3500
S4000
S4500
S5000
S5500
S6000
1952
52
1955 6
11-23-54
DRIFT
1570
1580
1600
1610
1620
1630
1640
1650
1660
1670
1680
1690
1700
1710
1720
1730
1740
1750
1760
1770
1780
1790
1800
1810
6-20-51
7-26-50
10-2-50
7-25-50
8-4-50
10-2-50
10-2-50
10-2-50
8-4-50
BORIN
1951

⑤