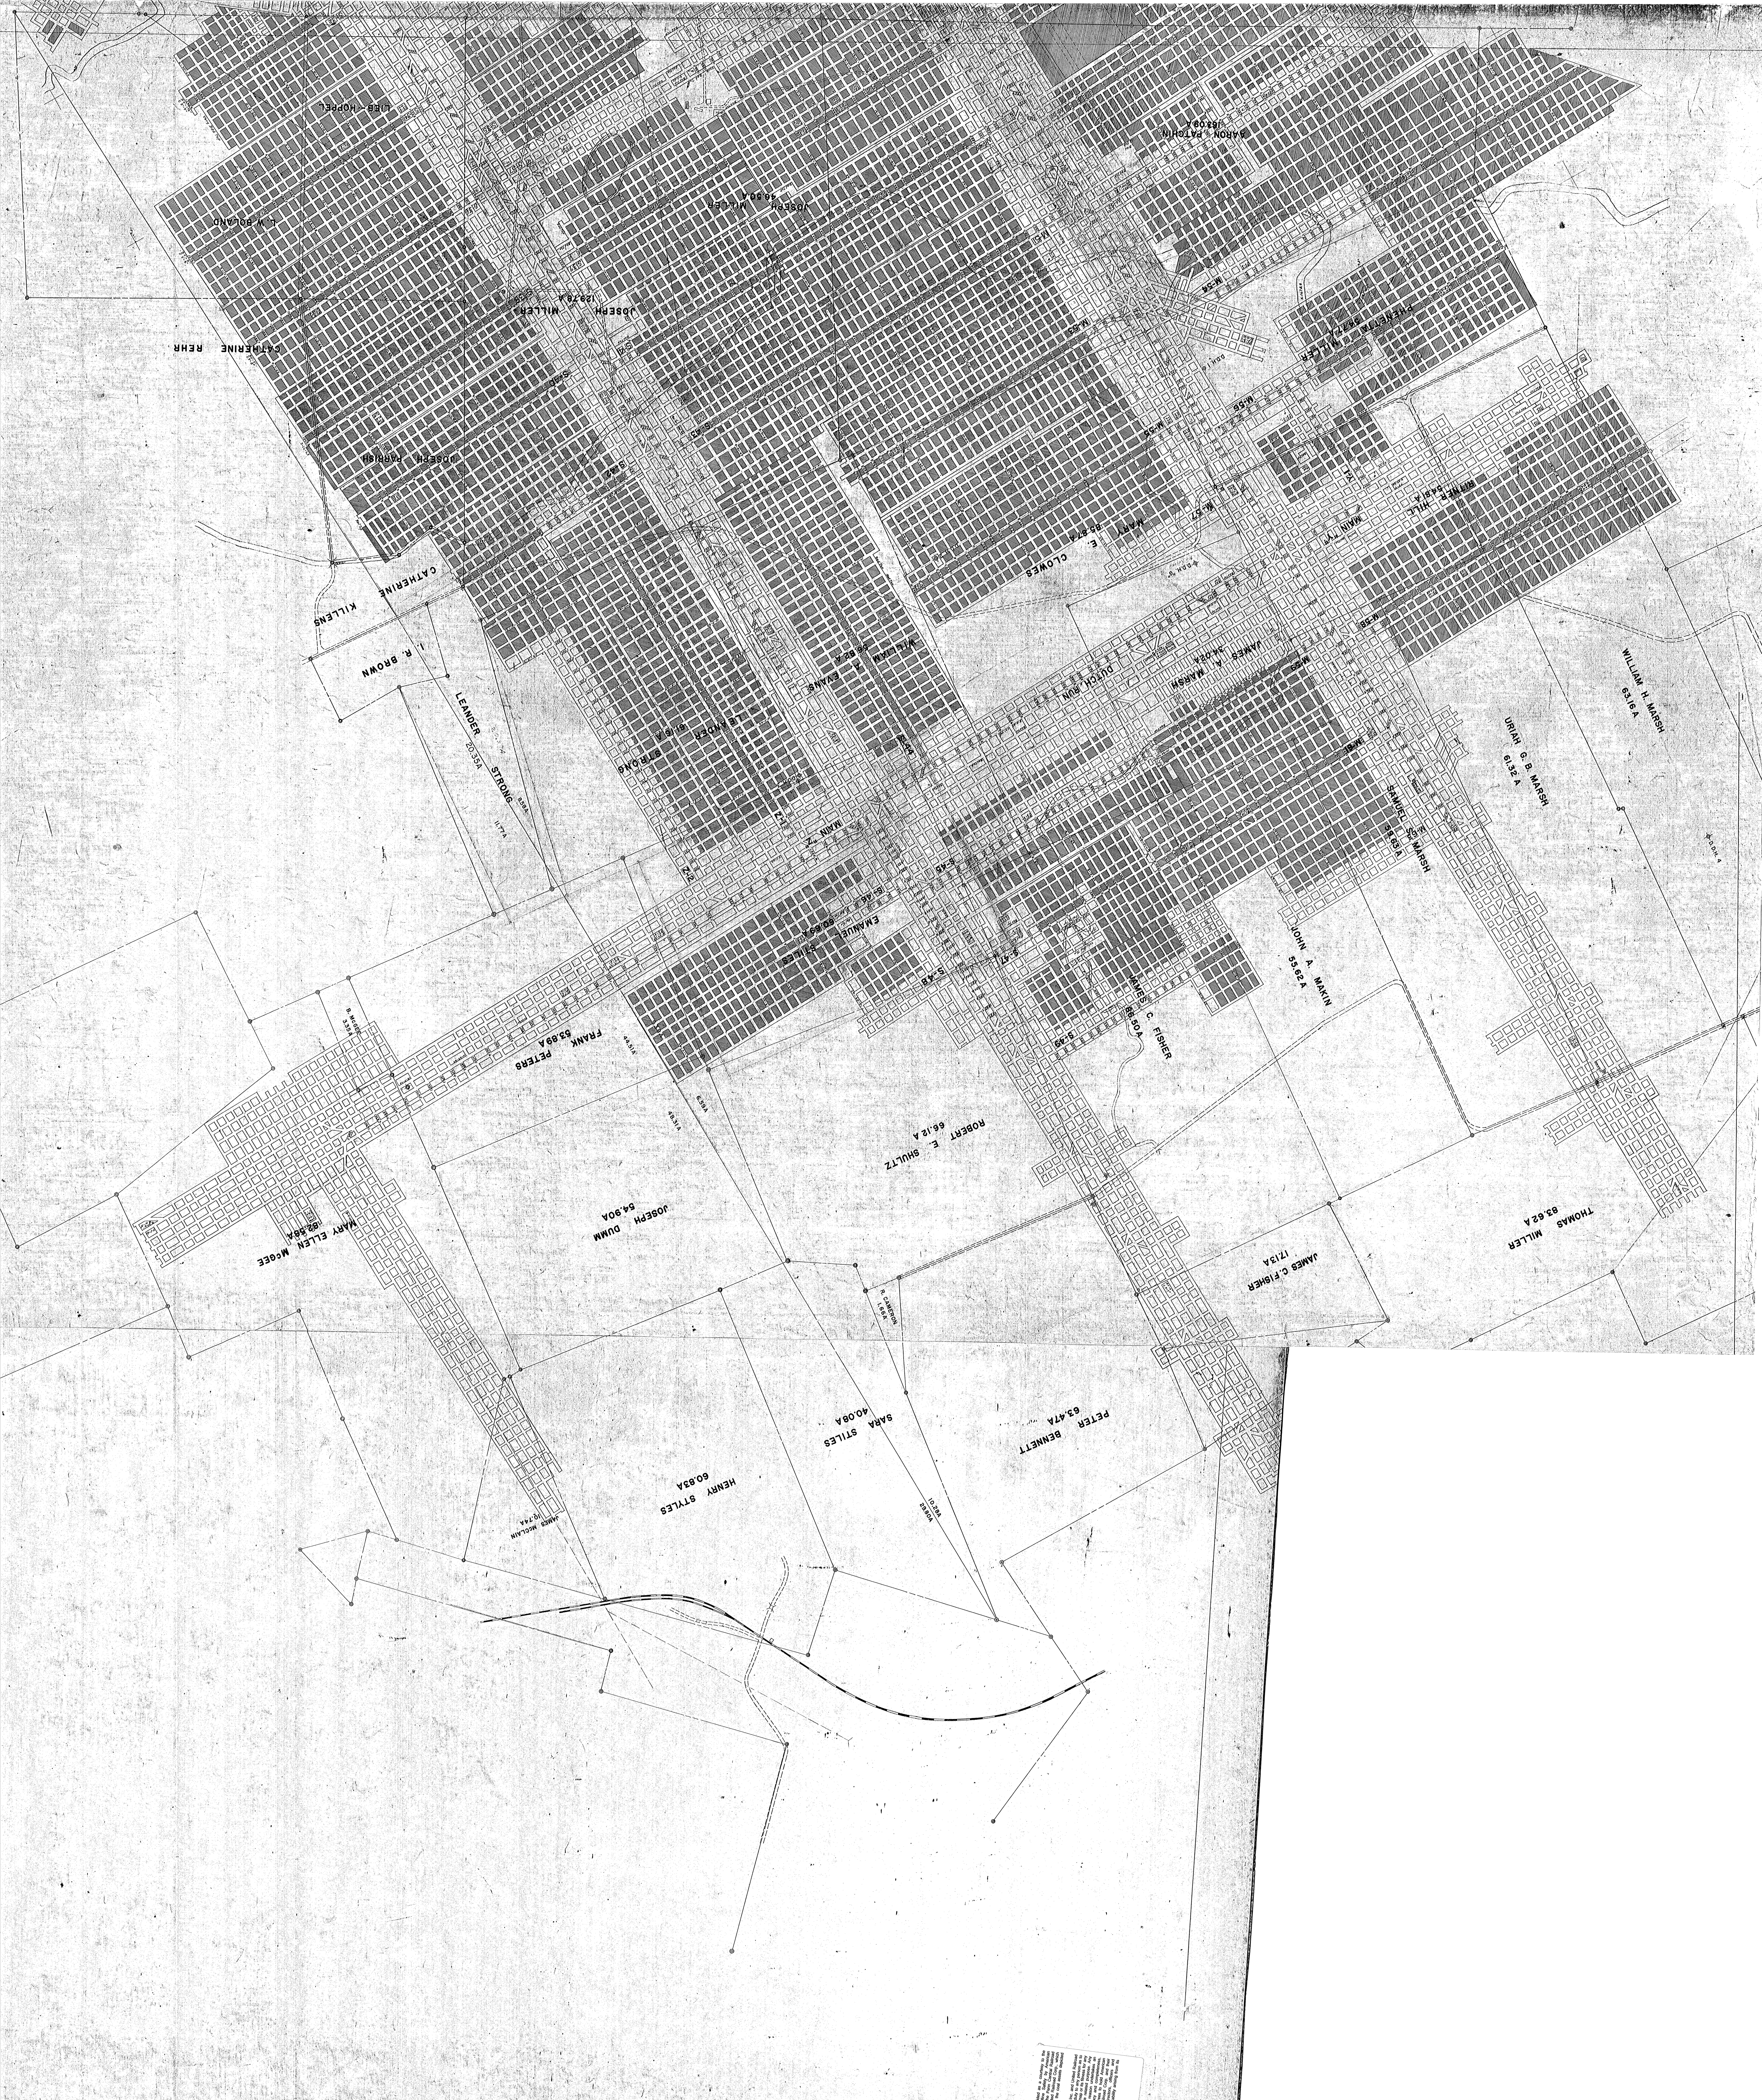
LIEB – HOPPEL
L. W. BOLAND
JOSEPH MILLER 46.50 A
AARON PATCHIN 163.09 A
JOSEPH MILLER 129.78 A
CATHERINE REHR
PHENETTA MILLER
JOSEPH PARRISH
RITNER HILL 54.81 A
MARY E. CLOWES 85.87 A
MAIN 'Y'
CATHERINE KILLENS
I. R. BROWN
WILLIAM A. EVANS 56.82 A
JAMES A. MARSH 34.02 A
DUTCH RUN
WILLIAM H. MARSH 63.16 A
URIAH G. B. MARSH 61.32 A
LEANDER STRONG 20.35A
LEANDER STRONG 61.6 A
8.58A
11.77A
MAIN 'Z'
Z-1
Z-2
SAMUEL S. MARSH 59.63A
EMANUEL STILES 60.65 A
JOHN A. MAKIN 55.62 A
JAMES C. FISHER 86.50A
B. McGEE 3.35A
FRANK PETERS 53.89A
44.51A
6.59A
48.31A
ROBERT E. SHULTZ 66.12 A
MARY ELLEN McGEE 82.58A
JOSEPH DUMM 54.90A
THOMAS MILLER 83.62 A
JAMES C. FISHER 17.13A
R. CAMERON 1.66A
SARA STILES 40.08A
PETER BENNETT 63.47A
HENRY STYLES 60.83A
10.28A
29.80A
JAMES McCLAIN 10.74A
M-51
M-53
M-54
M-55
M-56
M-57
M-58
M-59
M-61
S-34
S-35
S-36
S-37
S-38
S-40
S-41
S-42
S-43
S-44
S-45
S-46
S-47
S-48
S-49
D.D.H. 1
D.D.H. 4
D.D.H. 6

DISCLAIMER: This map is provided as a courtesy to the Pennsylvania Bureau of Deep Mine Safety by American Premier Underwriters, Inc. (f/k/a The Penn Central Railroad Corporation) and its subsidiary United Railroad Corp., which own or owned, but do not operate, the coal assets depicted hereon.

American Premier Underwriters, Inc. and United Railroad Corp. disclaim any representation or duty to any person as to the accuracy or completeness of this map or its fitness for any particular mining, safety or real estate related purpose. Any person who uses this map for any reason undertakes an independent duty to verify its accuracy and completeness, assumes all risks of its use, and agrees to hold American Premier Underwriters, Inc., United Railroad Corp. and their respective affiliates, shareholders, directors, officers and employees harmless from damage or liability arising from its use.