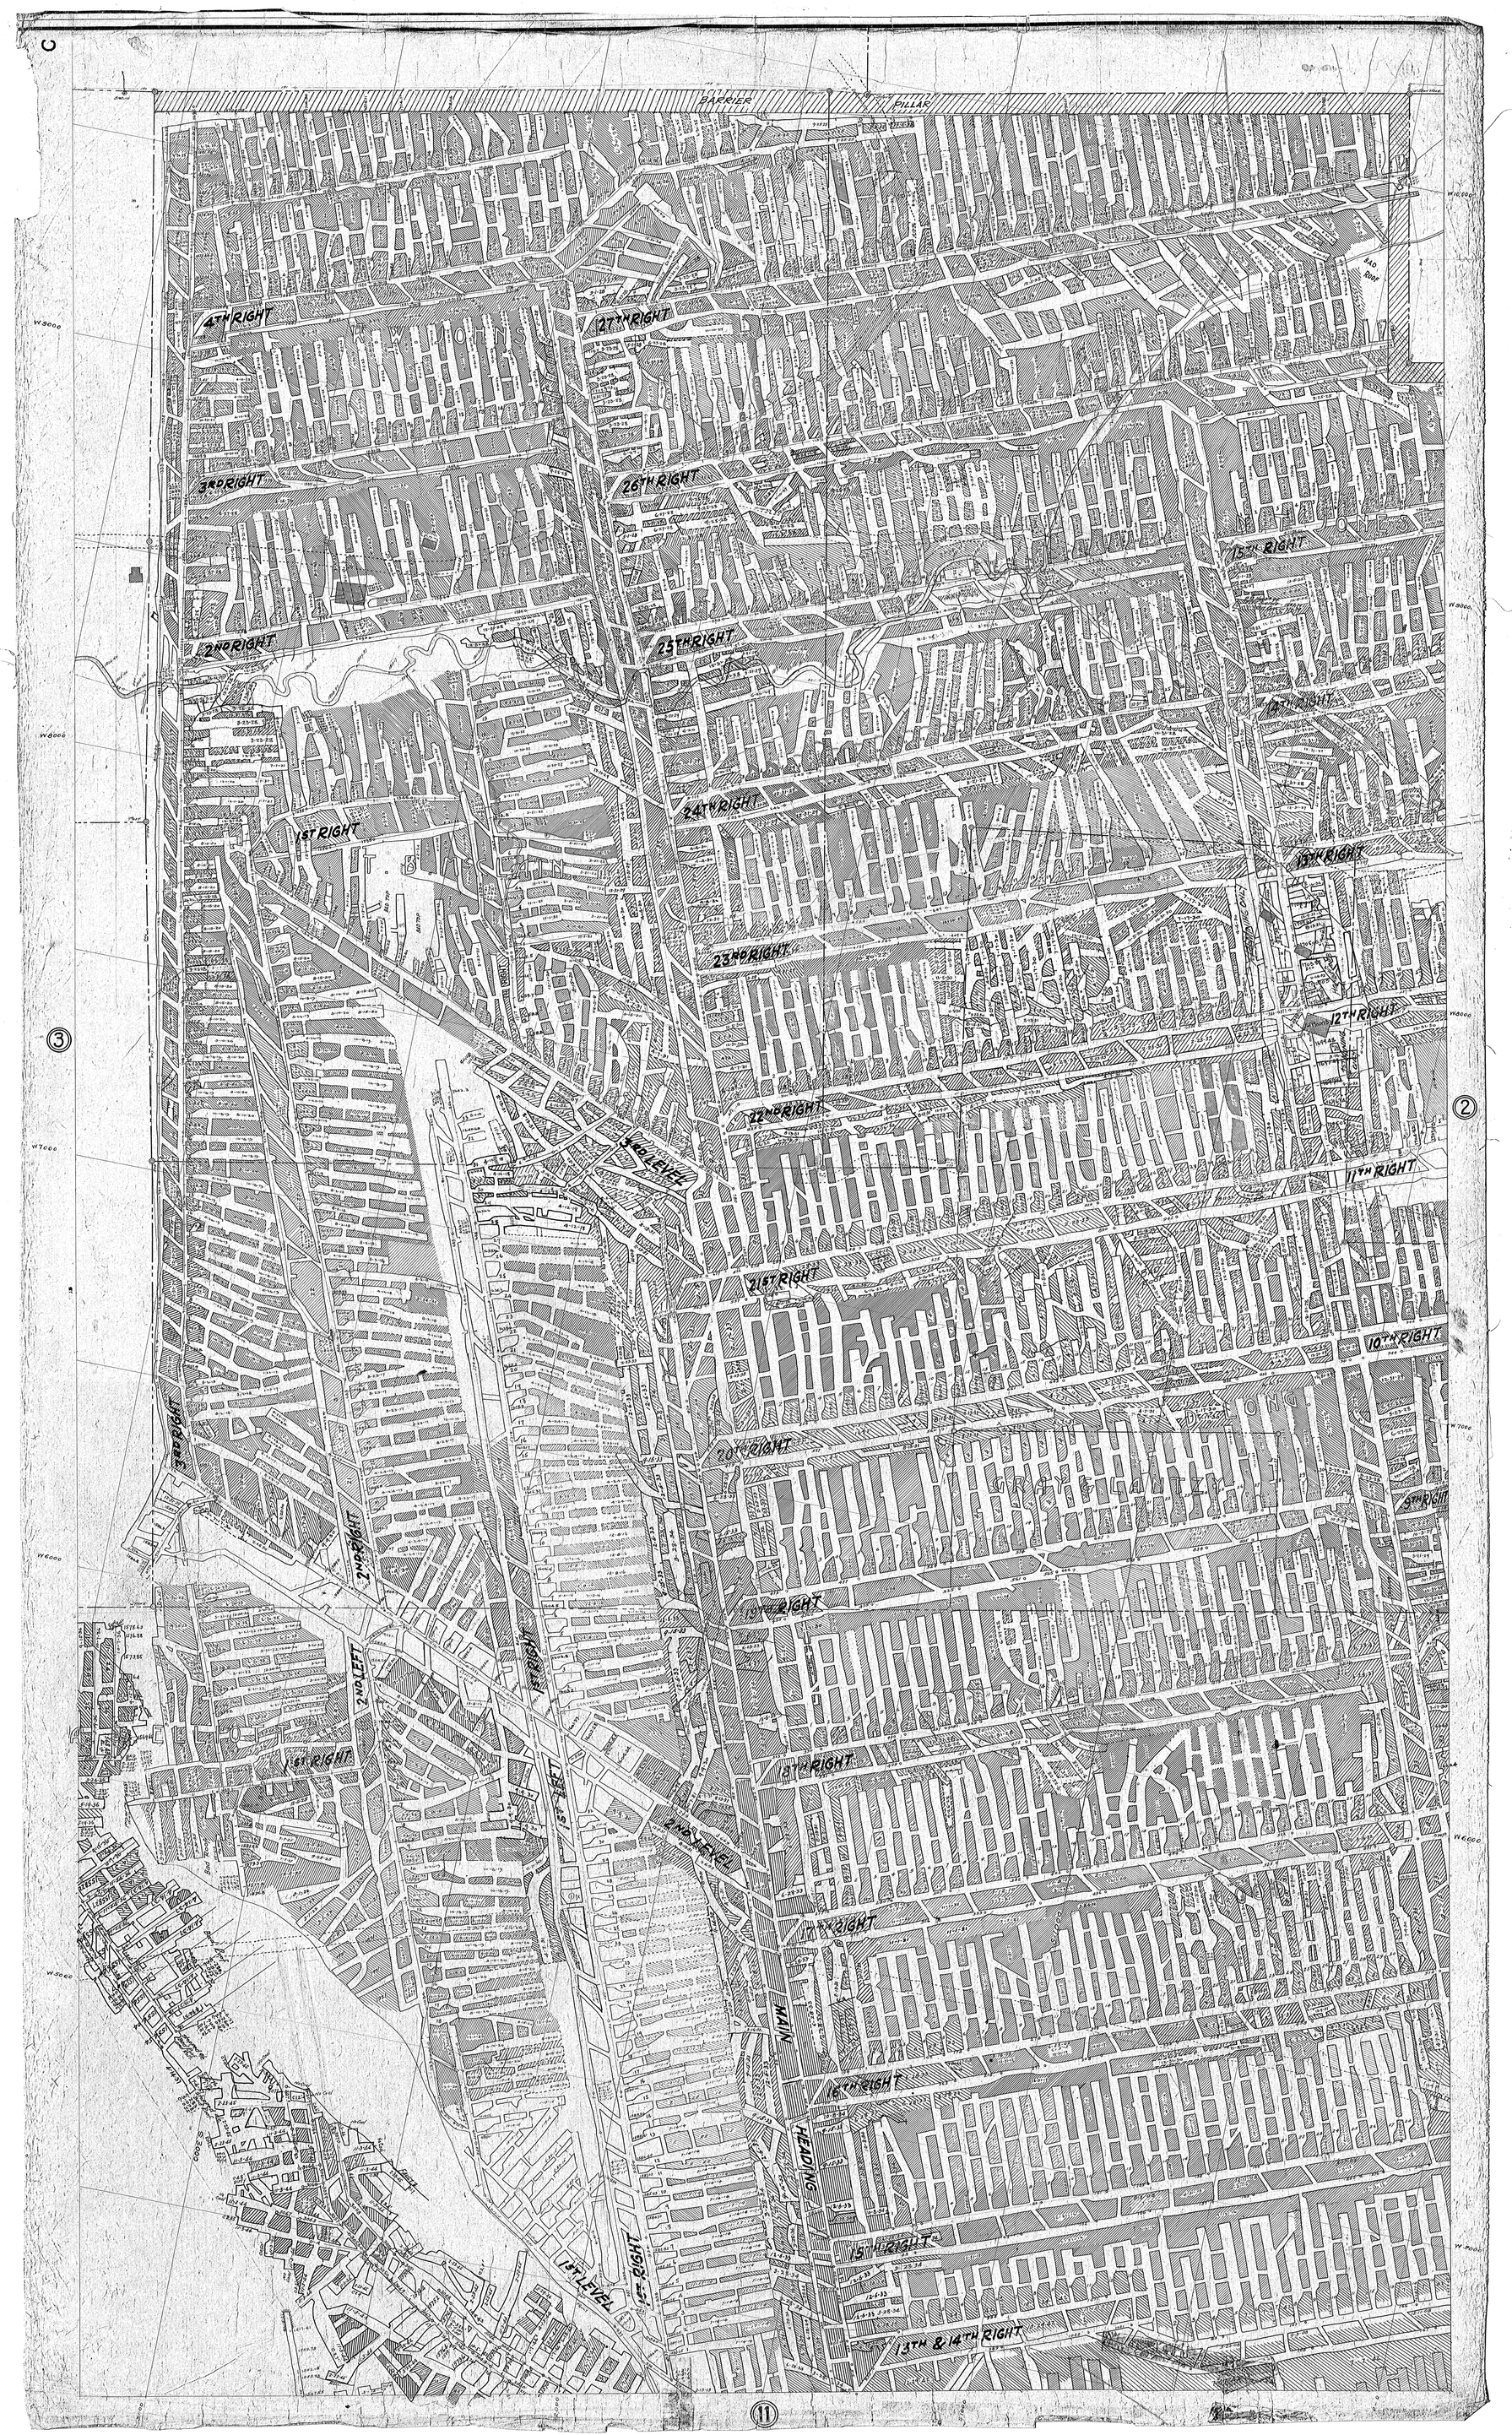

BARRIER
PILLAR
4TH RIGHT
27TH RIGHT
3RD RIGHT
26TH RIGHT
2ND RIGHT
25TH RIGHT
1ST RIGHT
24TH RIGHT
23RD RIGHT
22ND RIGHT
3RD LEVEL
21ST RIGHT
3RD RIGHT
2ND RIGHT
2ND LEFT
1ST RIGHT
1ST LEFT
2ND LEVEL
1ST LEVEL
MAIN
HEADING
20TH RIGHT
19TH RIGHT
18TH RIGHT
17TH RIGHT
16TH RIGHT
15TH RIGHT
14TH & 13TH RIGHT
13TH RIGHT
12TH RIGHT
11TH RIGHT
10TH RIGHT
9TH RIGHT
8TH RIGHT
7TH RIGHT
6TH RIGHT
5TH RIGHT
W.9000
W.8000
W.7000
W.6000
W.5000
W.4000
W.3000
W.10,000
RAD. ROOF
3
2
11