


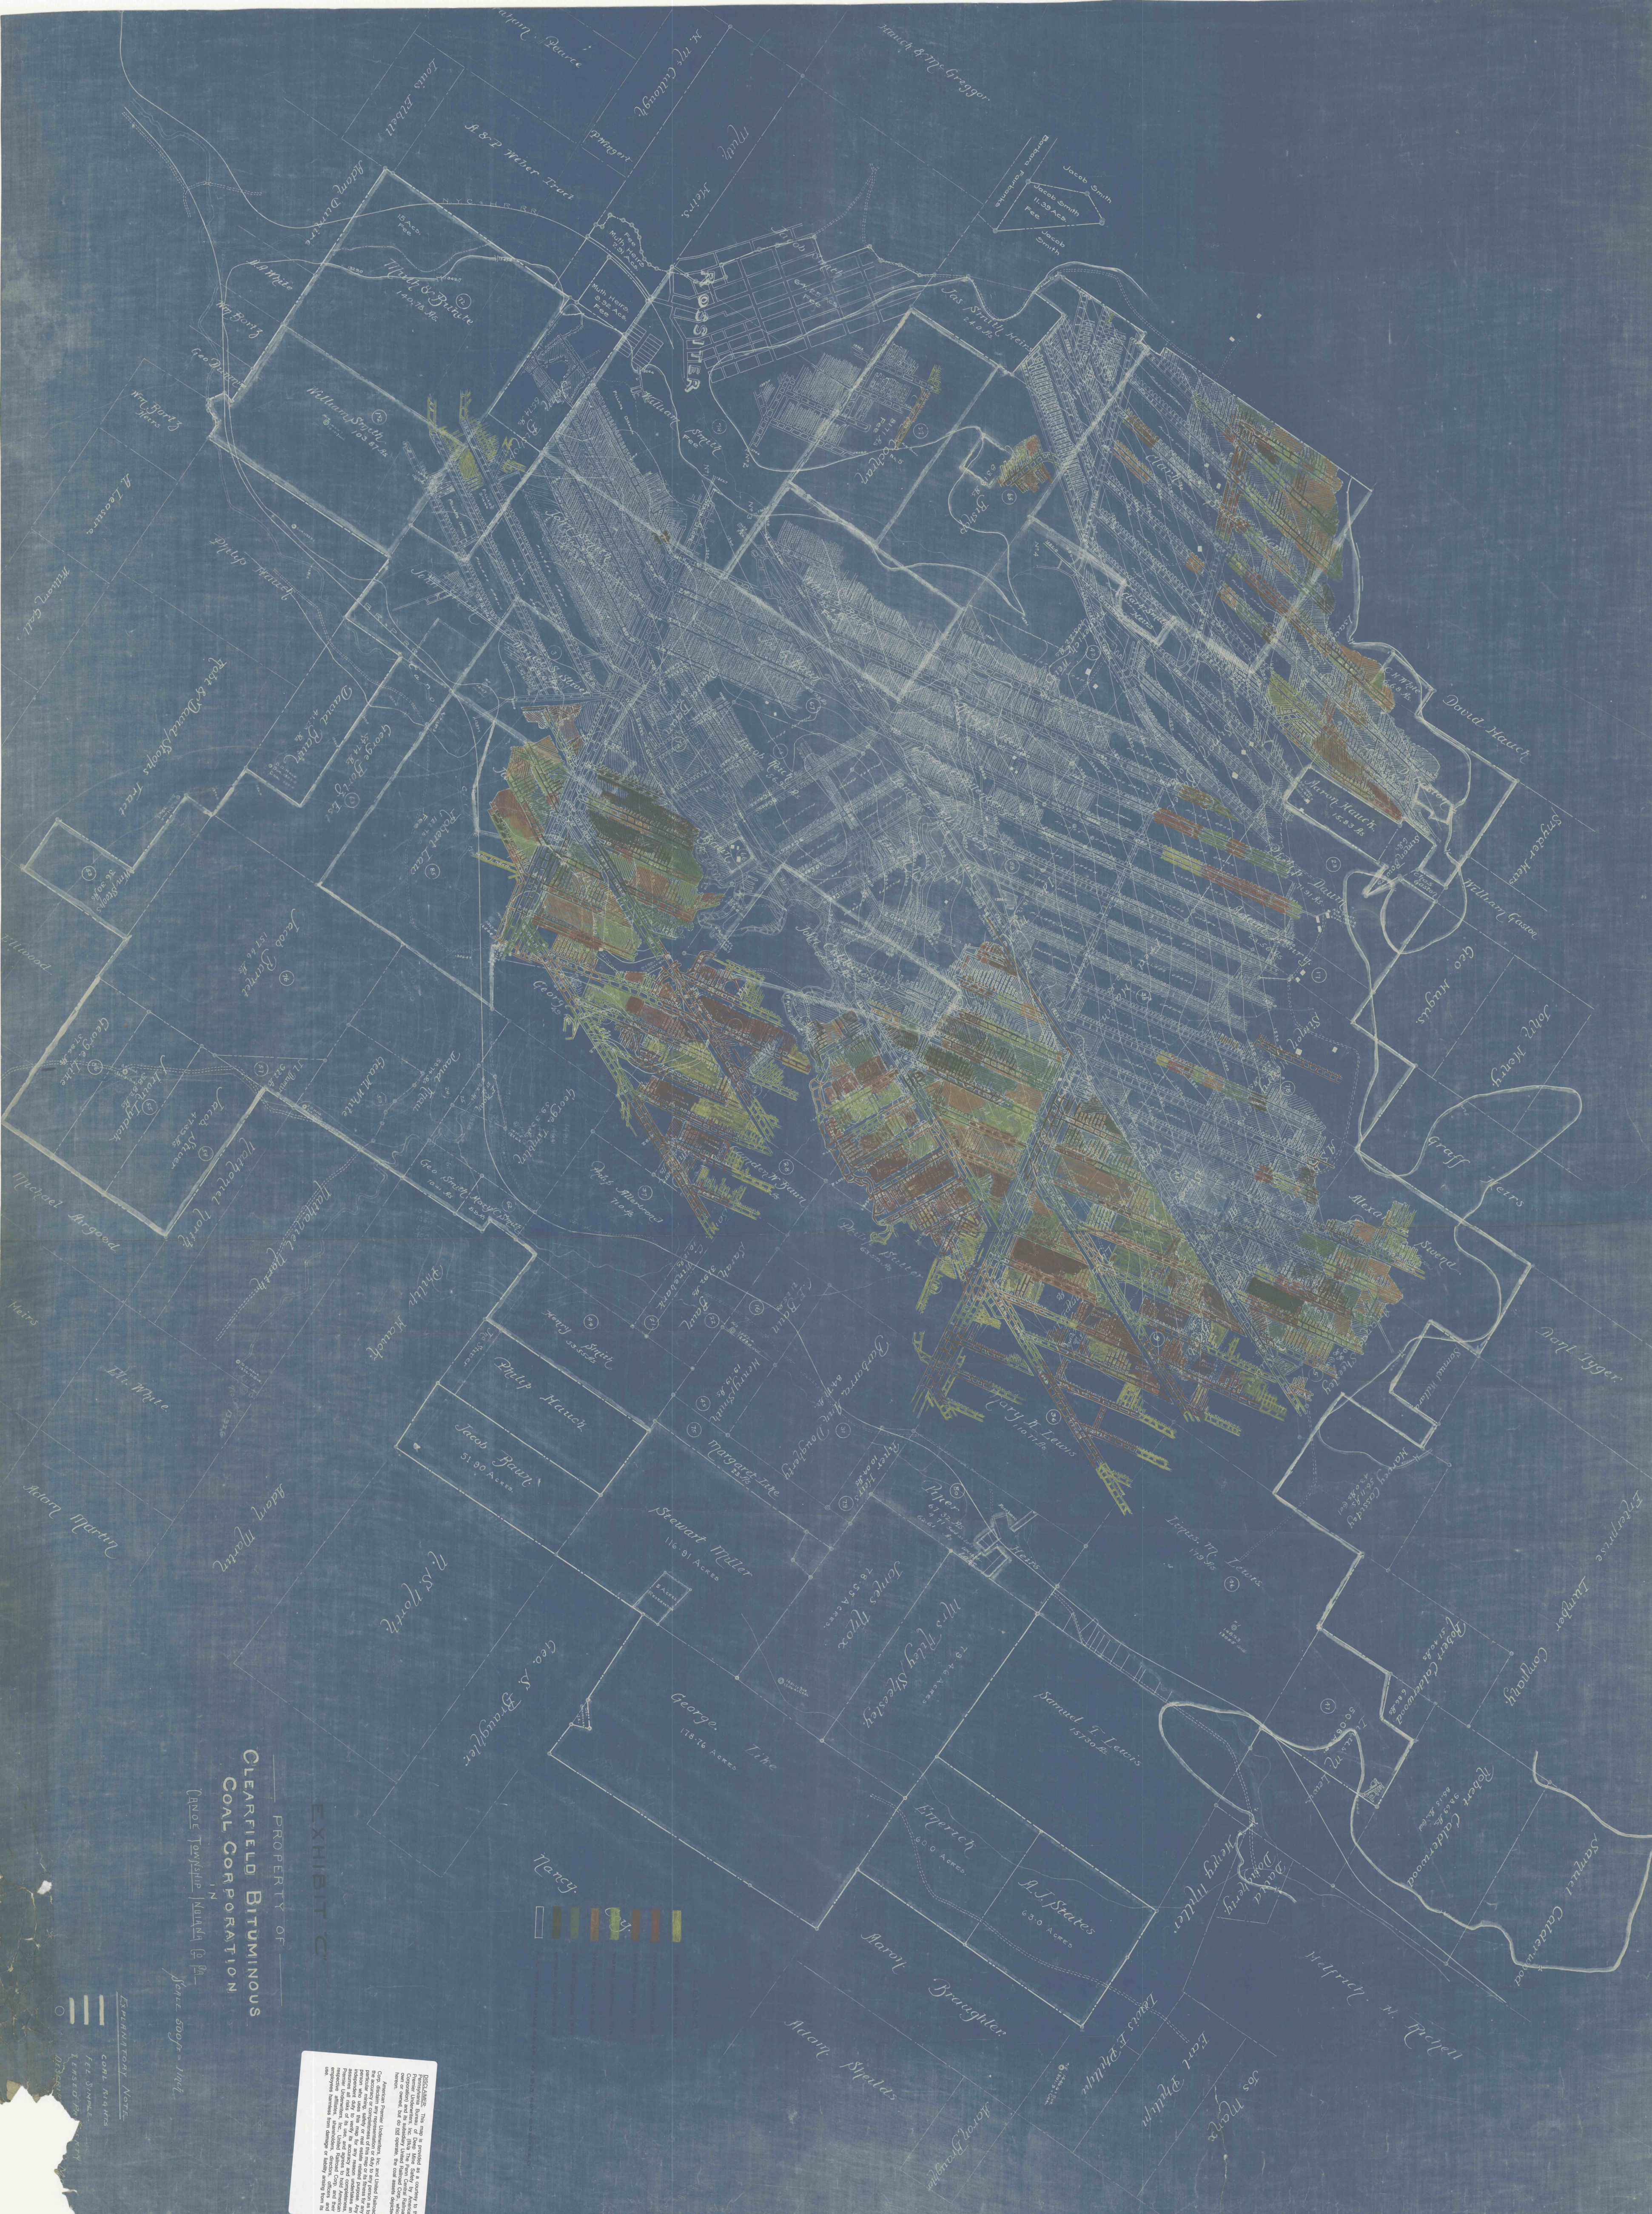


PROPERTY OF
**CLEARFIELD BITUMINOUS
COAL CORPORATION**

EXPLANATORY NOTE
COAL RIGHTS
[Symbol]
[Symbol]
[Symbol]