


ROSSITER FIELD-SHOWING STRIPPING ON
 ABE HENRY & I.W. & H.G. GASTON
 SCALE 1"=100' FINISHED DEC. 15, 1944.

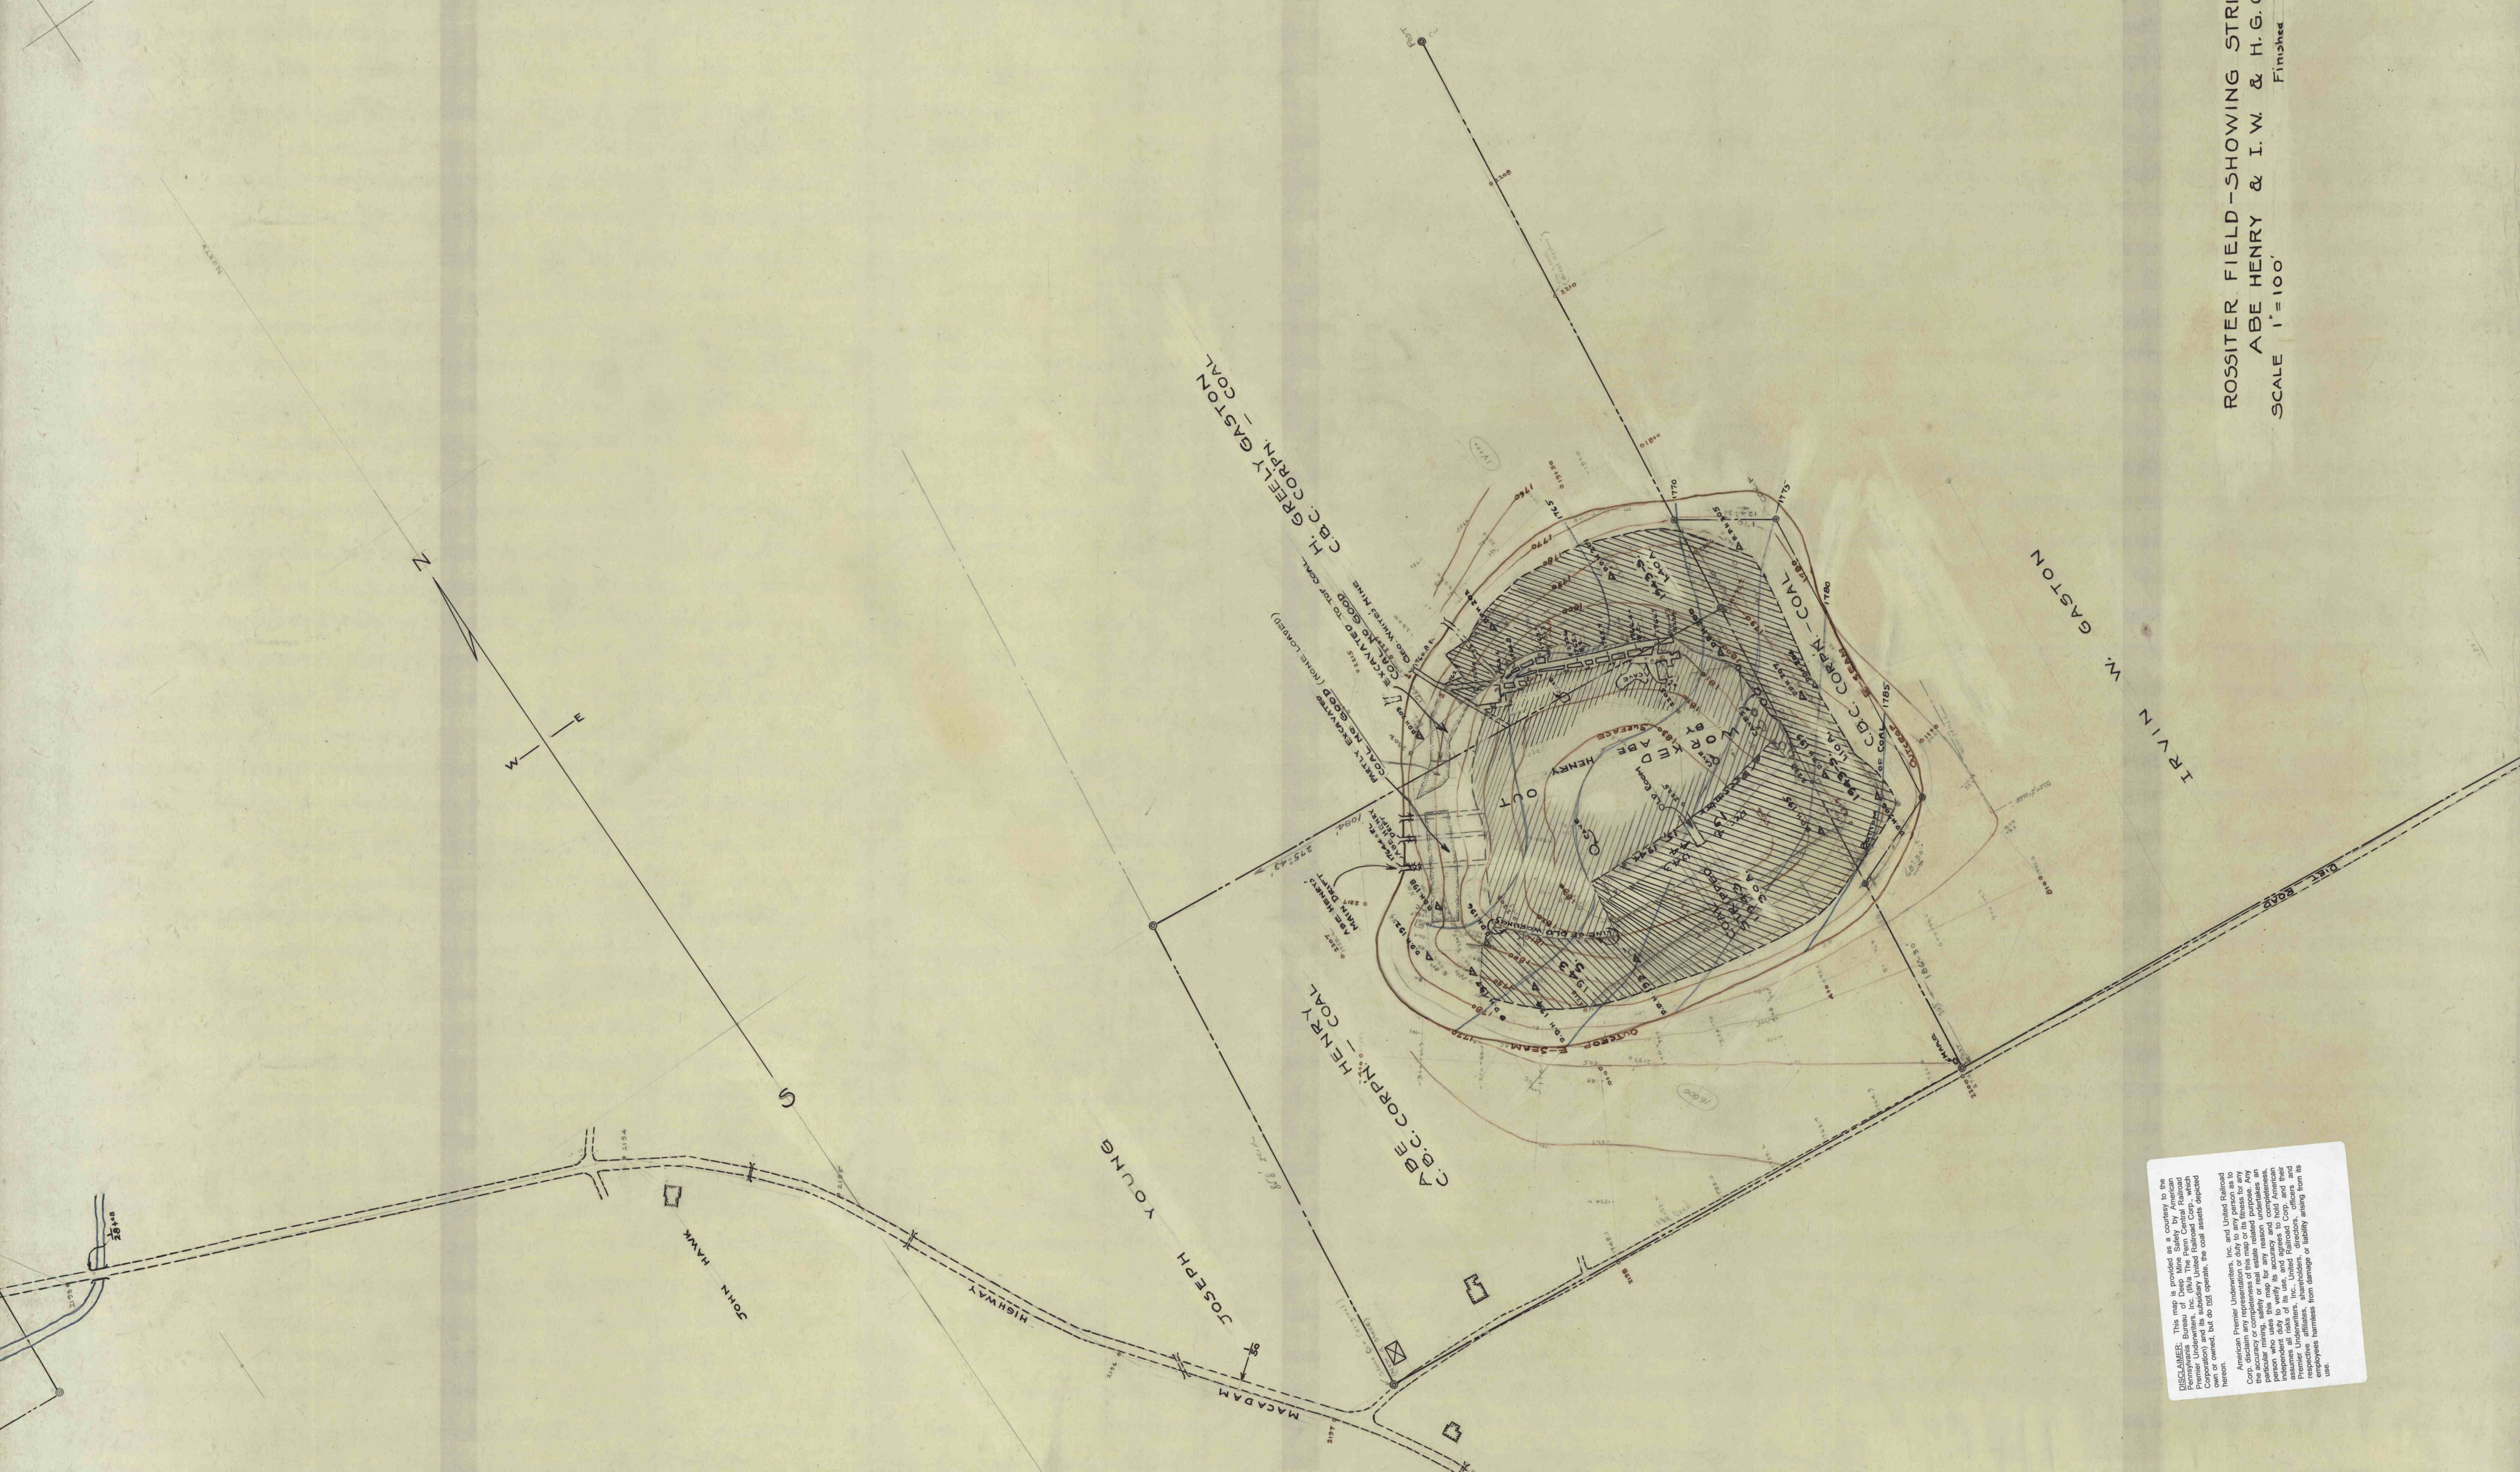

DRILL HOLES

1	1742.5	(No.)
2	1742.5	(No.)
