



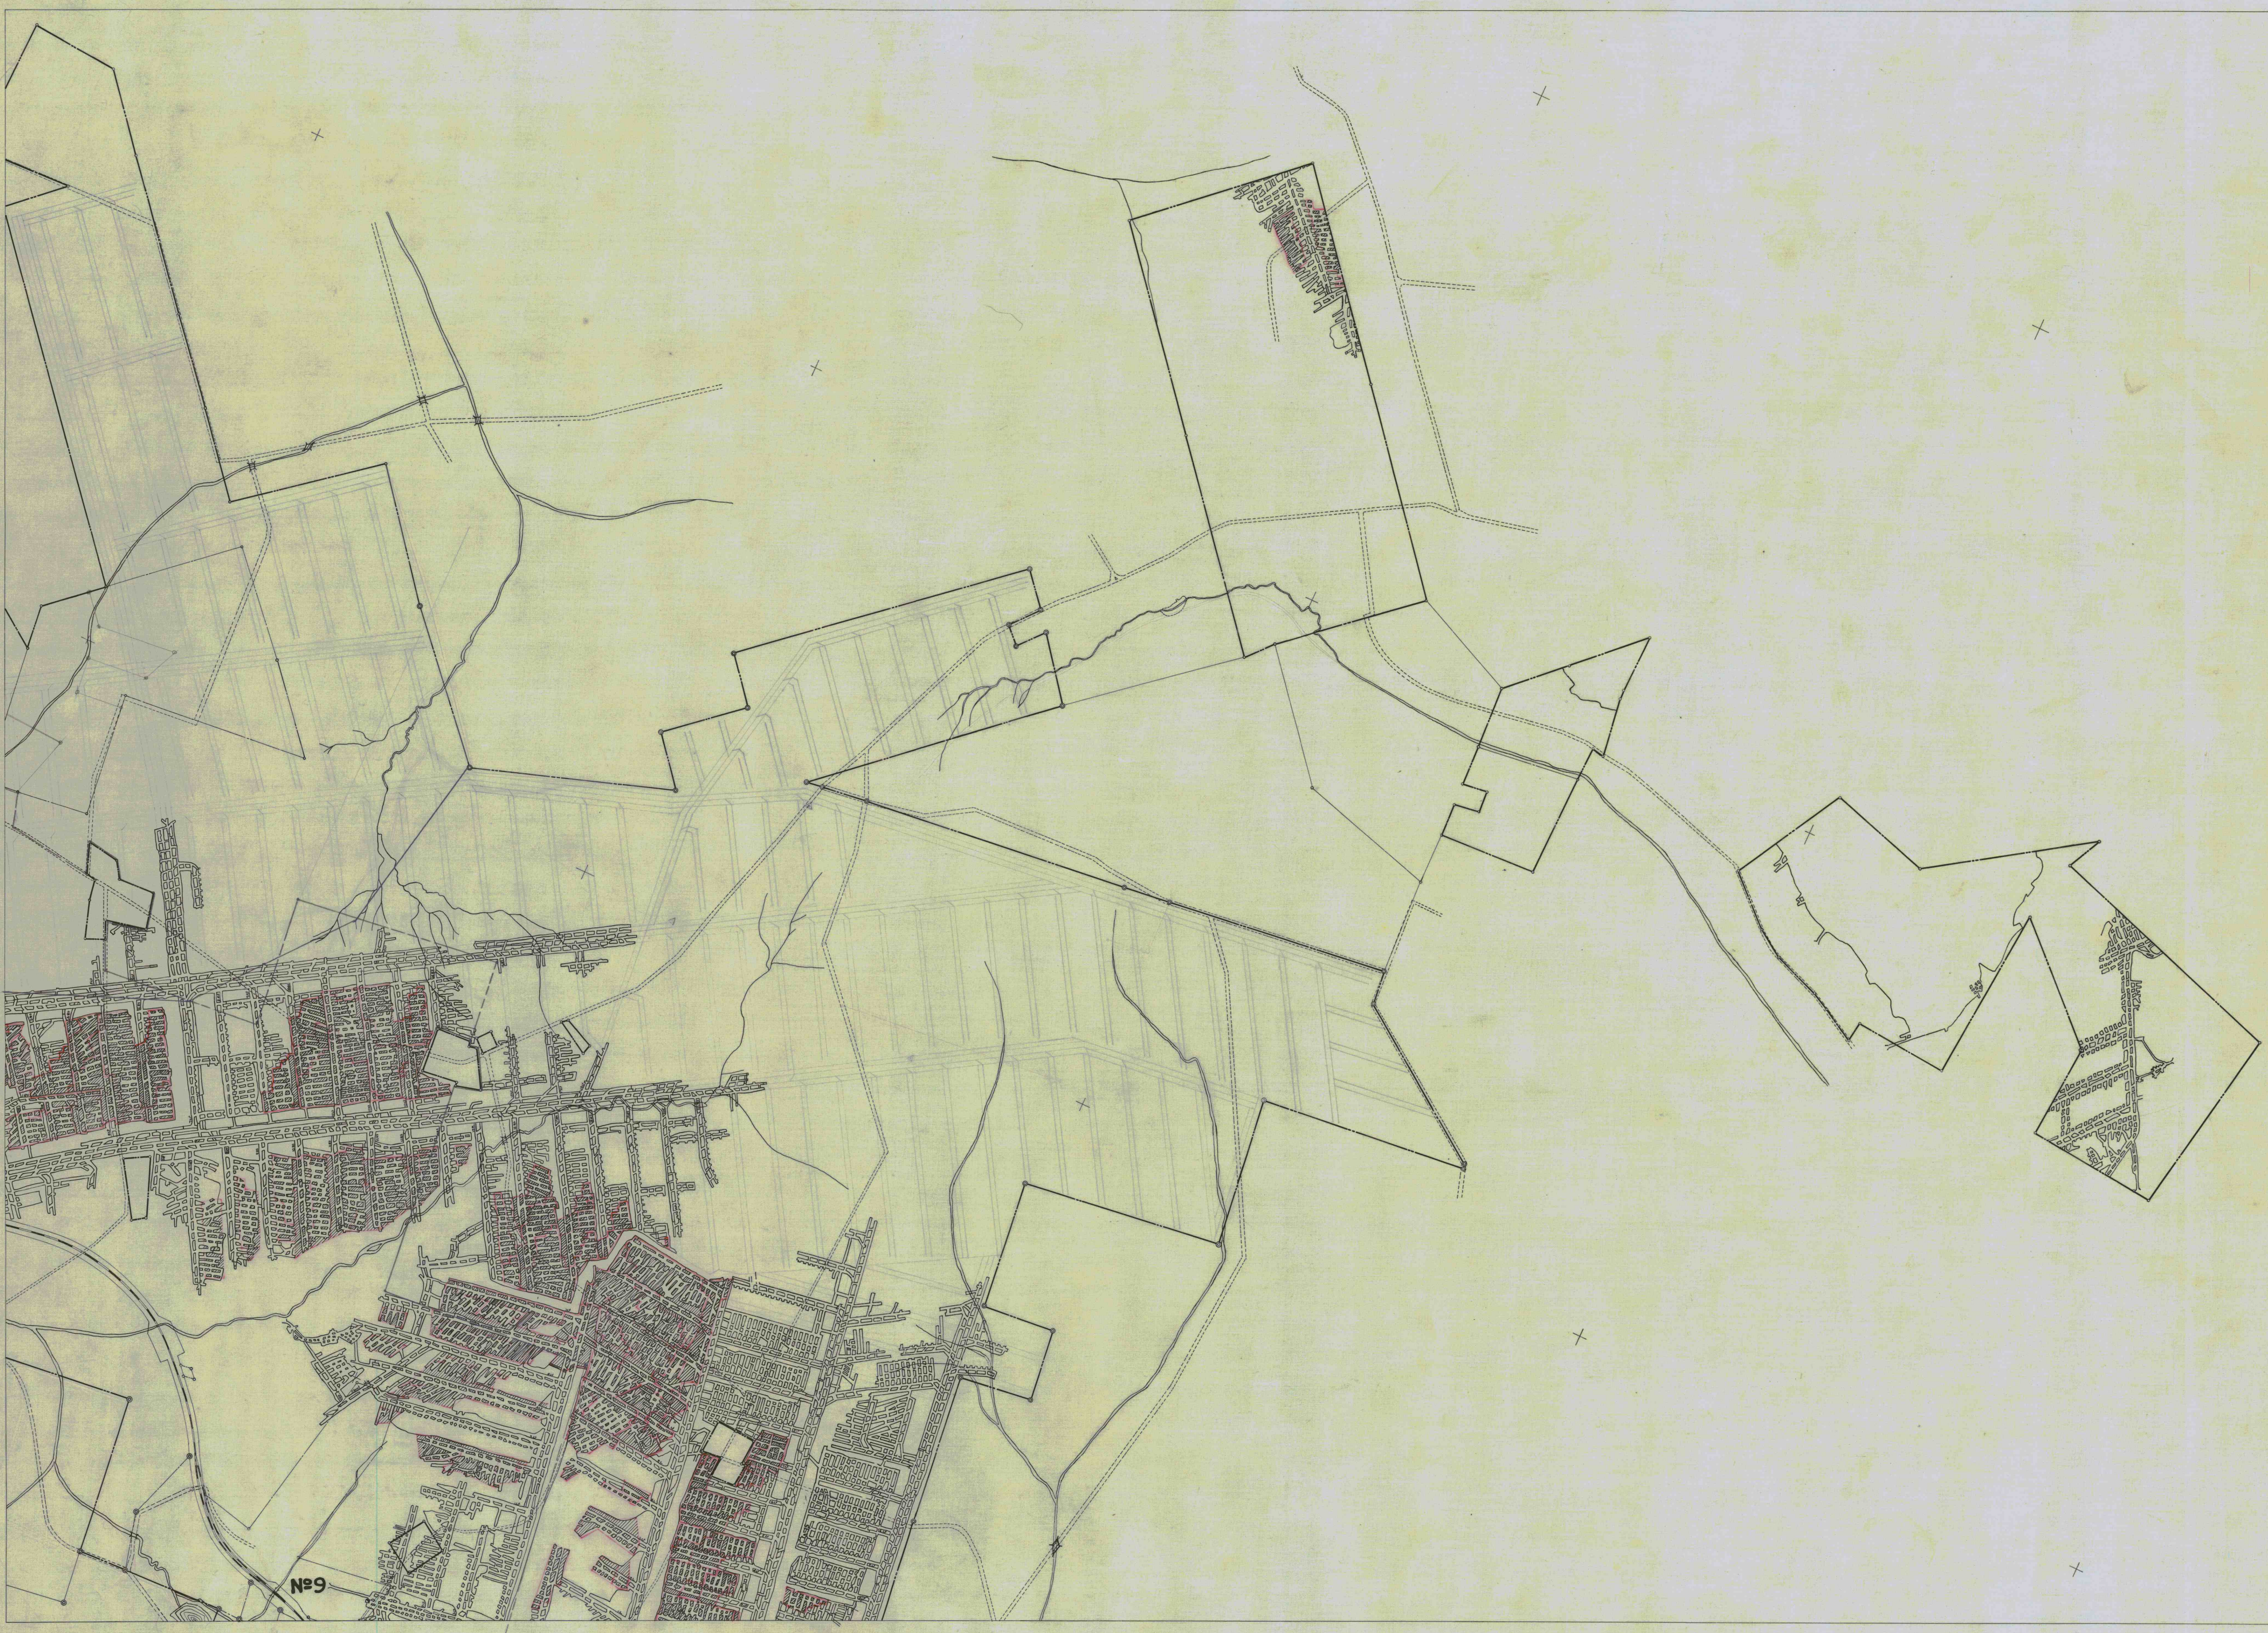

③

F.T. 10 N. 6

BOTTOM

Bottom

F.T. 10 N. 6