


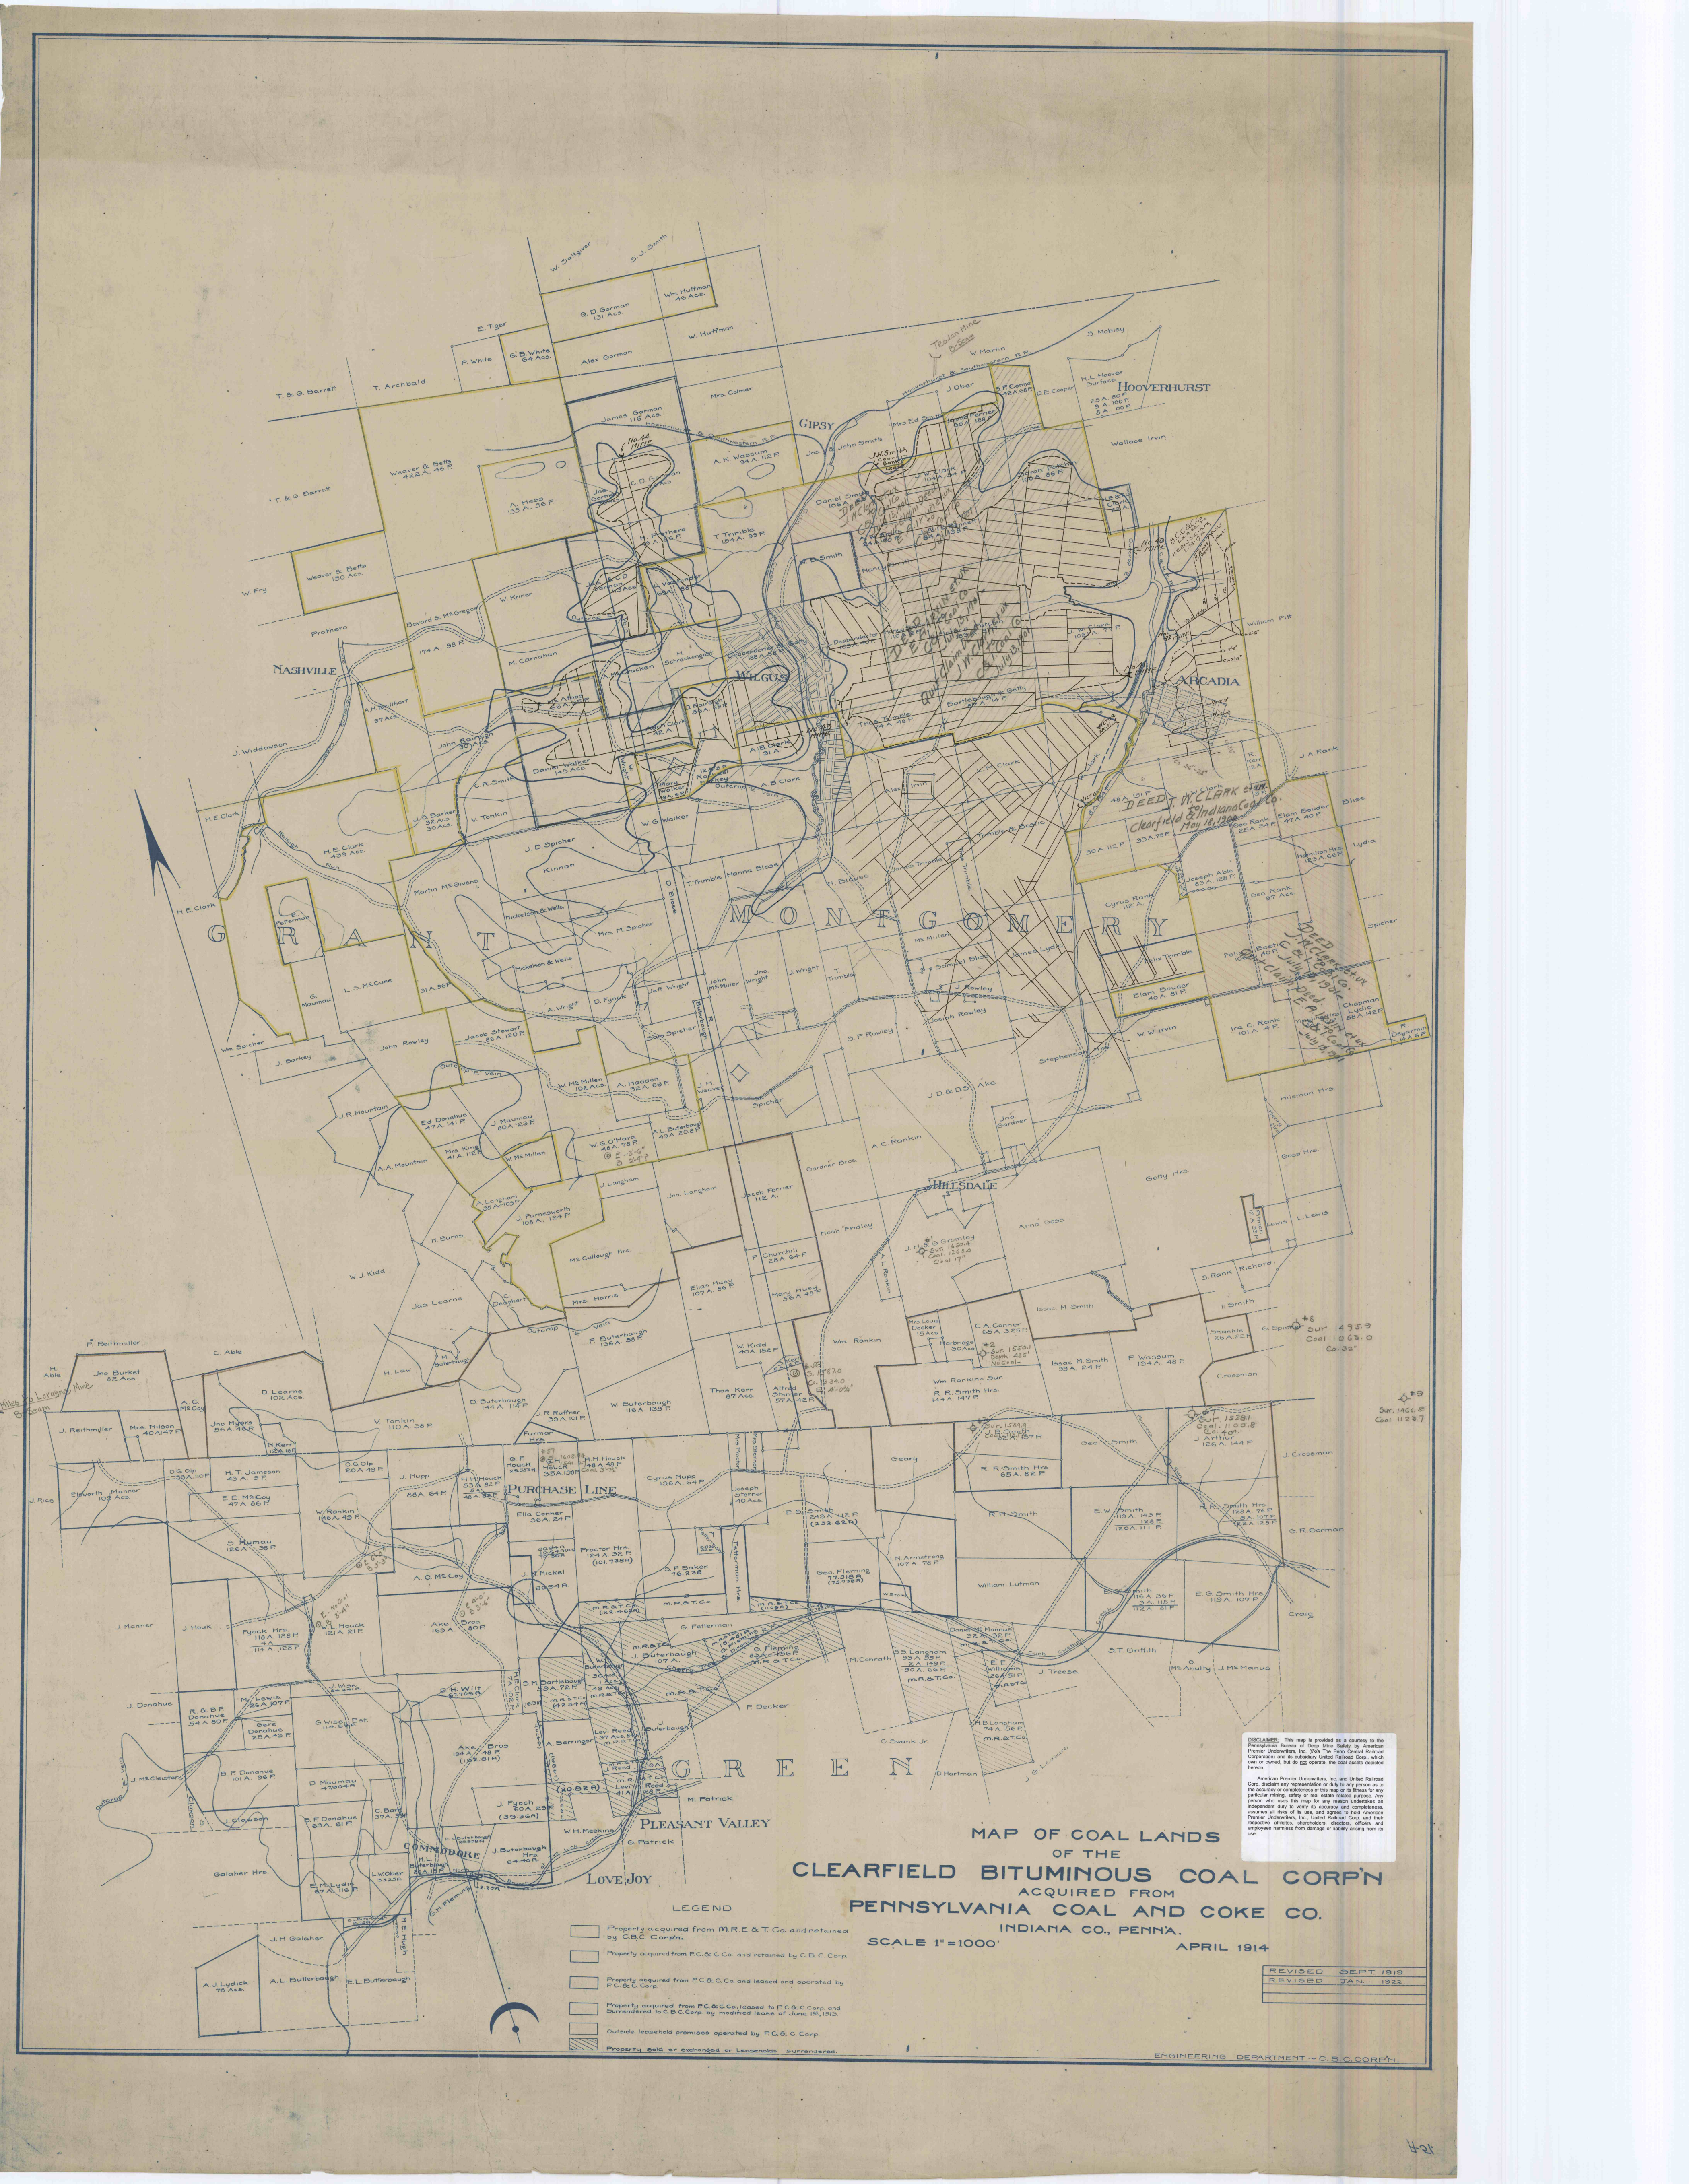

MAP OF COAL LANDS  
OF THE  
CLEARFIELD BITUMINOUS COAL CORP.  
ACQUIRED FROM  
PENNSYLVANIA COAL AND COKE CO.  
INDIANA CO., PENNA.

SCALE 1"=1000'  
APRIL 1914

- LEGEND
- Property acquired from M.R.E. & T. Co. and retained by C.B.C. Corp.
  - Property acquired from P.C. & C. Co. and retained by C.B.C. Corp.
  - Property acquired from P.C. & C. Co. and leased and operated by P.C. & C. Co.
  - Property acquired from P.C. & C. Co., leased to P.C. & C. Co. and surrendered to C.B.C. Corp. by modified lease of June 18, 1913.
  - Outside leasehold premises operated by P.C. & C. Co.
  - Property sold or exchanged or leasehold surrendered.

DISCLAIMER: This map is provided as a courtesy to the Pennsylvania Bureau of Deep Mine Safety by American Premier Underwriters, Inc. (the "Premier Underwriter") and its subsidiary United Railroad Corporation and its subsidiary United Coal Corporation, which own or control, but do not operate, the coal assets depicted herein.

American Premier Underwriters, Inc. and United Railroad Corporation disclaim any representation or duty to any person as to the accuracy or completeness of this map or its use for any particular mining, safety or real estate related purpose. Any person who uses this map for any reason undertakes an independent duty to verify its accuracy and completeness, assumes all risk of its use, and agrees to hold American Premier Underwriters, Inc., United Railroad Corporation and its subsidiary United Coal Corporation, their respective officers, shareholders, directors, officers and employees harmless from damage or liability arising from its use.

|                    |
|--------------------|
| REVISED SEPT. 1919 |
| REVISED JAN. 1922  |
|                    |
|                    |

ENGINEERING DEPARTMENT - C.B.C. CORP.