


American Premier Underwriters, Inc. and United Railroad Corp. disclaim any representation or duty to any person as to the accuracy or completeness of this map or its fitness for any particular mining, safety or real estate related purpose. Any person who uses this map for any reason undertakes an independent duty to verify its accuracy and completeness, assumes all risks of its use, and agrees to hold American Premier Underwriters, Inc., United Railroad Corp. and their respective affiliates, shareholders, directors, officers and employees harmless from damage or liability arising from its use.

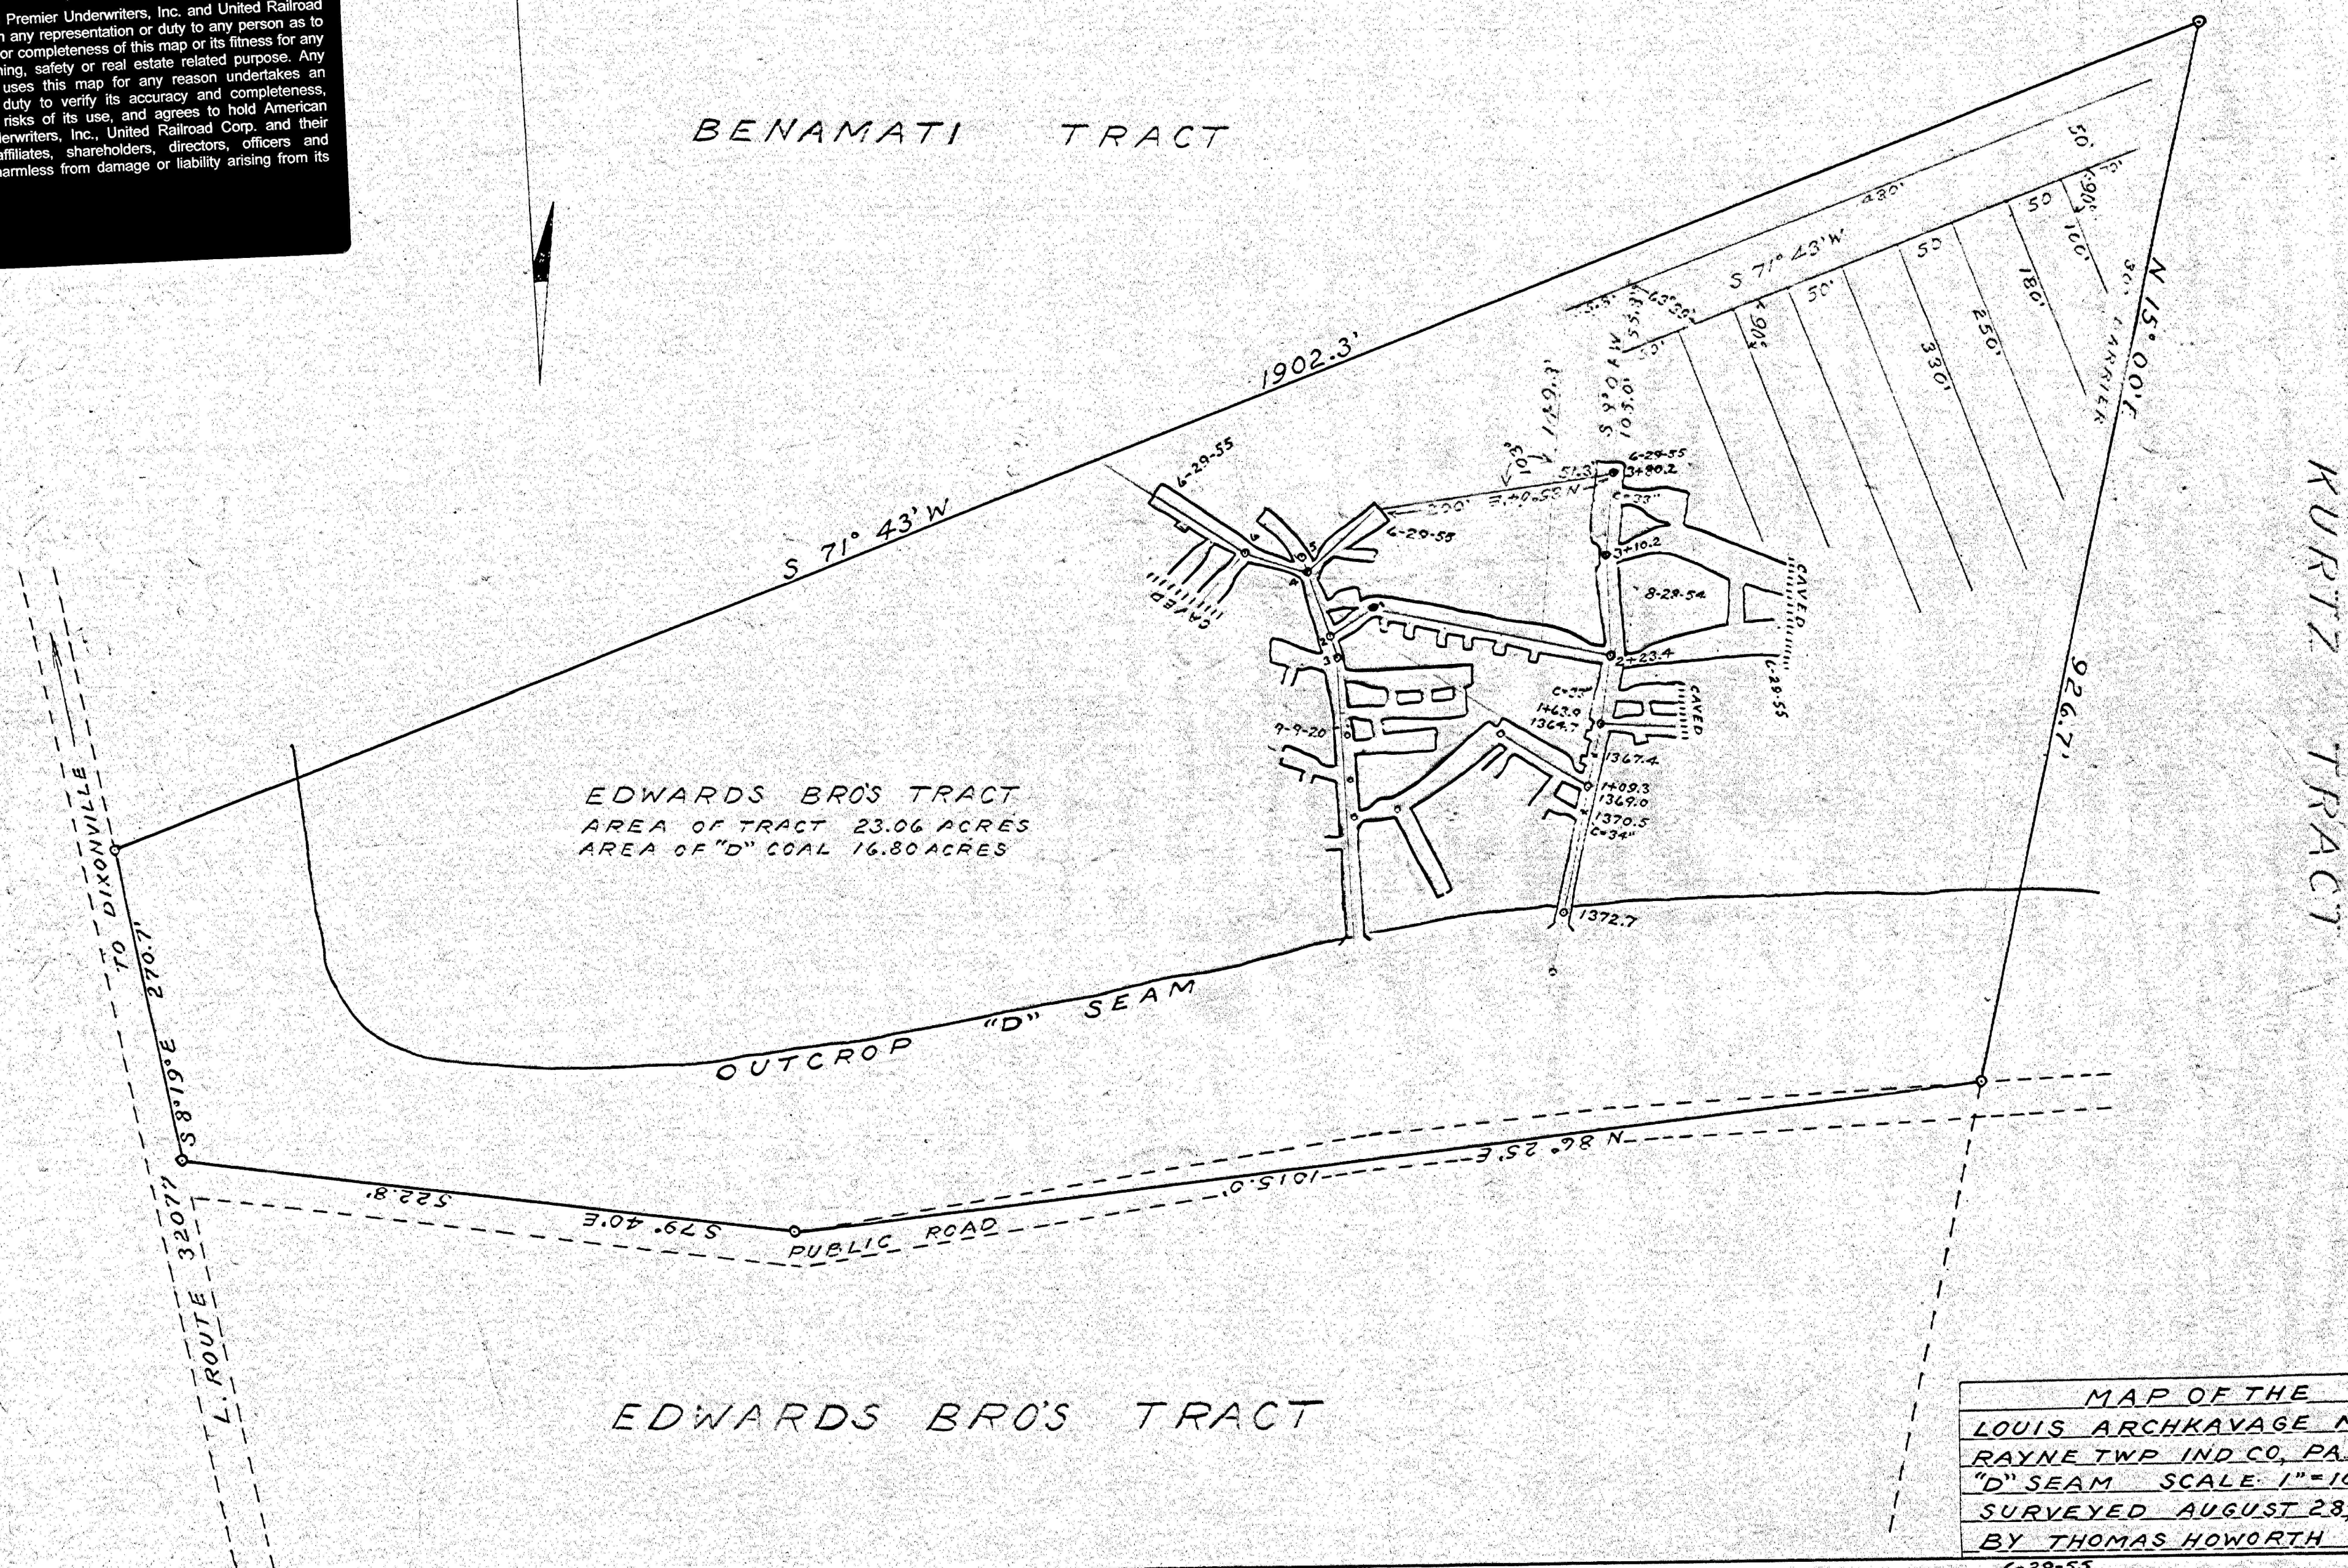

MAP OF THE
LOUIS ARCHKAVAGE MINE
RAYNE TWP IND CO, PA
"D" SEAM SCALE 1"=100'
SURVEYED AUGUST 28, 1954
BY THOMAS HOWORTH

6-29-55