


RE VARGO
SERLY JOS MILTON GIBSON

L. O. WIDDOWSON-COAL

GEORGE POFSO
FORMERLY HIRAM

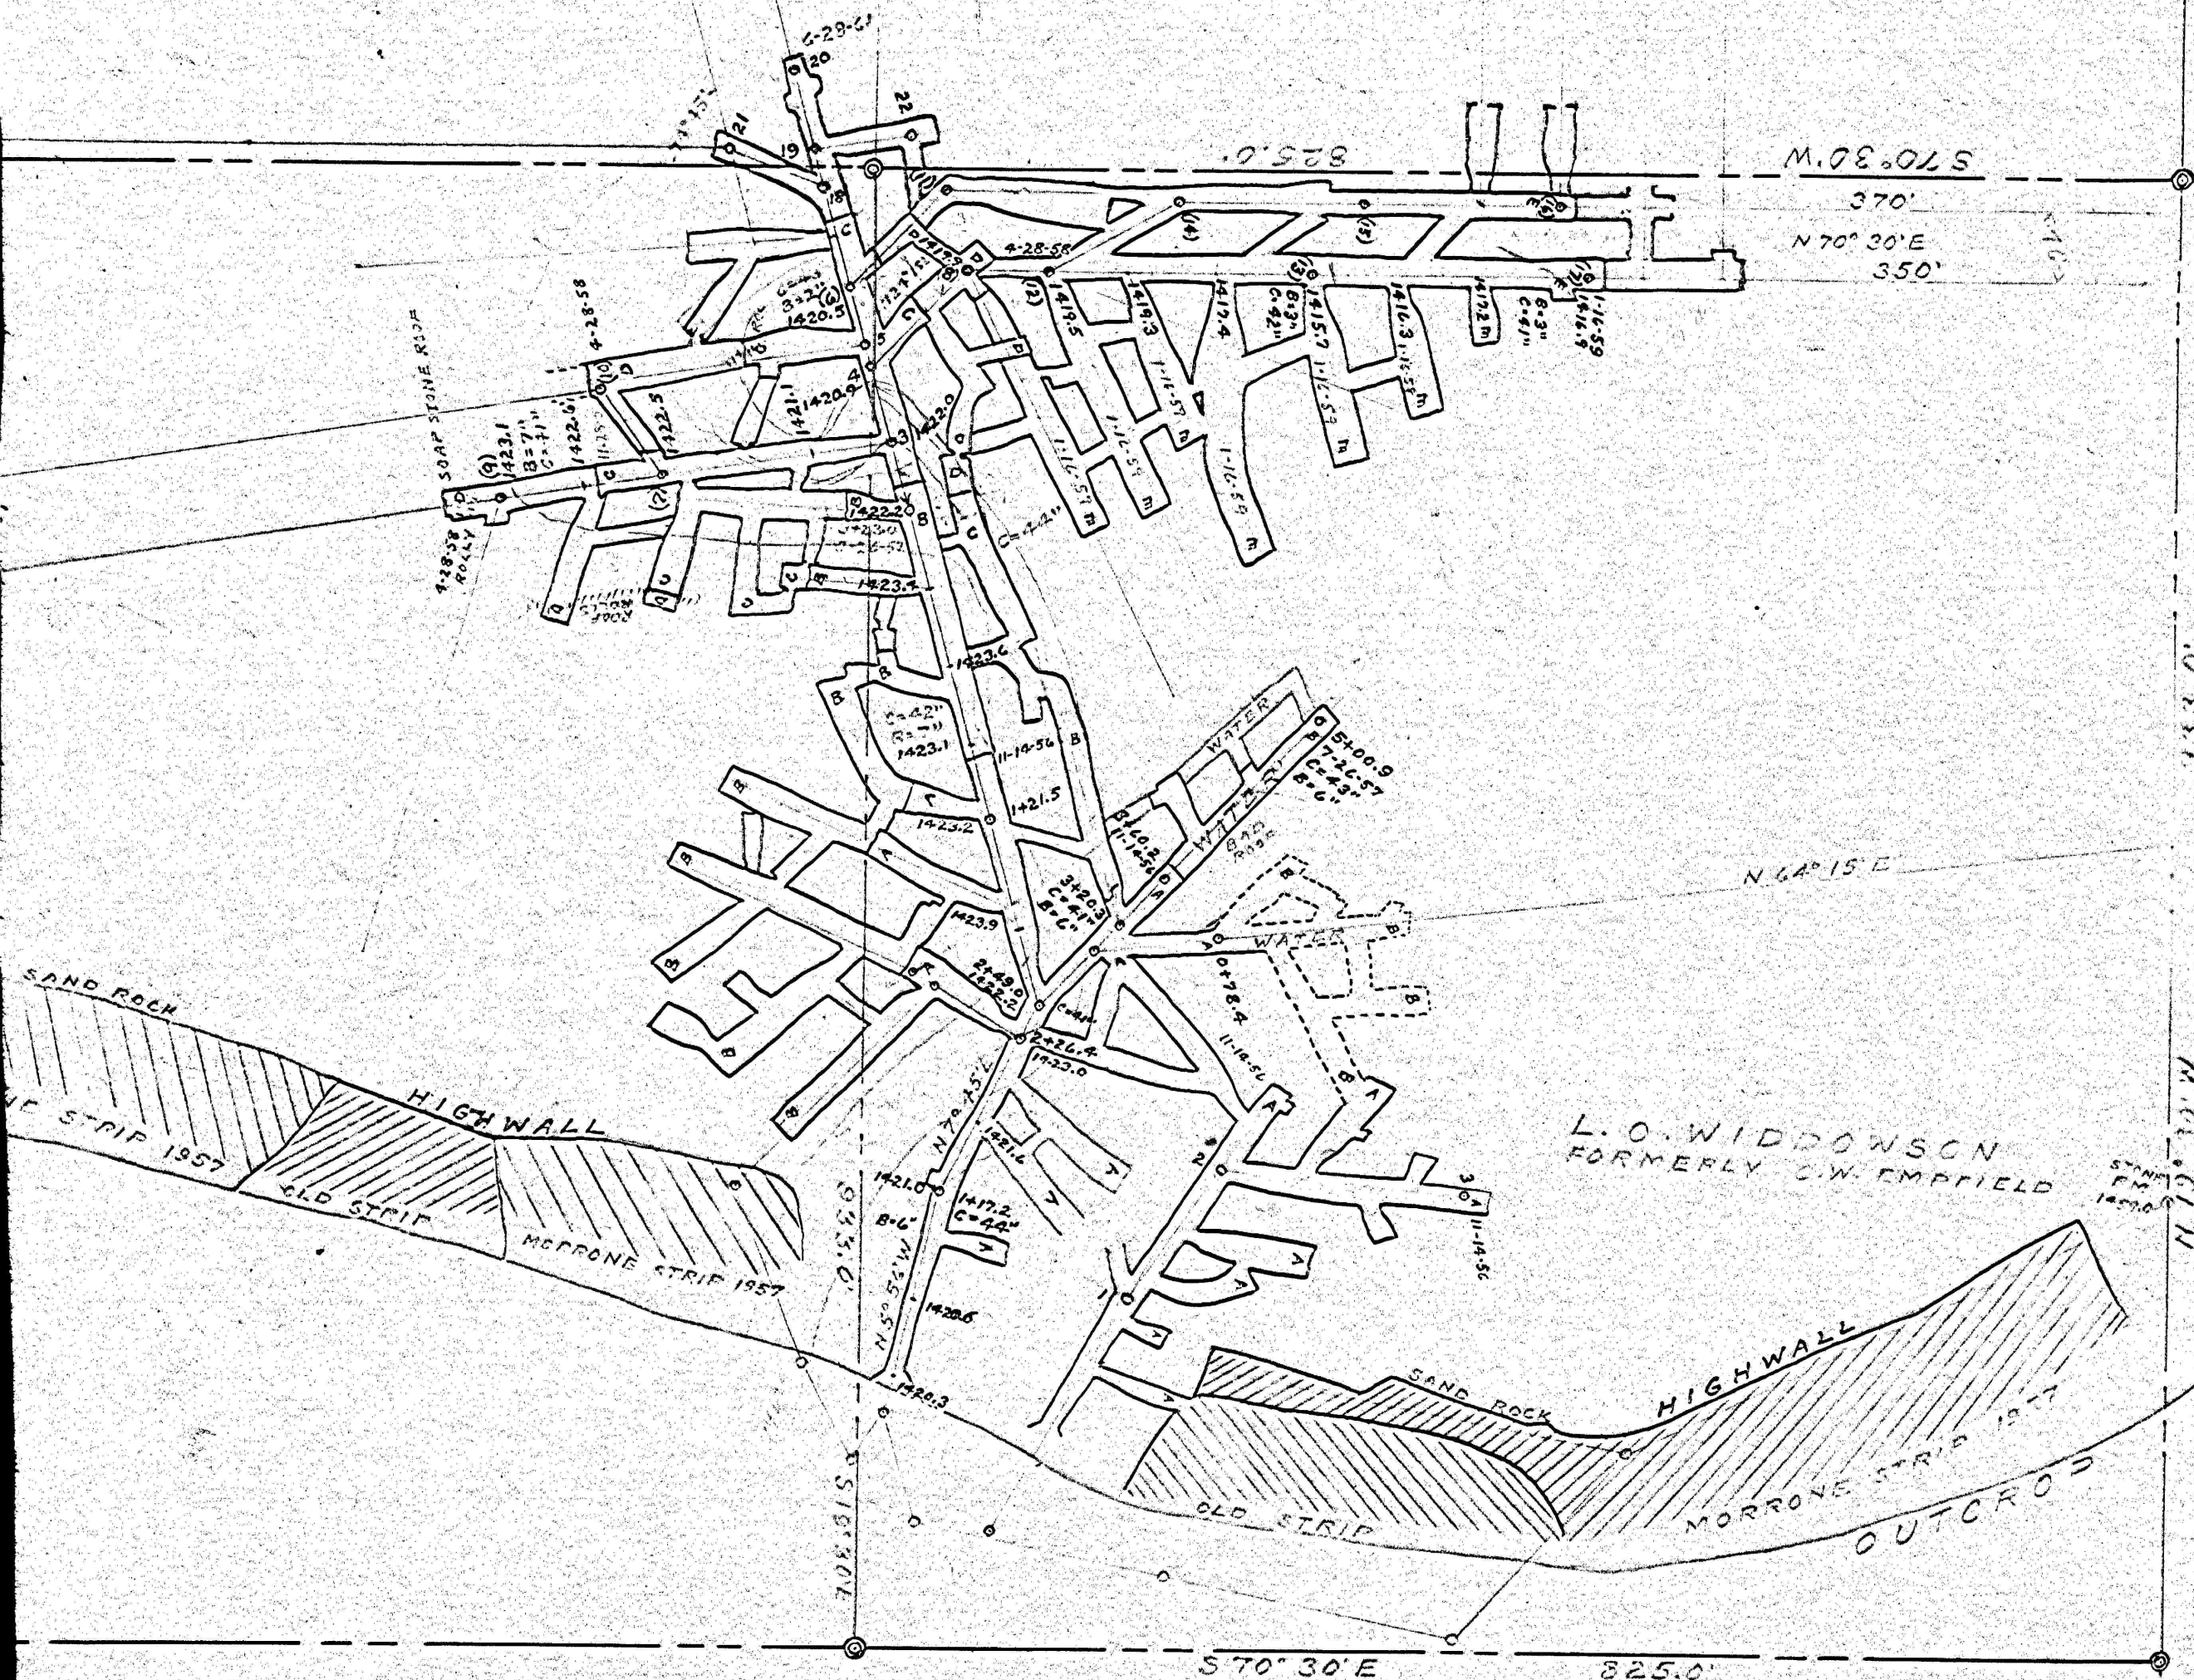

DISCLAIMER: This map is provided as a courtesy to the Pennsylvania Bureau of Deep Mine Safety by American Premier Underwriters, Inc. (*f/k/a* The Penn Central Railroad Corporation) and its subsidiary United Railroad Corp., which own or owned, but do not operate, the coal assets depicted thereon.

American Premier Underwriters, Inc. and United Railroad Corp. disclaim any representation or duty to any person as to the accuracy or completeness of this map or its fitness for any particular mining, safety or real estate related purpose. Any person who uses this map for any reason undertakes an independent duty to verify its accuracy and completeness, assumes all risks of its use, and agrees to hold American Premier Underwriters, Inc., United Railroad Corp. and their respective affiliates, shareholders, directors, officers and employees harmless from damage or liability arising from its use.


- SAND ROCK
- HIGH WALL
- OLD STRIP
- MCCRONE STRIP 1957
- NEW STRIP 1957

A road is shown on the right side, with a 'B' marker. A north arrow is in the top right corner.

L. O. WIDDOWSON
FORMERLY C.W. EMPFIELD

PRIMROSE COAL CO
CHERRYHILL TWP, INDCO PA.
ON

LETTER	DATE	SURVEYED BY	PLOTTED BY
A	11-14-56	Thomas Howarth	Thomas Howarth
B	7-26-57	Thomas Howarth	Thomas Howarth
C	12-28-57	Thomas Howarth	Thomas Howarth

200

WF
LE 1" = 100