

JAMES MOORHEAD

PRUSHNOK & WILMOTH

FORMERLY THOMAS SUTTON

A. EVANS

BENGSTON & WALKER

FORMERLY L. W. STAHL

E. WALBECK

FORMERLY ELMER HADDEN

PRUSHNOK & WILMOTH


FORMERLY DAVID ALLEN

← 3 MILES TO CLYMER
TWP ROAD No 629

DISCLAIMER: This map is provided as a courtesy to the Pennsylvania Bureau of Deep Mine Safety by American Premier Underwriters, Inc. (fka The Penn Central Railroad Corporation) and its subsidiary United Railroad Corp., which own or owned, but do not operate, the coal assets depicted hereon.

American Premier Underwriters, Inc. and United Railroad Corp. disclaim any representation or duty to any person as to the accuracy or completeness of this map or its fitness for any particular mining, safety or real estate related purpose. Any person who uses this map for any reason undertakes an independent duty to verify its accuracy and completeness, assumes all risks of its use, and agrees to hold American Premier Underwriters, Inc., United Railroad Corp. and their respective affiliates, shareholders, directors, officers and employees harmless from damage or liability arising from its use.

STRIP OPERATION STARTED AUGUST 1956
STRIP OPERATION CEASED SEPTEMBER 1958

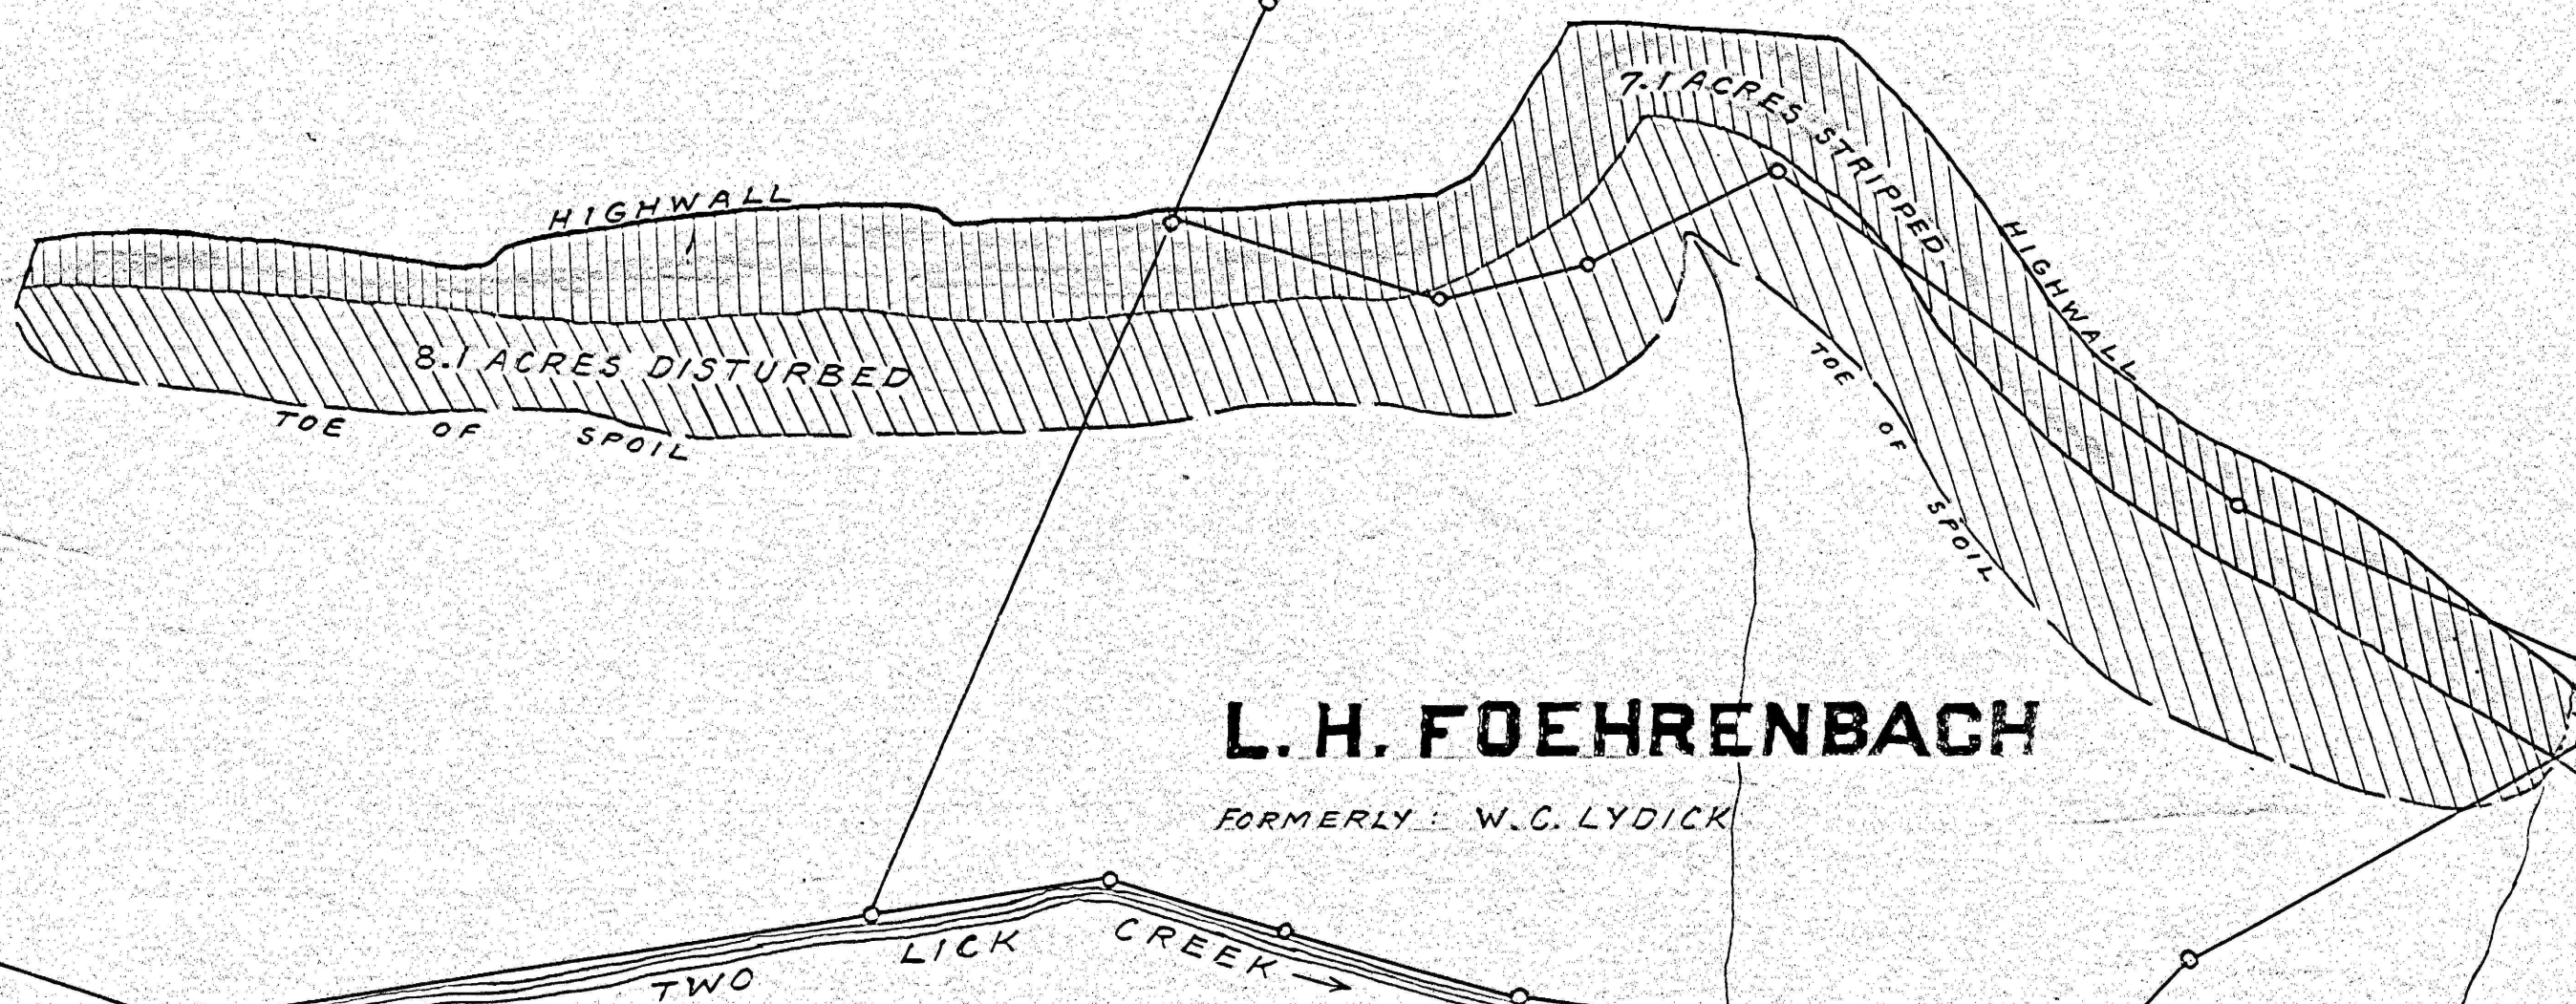

L. H. FOEHRENBACH

FORMERLY W. C. LYDICK

MAP SHOWING COMPLETION OF STRIP WORKINGS BY
THE LEASURE BROTHERS COAL CO ON THE E. WALBECK
BENGSTON & WALKER & L. H. FOEHRENBACH TRACTS OF LAND
AREA STRIPPED 7.1 ACRES AREA DISTURBED 8.1 ACRES
TOTAL AREA AFFECTED 15.2 ACRES
"B" SEAM SCALE 1" = 200'
LOCATED CHERRYHILL TWP INDIANA CO. PA.
SURVEYED FEBRUARY 22, 1961. BY Thomas Howarth

1.4 MILES TO
STATION 213+00
← AT ROUTE 32054