


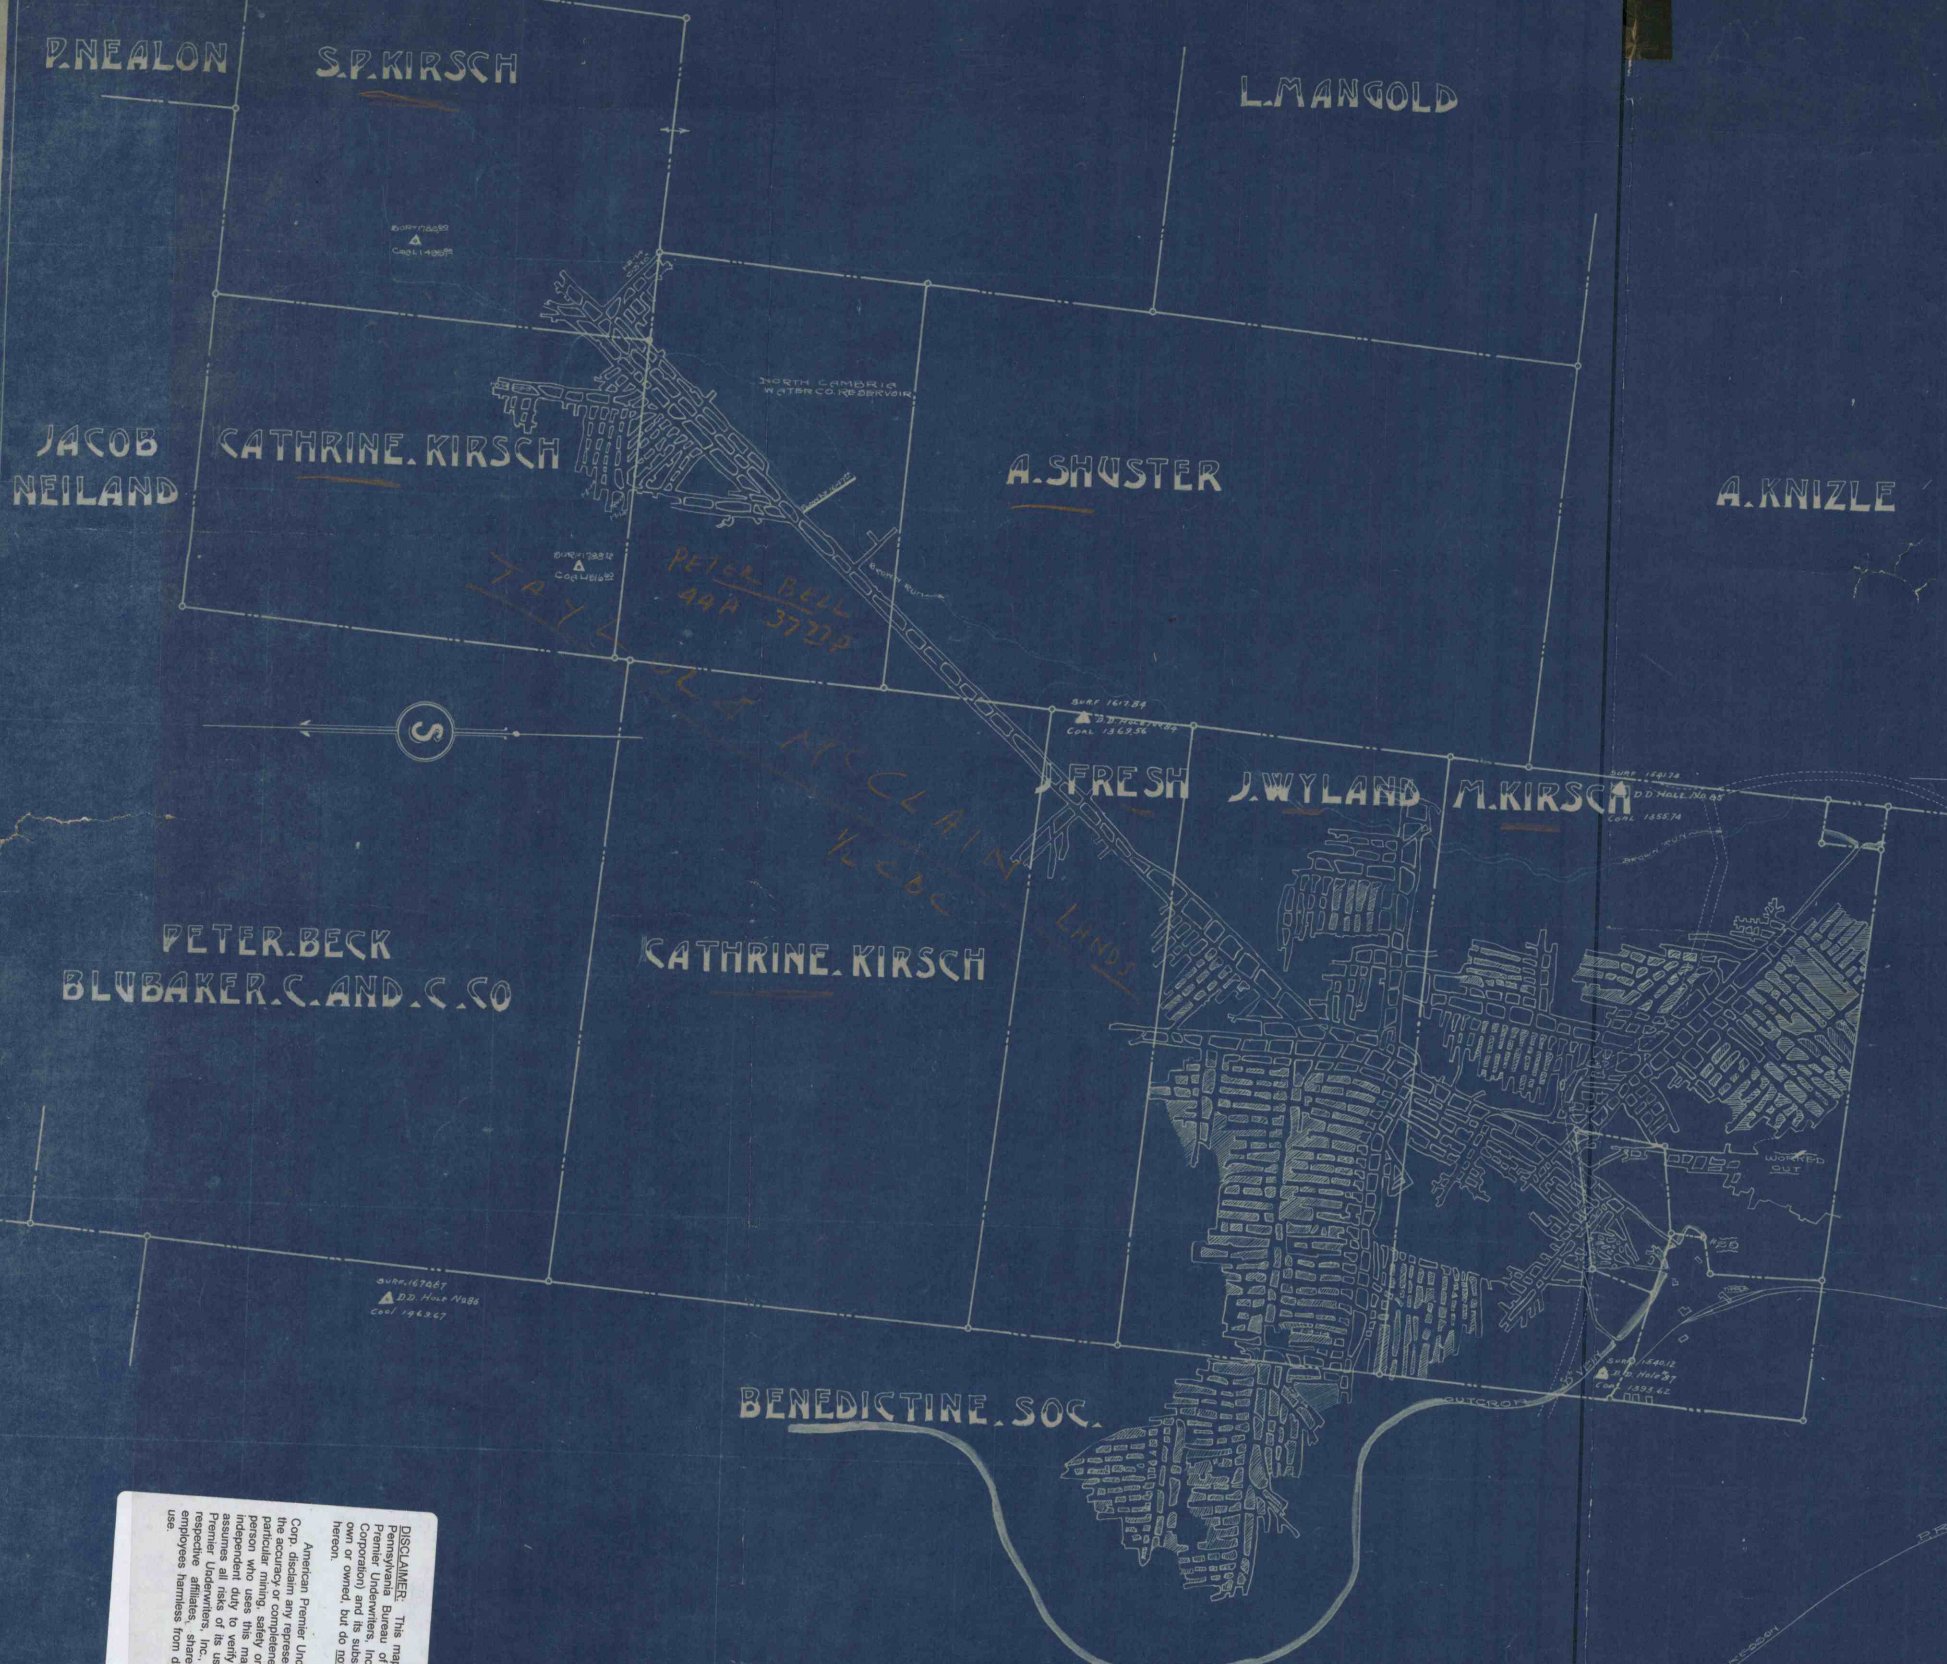

SPANGLER NO 25
OF
PENNA. C & C. CORP'N
SPANGLER PA

SCALE 1"=400'

PATTON DIV.

FEB 1914

DWG. NO 390

