


LEGEND

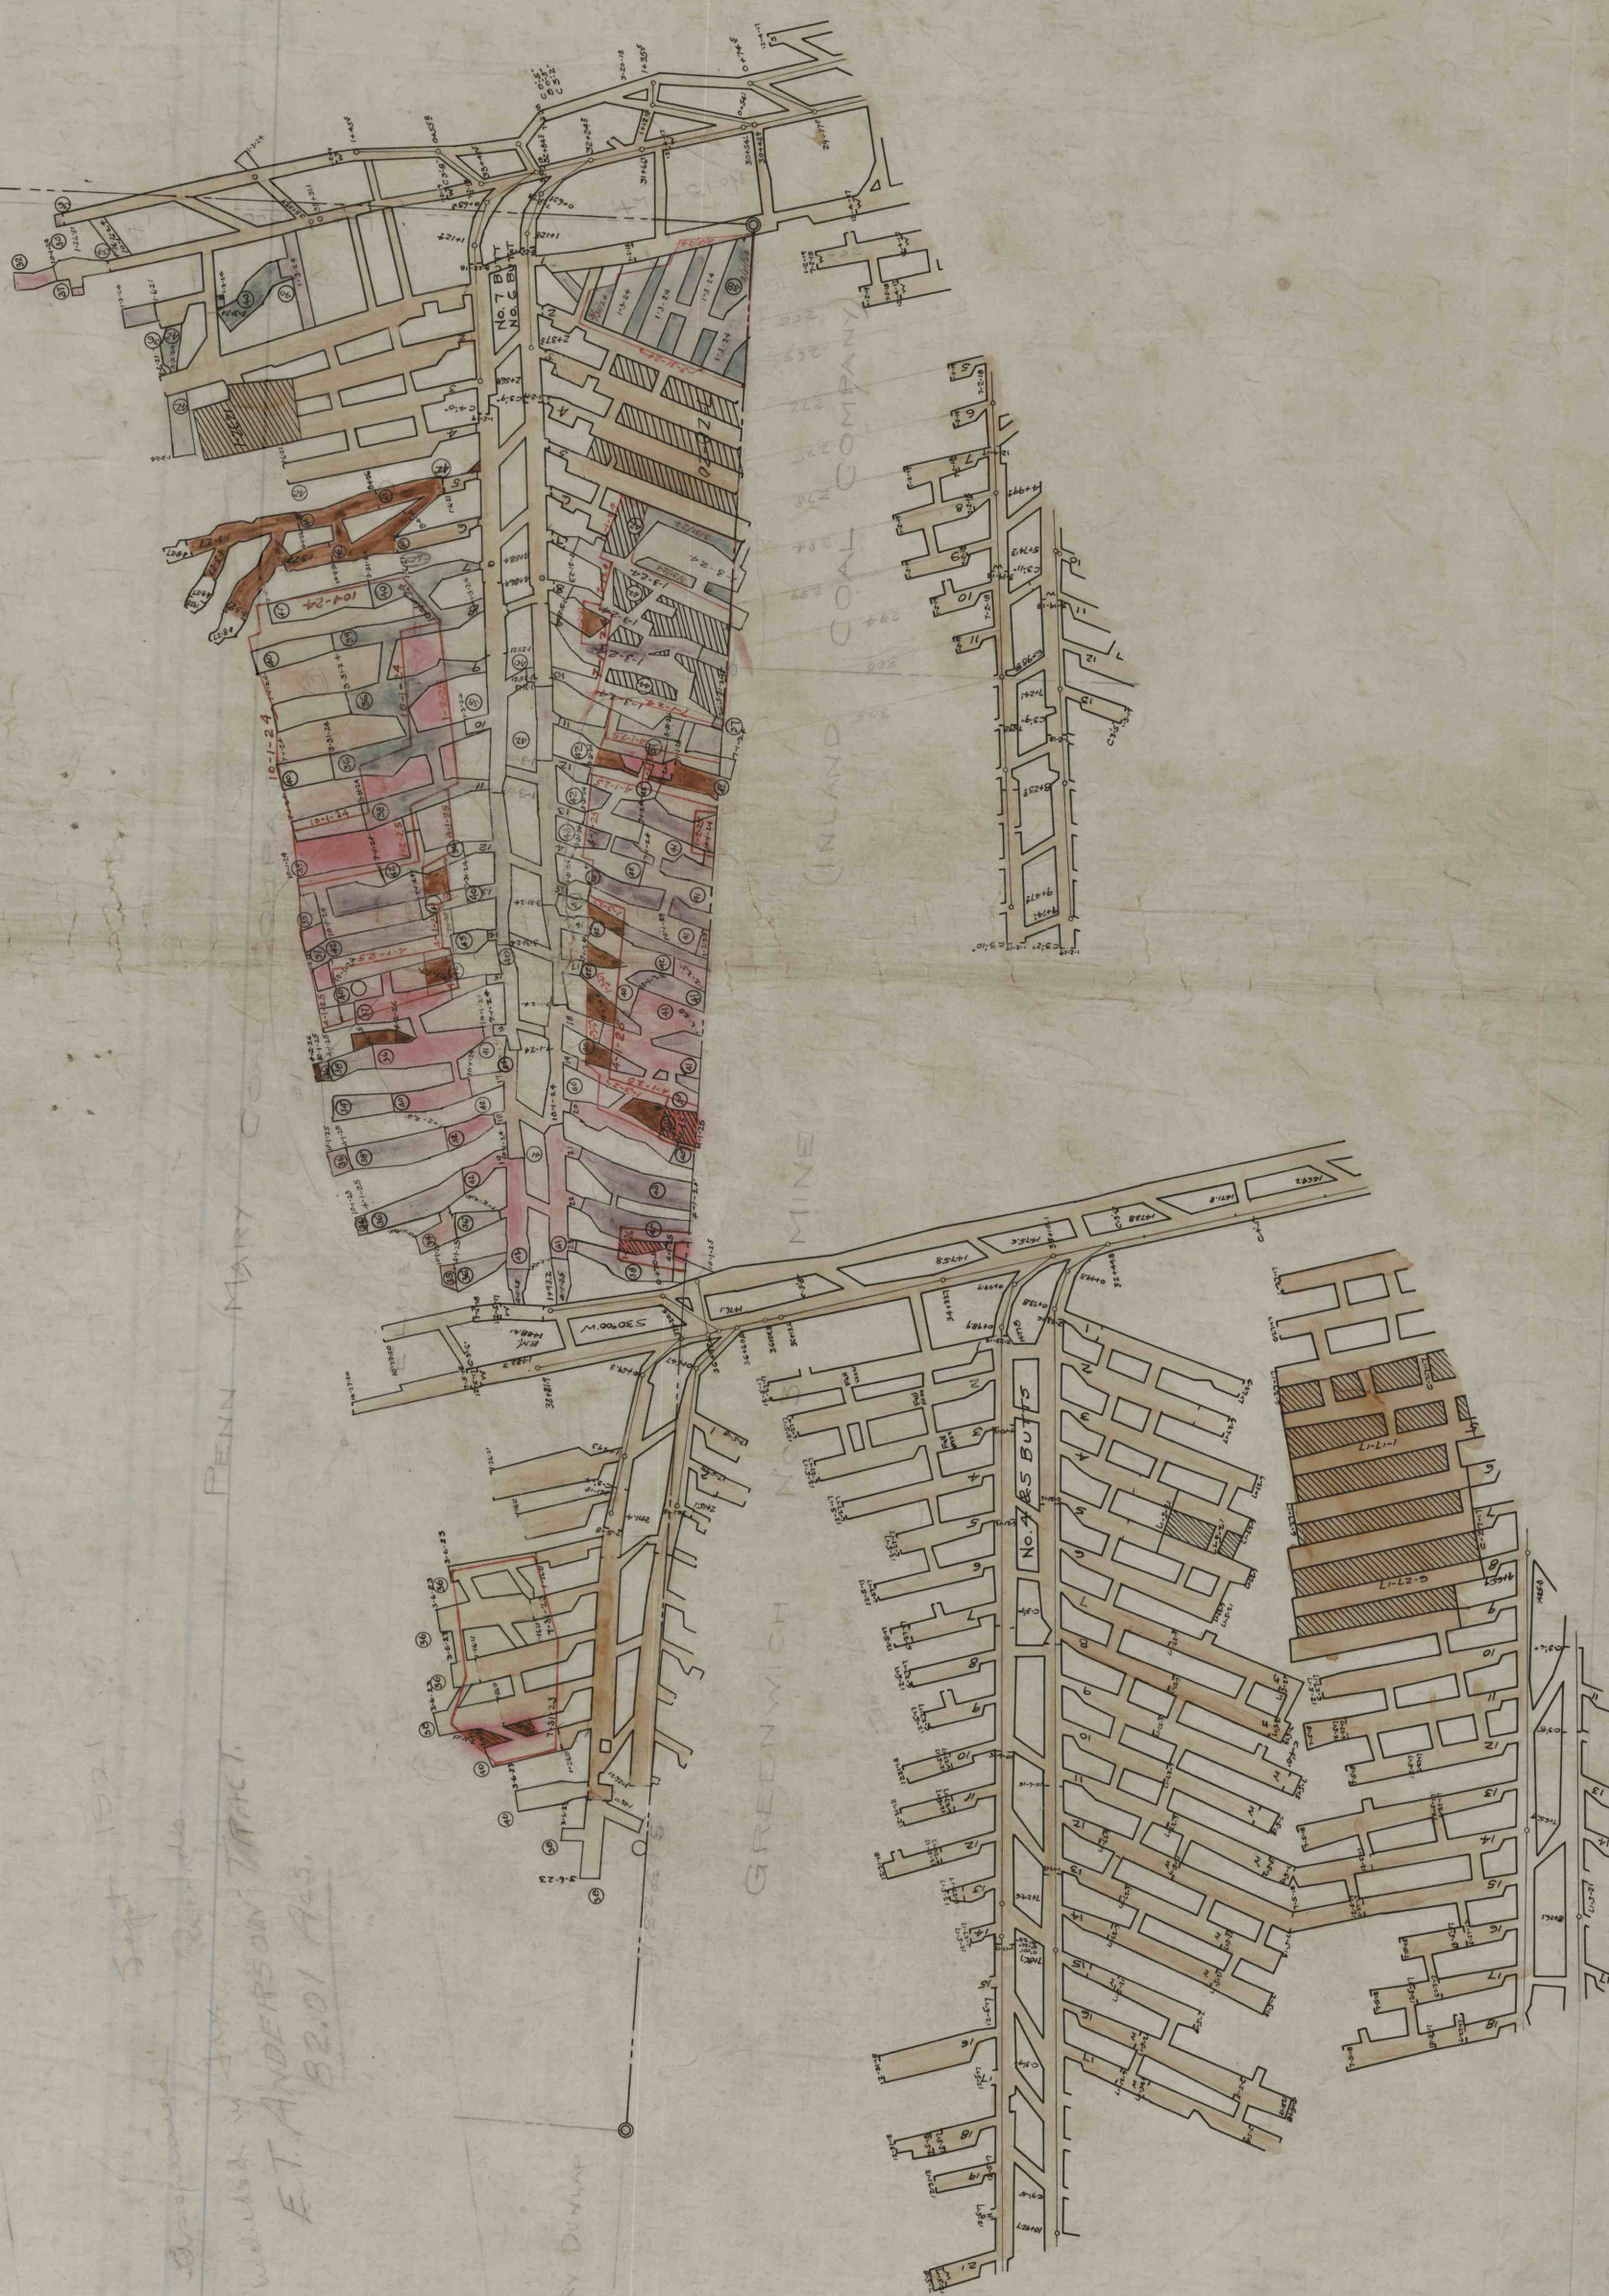


American Premier Underwriters, Inc. and United Railroad Corporation may not represent or warrant to any person the accuracy or any representation or duty to any person who uses this map of its mines for any purpose, including, but not limited to, any liability related purpose. Any person who relies on this map for any purpose other than to verify its accuracy and content, assumes all liability for any use, and agrees to hold American Premier Underwriters, Inc. and United Railroad Corporation, and their respective affiliates, shareholders, officers and directors, harmless from damage or liability claims.