


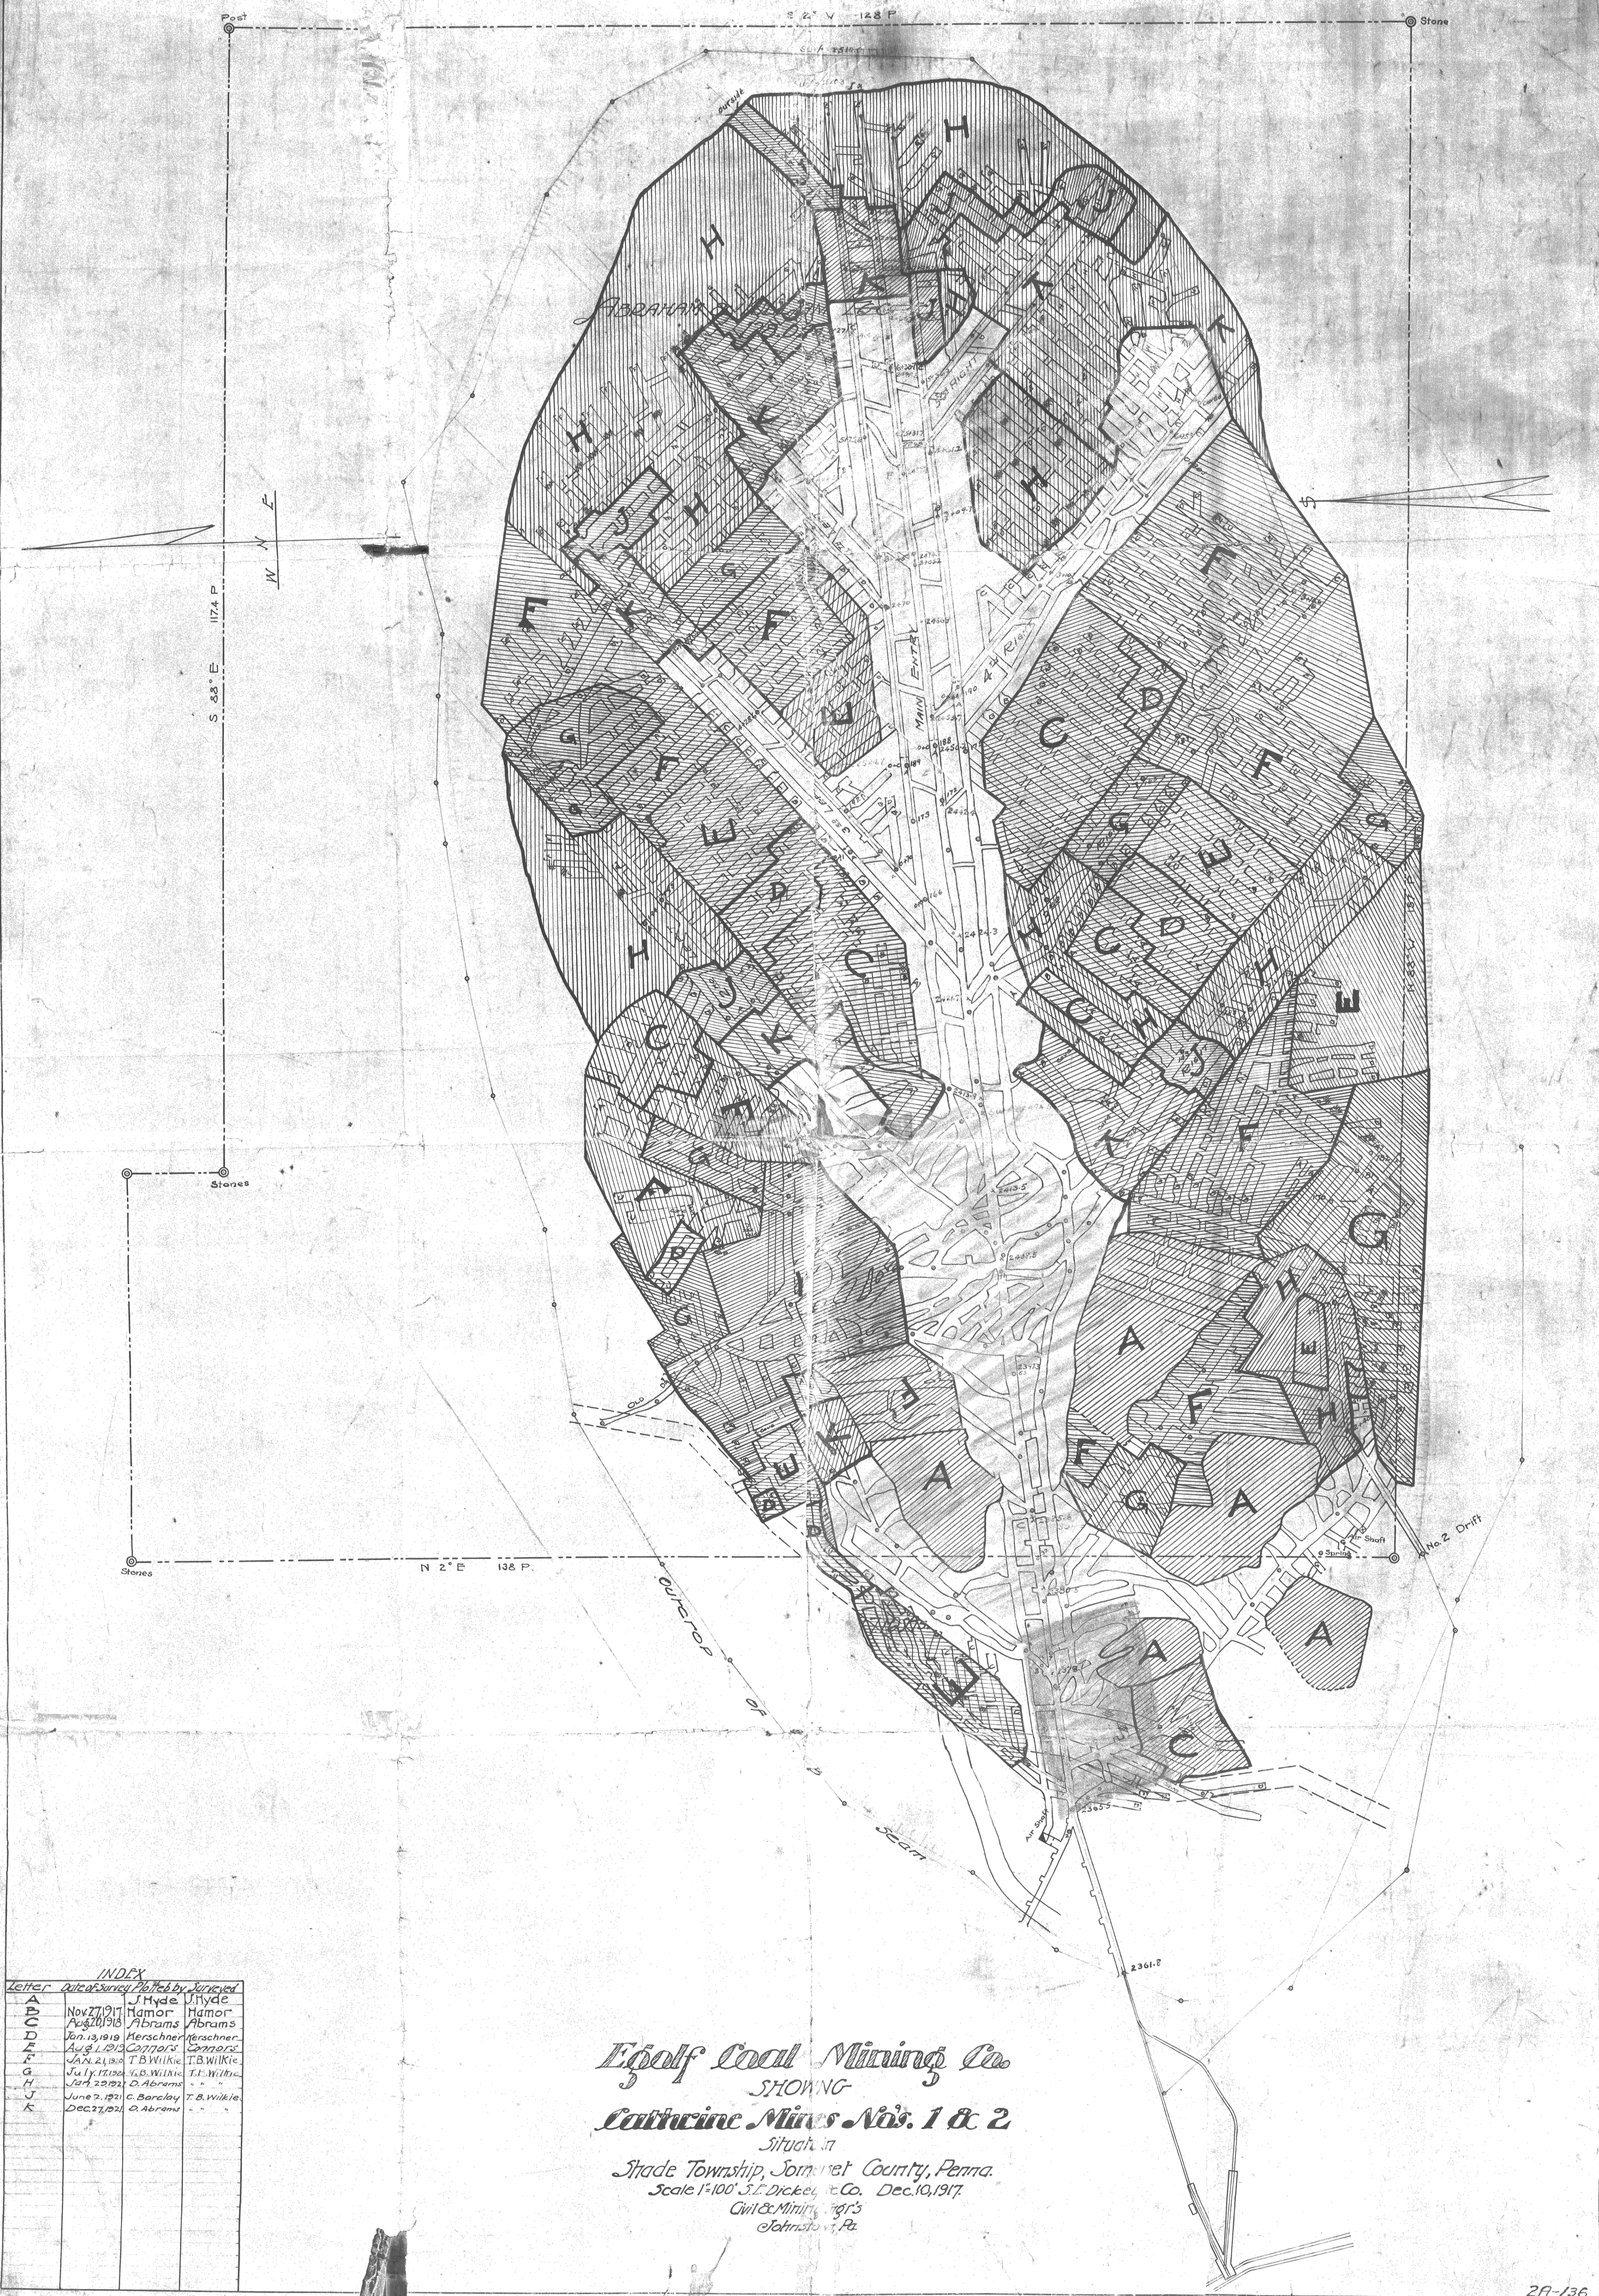

INDEX

Letter	Date of Survey	Plotted by	Surveyed
A	Nov. 27, 1917	J. Hyde	J. Hyde
B	Nov. 27, 1917	H. Hamor	H. Hamor
C	Aug. 20, 1918	A. Abrams	A. Abrams
D	Jan. 13, 1919	H. Hershner	H. Hershner
E	Aug. 1, 1919	C. Connors	C. Connors
F	Jan. 21, 1920	T. B. Wilkie	T. B. Wilkie
G	July 17, 1920	T. B. Wilkie	T. B. Wilkie
H	Jan. 23, 1921	D. Abrams	D. Abrams
J	June 7, 1921	C. Barclay	T. B. Wilkie
K	Dec. 27, 1921	D. Abrams	D. Abrams

Egolf Coal Mining Co.
 SHOWING
Catherine Mines Nos. 1 & 2
 Situation
 Shade Township, Somerset County, Penna.
 Scale 1"=100' J. L. Dickey & Co. Dec. 10, 1917.
 Civil & Mining Engr's
 Johnstown, Pa.