


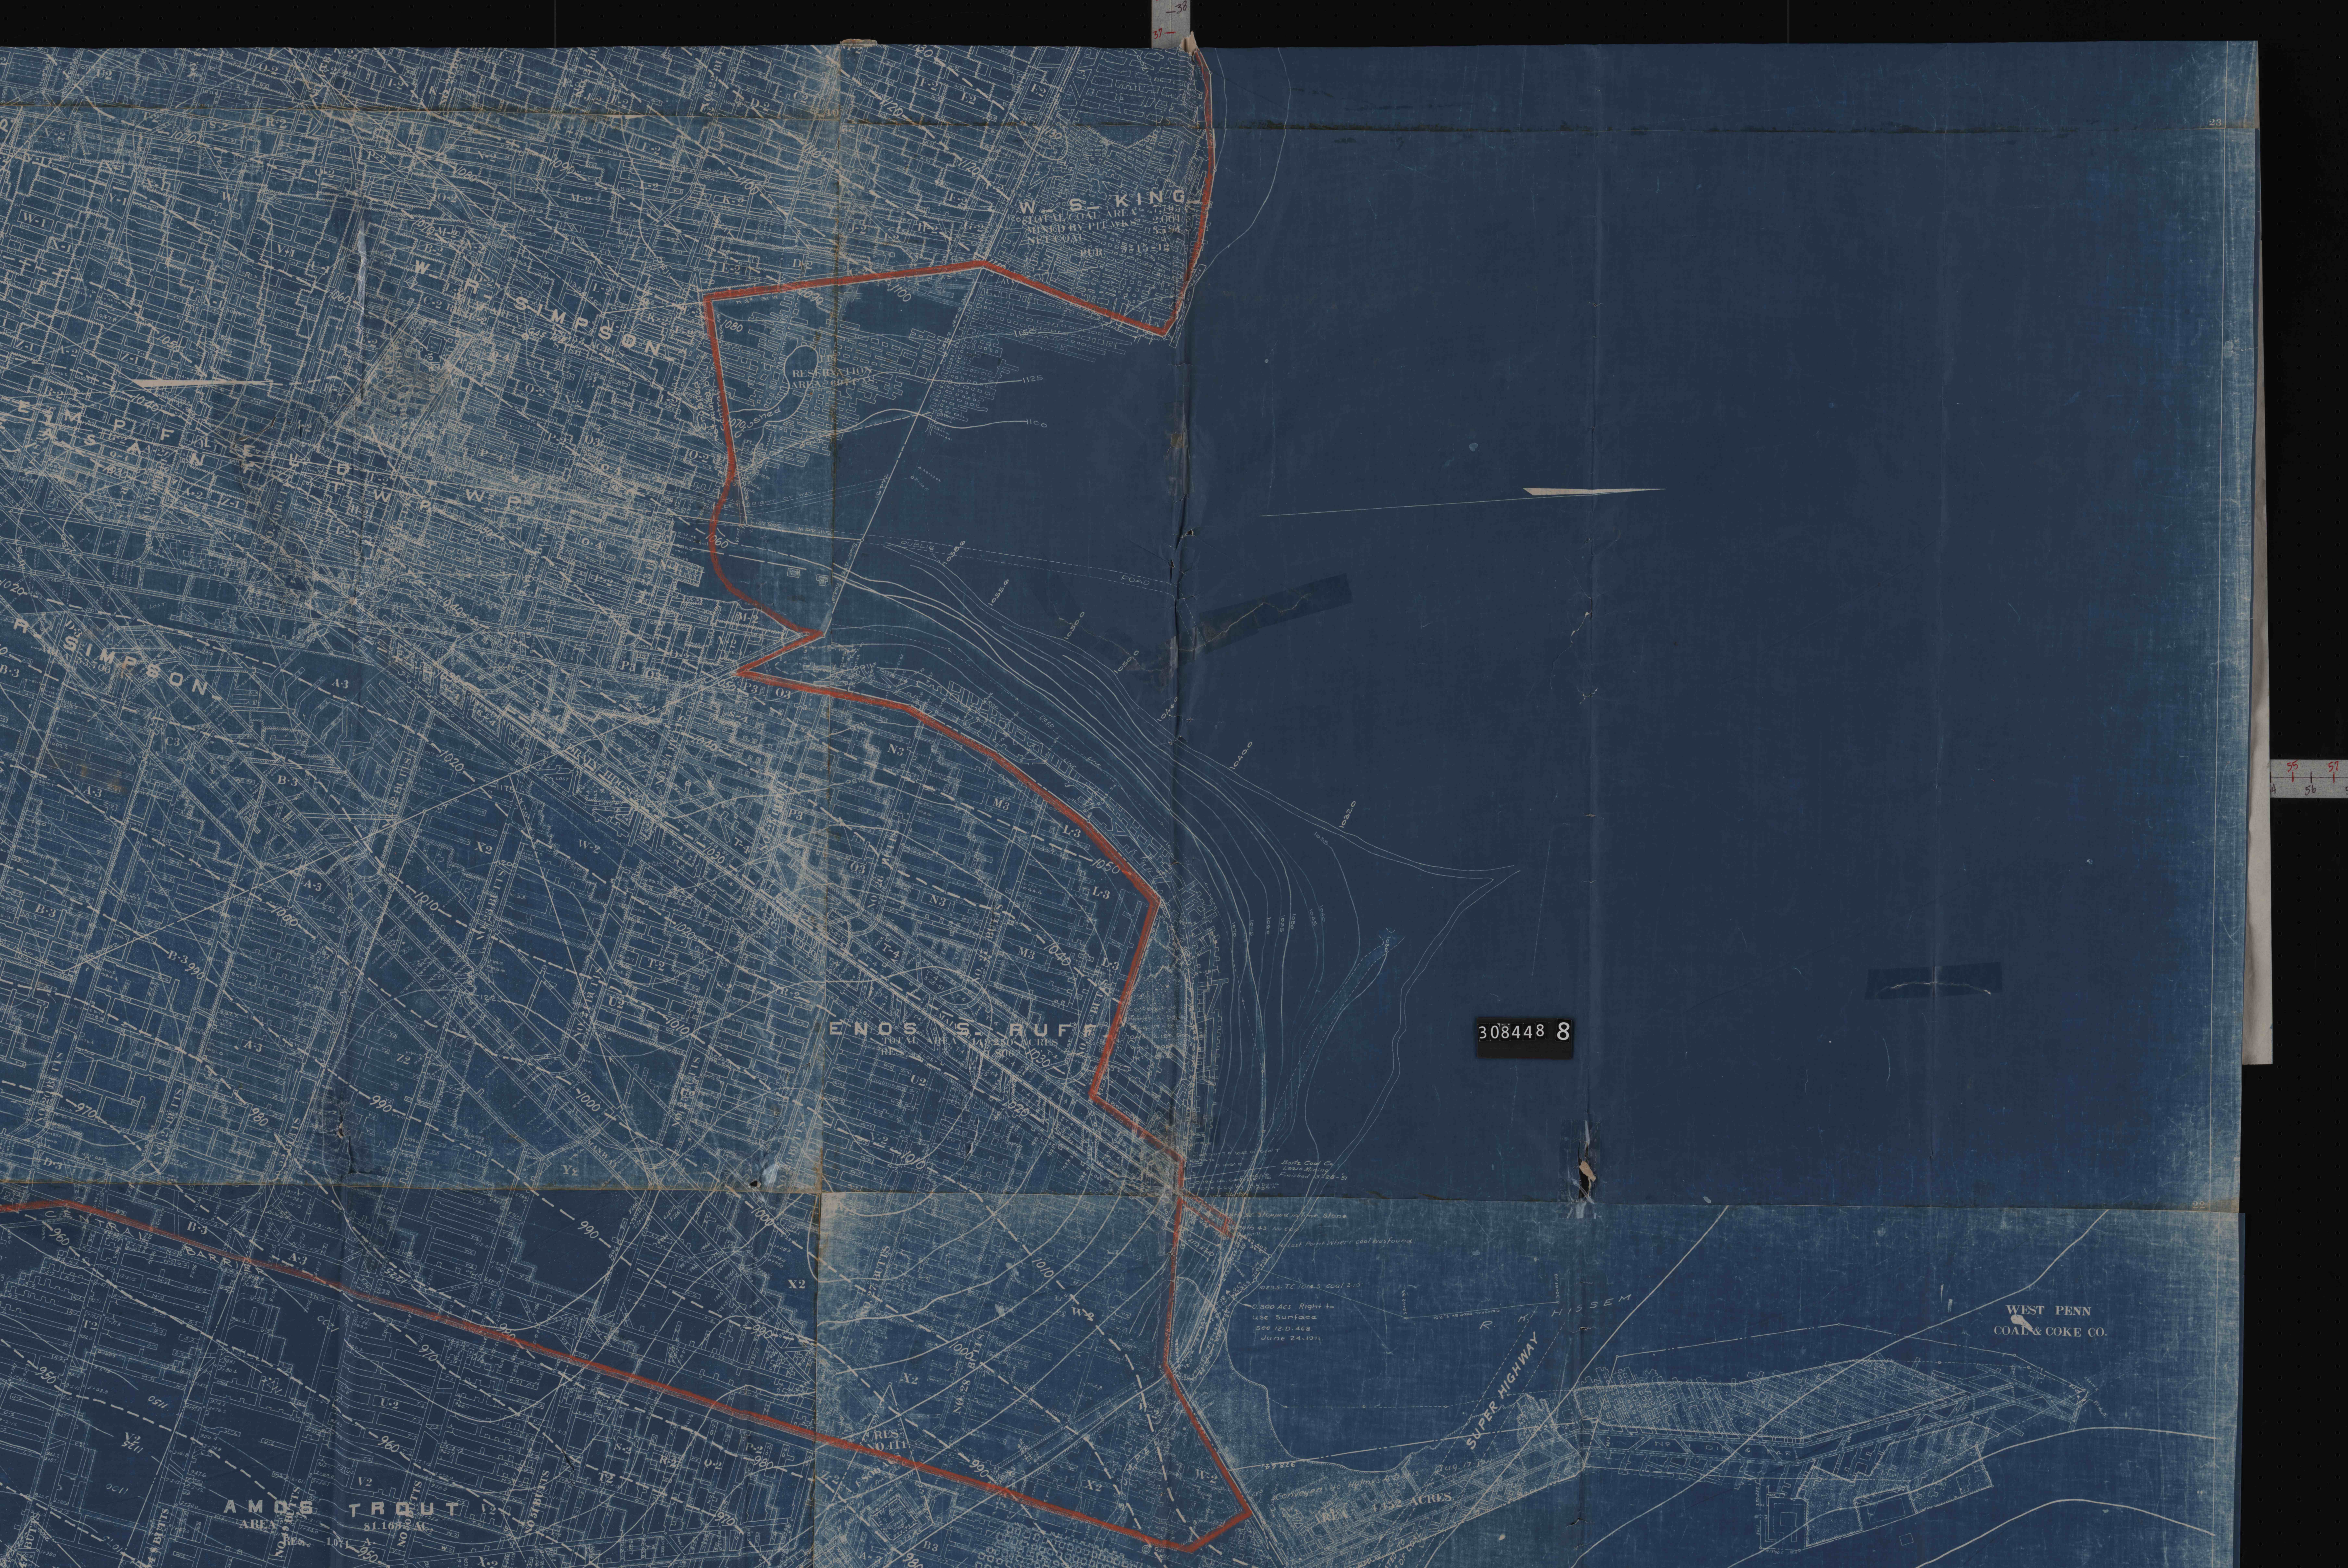

W S KING
TOTAL COAL AREA 2000
MINED BY PITWORK 5334
SHE COAL
RUB 35 15 12

SIMPSON

RESERVATION
AREA 2600

ENOS T S RUFF

308448 8

WEST PENN
COAL & COKE CO.

SUPER HIGHWAY

AMOS TRUITT
AREA 1160

South Coal Co.
Lumber Yard
Founded 1888-5

Stoppage on the Stone
to 43 100 ft

East Point where coal was found

2250 TC 1000 500 2 10

500 Acs Right to
USE Surface

See 12 D 468
June 24 1911

Aug 17 1911





