


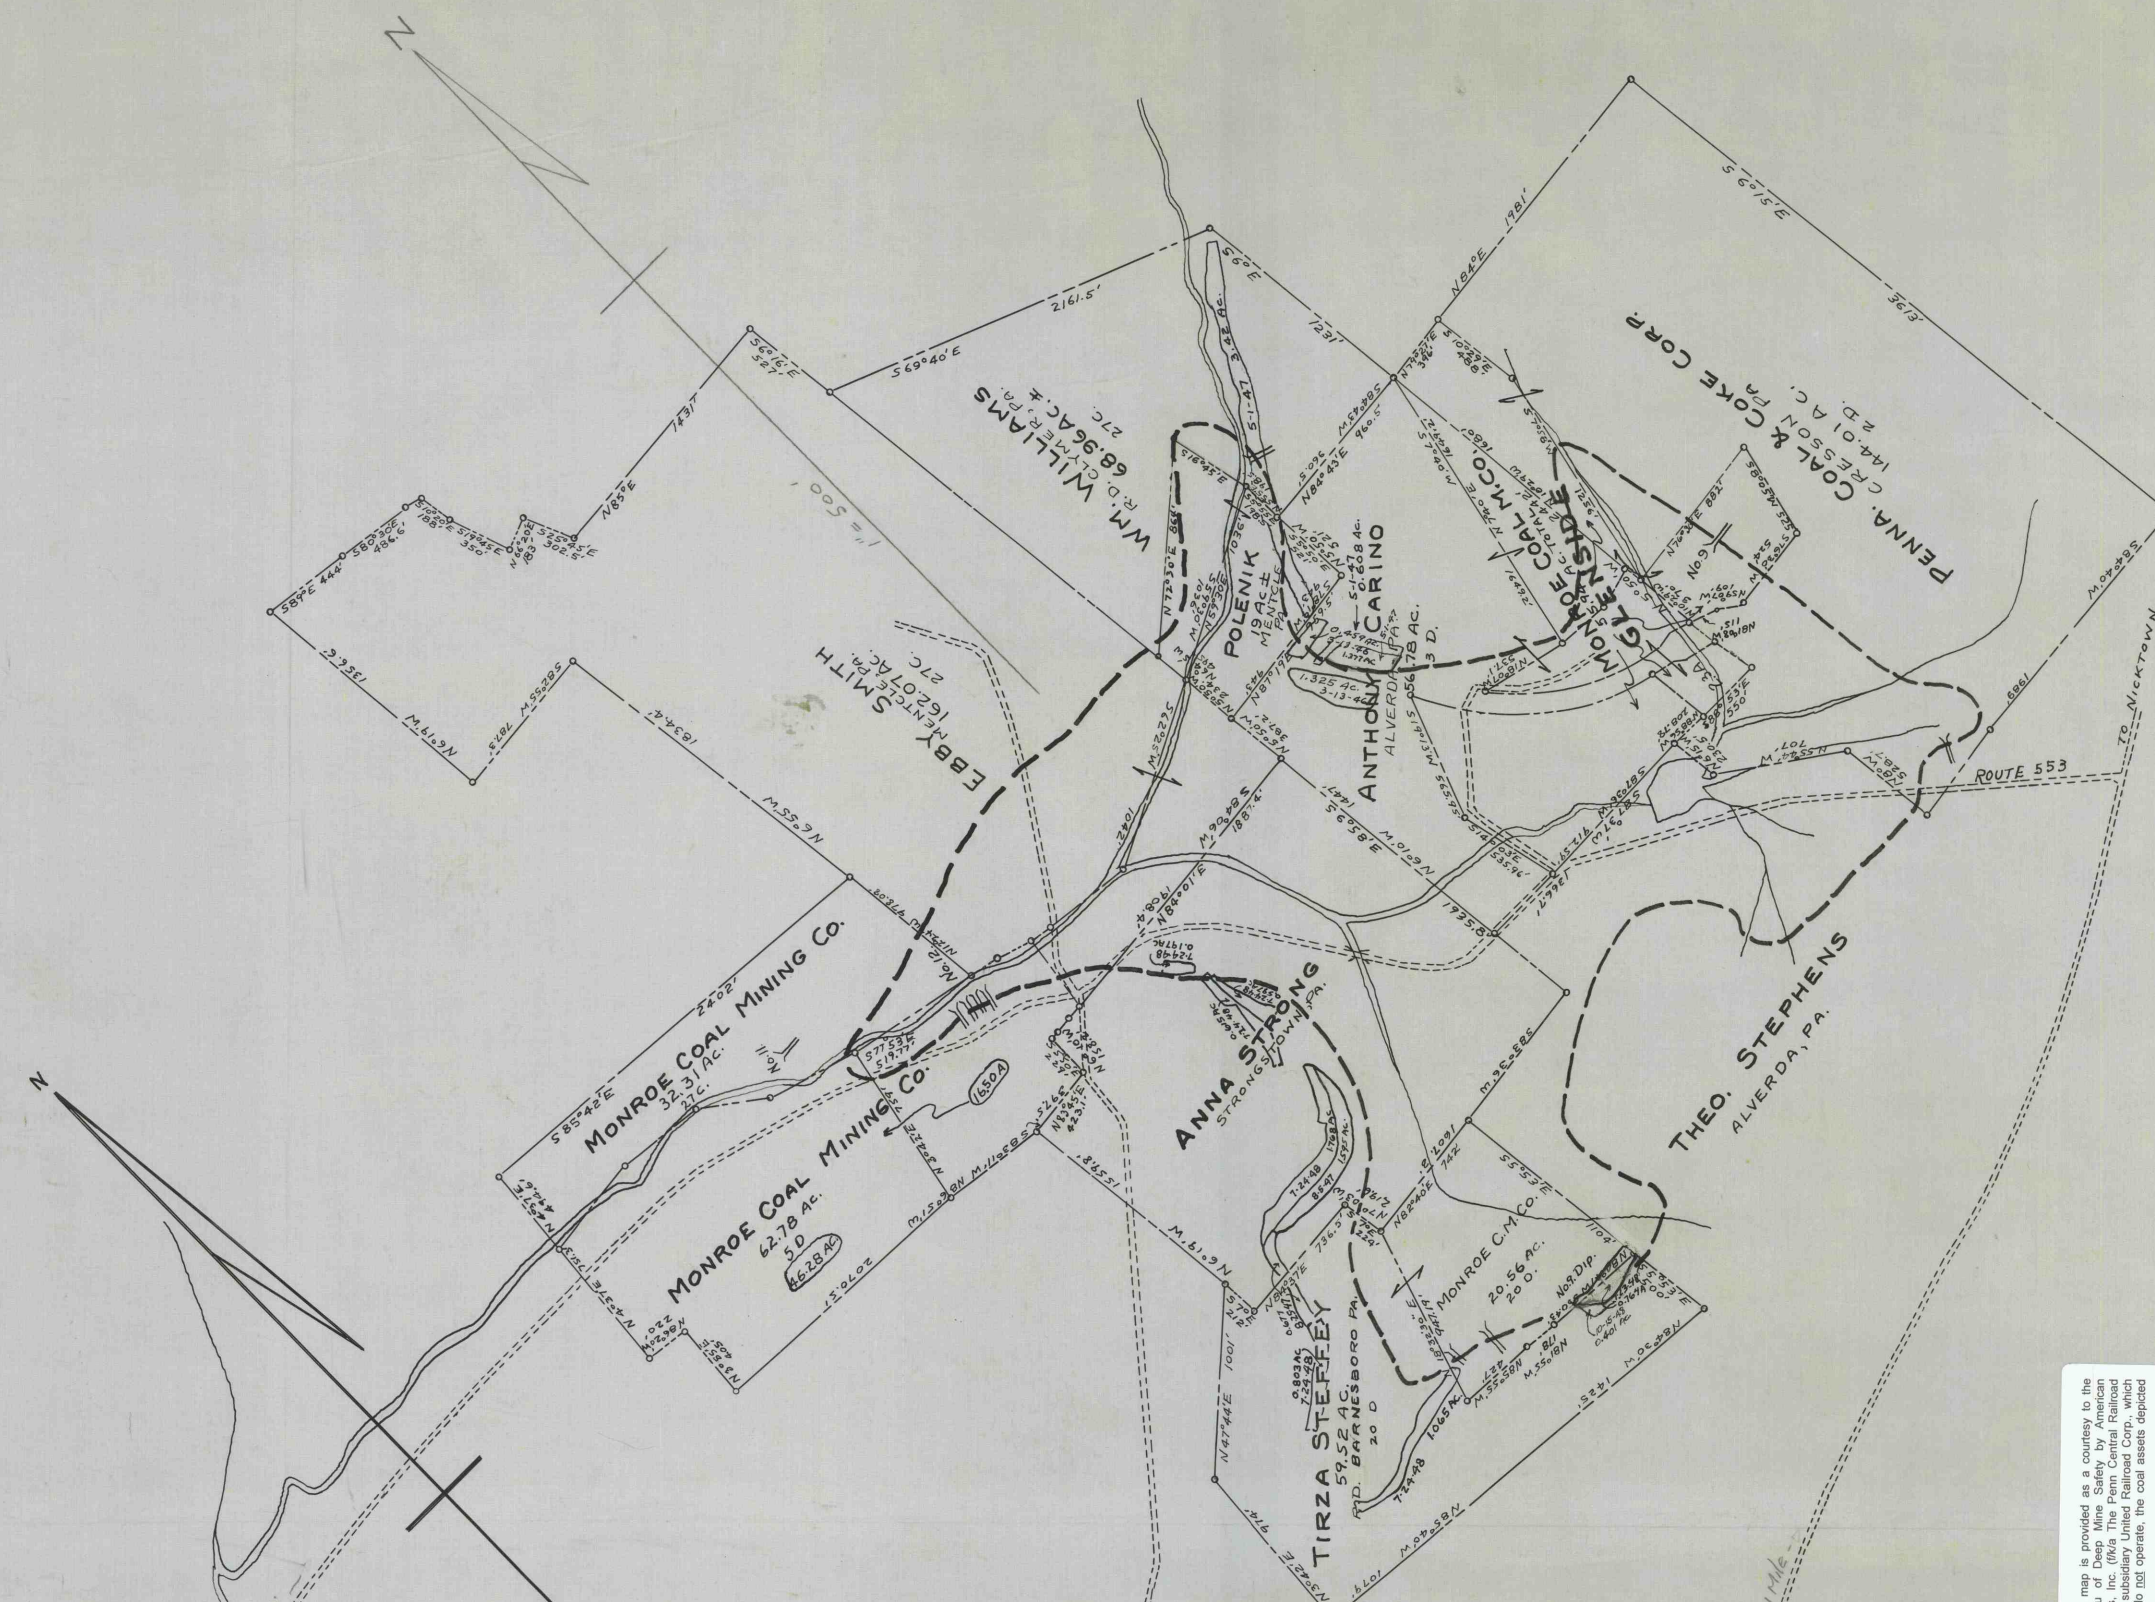


MAP SHOWING OPERATION
COAL STRIPPING SURFACE OWNERSHIP
MONROE COAL MINING CO.
HEILWOOD COUNTY, PA.

JULY, 1945. SCALE-1"=500'.

"D" Seam Outcrop Stripping

REVISIONS	
DATE	6-2-54
APPROVED	
DRAWN BY	J.C.D.
CHECKED BY	

REVISIONS	
DATE	7-2-54
APPROVED	
DRAWN BY	J.C.D.
CHECKED BY	

REVISIONS	
DATE	7-2-54
APPROVED	
DRAWN BY	J.C.D.
CHECKED BY	