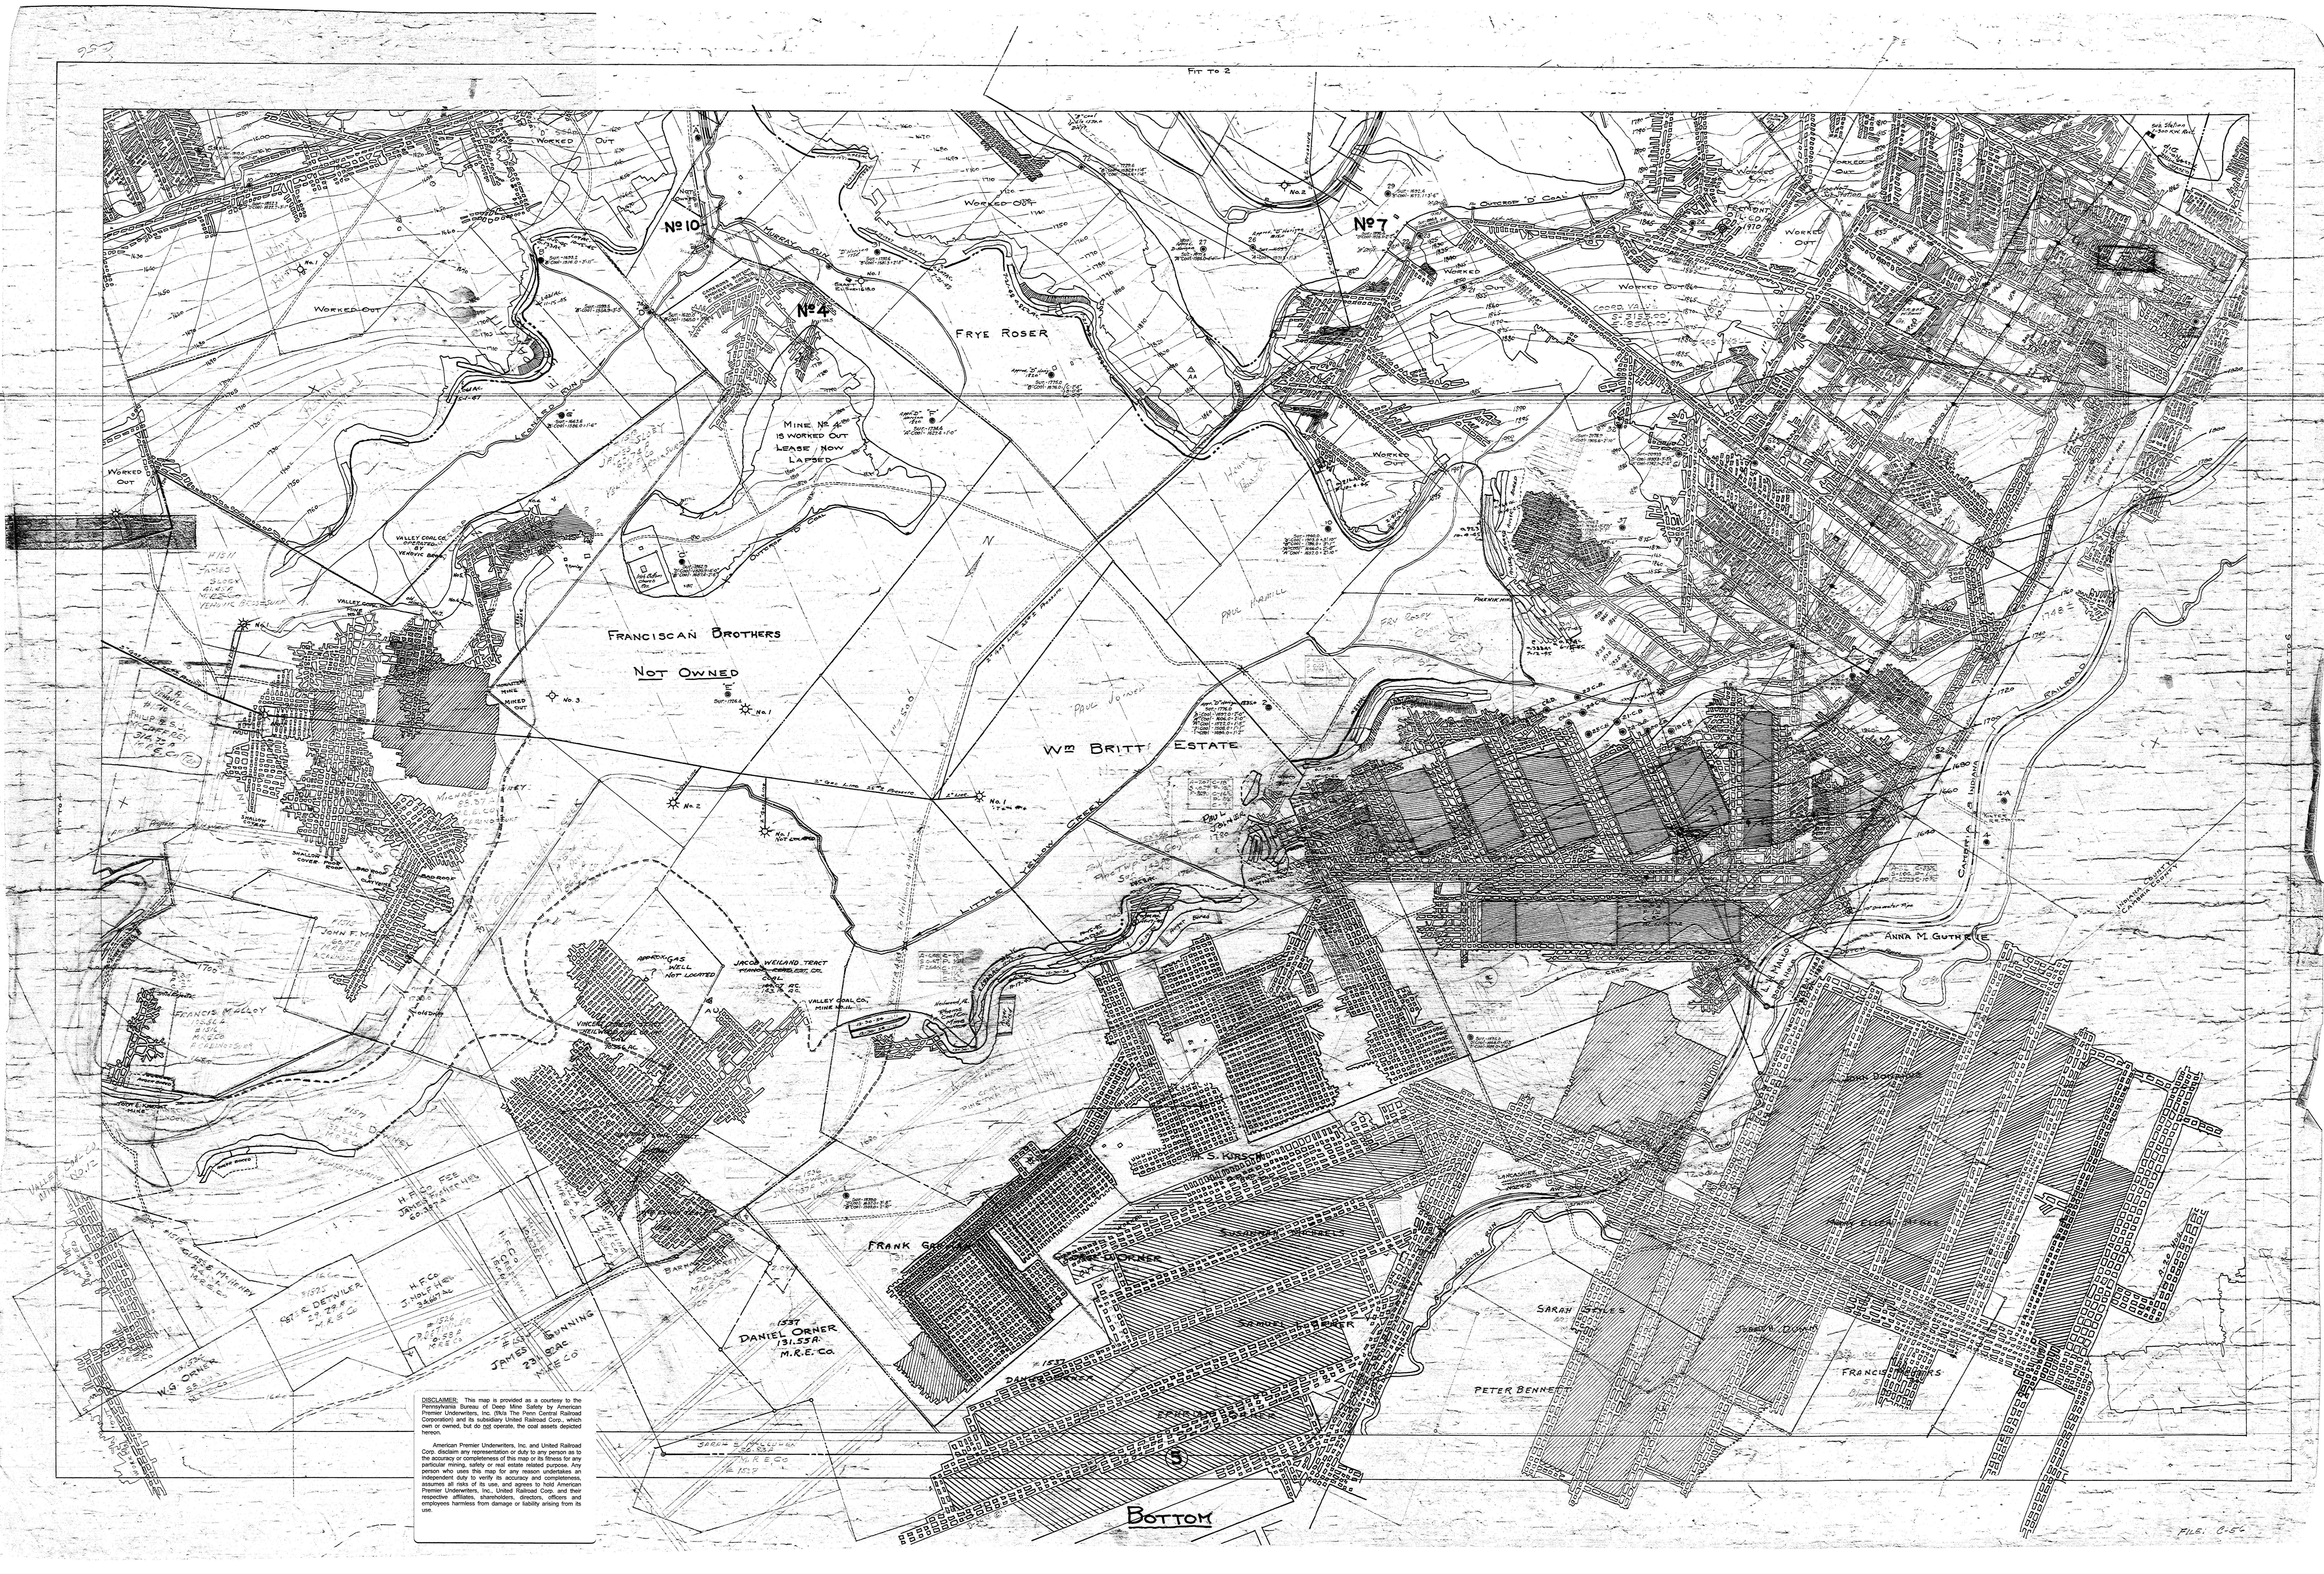
FIT TO 2
FIT TO 4
FIT TO 6
WORKED OUT
"D" SEAM WORKED OUT
No 10
NOT OWNED
MURRAY RUN
No 4
CAMERONS BOTTOM SMOKELESS COAL CO. "C" SEAM WORKINGS
SHAFT EL SUR-1618.0
No. 1
FRYE ROSER
MINE No 4 IS WORKED OUT LEASE NOW LAPSED
LEONARD RUN
"G" SUR-1663.6 "B" COAL-1586.0 = 1'-6"
JAMES SLOEY
No 7
No. 2
OUTCROP "D" COAL
FREMONT OIL CO. 1970
COORD. VALUE S-3153.00' E-1856.00'
GAS WELL
Sub. Station 1-300 K.W. Rect.
Mine Nort Sub Station
OUTCROP "D" COAL
VALLEY COAL CO. OPERATED BY VEHOVIC BROS.
VALLEY COAL CO. MINE No. 8
MONASTERY MINE MINED OUT
FRANCISCAN BROTHERS
NOT OWNED
No. 3
"E" SUR.-1726.6
No. 1
No. 2
No. 1 NOT LOCATED
2" Gas Line 25# Pressure
Wm BRITT ESTATE
PAUL HAMILL
PAUL JOYNER
LITTLE YELLOW CREEK
PHILIP & S.J. McCAFFREY 314.72 A M.R.E. Co
SHALLOW COVER
SHALLOW COVER POOR ROOF
BAD ROOF
CLAY VEINS
MICHAEL DOWNEY 85.37 A M.R.E. Co
JOHN F. M
FRANCIS MALLOY 105.56 A #1516 M.R.E. Co
AUGER BORED
JOHN E. KNIGHT MINE
#1517 M. E. DOWNEY 137.34 A M.R.E. Co
VALLEY COAL CO. MINE No. 12
APPROX. GAS WELL NOT LOCATED
JACOB WEILAND TRACT
VALLEY COAL CO. MINE No. 11
VINCENT
H.F. Co. FEE JAMES FISHER HRS 60.35 A
#1518 GLASS & McHENRY 84.43 A M.R.E. Co
#1525 PETER DETWILER 29.79 A M.R.E. Co
H.F. Co. J. NOLF HRS 34.667 Ac
#1526 P. DETWILER 0.58 A M.R.E. Co
#1530 JAMES GUNNING 231.92 Ac M.R.E. Co
#1524 W.G. ORNER 58.93 A M.R.E. Co
#1536 J.K. CALDWELL 137 A M.R.E. Co
BARNABAS McGARREY 20.33 A M.R.E. Co
#1537 DANIEL ORNER 131.55 A M.R.E. Co
FRANK GARMAN
GEORGE ORNER
SARAH E. McCLUHEN 50.83 A M.R.E. Co #1538
A.S. KIRSCH
SUSANNAH MICHAELS
SAMUEL L. BERER
EPHRAIM SHAFER
DANIEL ORNER
LANCASHIRE No 24 D
STATION
DUTCH RUN
SARAH STILES
PETER BENNETT
JOSEPH DUNN
FRANCIS PETERS
JOHN DONAHUE
MARY ELLEN McGEE
ANNA M. GUTHRIE
L.H. MALLOY
CAMBRIA & INDIANA RAILROAD
INDIANA COUNTY
CAMBRIA COUNTY
KINTER
4-A
52
5
BOTTOM
FILE: C-56

DISCLAIMER: This map is provided as a courtesy to the Pennsylvania Bureau of Deep Mine Safety by American Premier Underwriters, Inc. (f/k/a The Penn Central Railroad Corporation) and its subsidiary United Railroad Corp., which own or owned, but do not operate, the coal assets depicted hereon.

American Premier Underwriters, Inc. and United Railroad Corp. disclaim any representation or duty to any person as to the accuracy or completeness of this map or its fitness for any particular mining, safety or real estate related purpose. Any person who uses this map for any reason undertakes an independent duty to verify its accuracy and completeness, assumes all risks of its use, and agrees to hold American Premier Underwriters, Inc., United Railroad Corp. and their respective affiliates, shareholders, directors, officers and employees harmless from damage or liability arising from its use.