




MAP
SHOWING
MINES AND PROPERTY
OF

SITUATE IN
CAMBRIA AND INDIANA COUNTIES-PENNSYLVANIA

OPERATED BY
RED LANDS COAL COMPANY
HEILWOOD DIVISION — HEILWOOD PENNA.

Scale 1 inch = 500 feet — December- 1924

EXTENSIONS

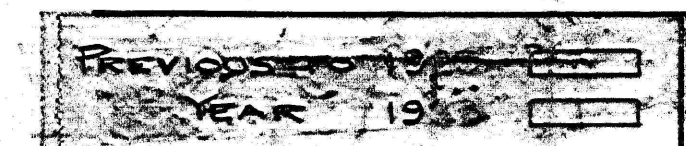

SURFACE BOUNDARY —————
COAL BOUNDARY —————
WELLS — DRY HOLE — DRY HOLE (FILLED) — GAS WELL — GAS WELL (FILLED)
DIAMOND DRILL HOLE —
CHURN DRILL HOLE (FOR SUBSTANTIAL CABLES) —

DISCLAIMER: This map is provided as a courtesy to the Pennsylvania Bureau of Geology and Topography by American Premier Underwriters, Inc. (the "Premier Coal Company") and its subsidiary United Railroad Corp., which have no interest in the coal assets depicted hereon.

American Premier Underwriters, Inc. and United Railroad Corp. disclaim any representation or duty to any person as to the accuracy or completeness of this map or its use for any purpose other than that for which it was prepared. Any person who uses this map for any other purpose does so at their own risk and agrees to hold American Premier Underwriters, Inc., United Railroad Corp. and their respective officers, shareholders, directors, officers and employees harmless from damage or liability arising from its use.

6
BOTTOM

FILE C-56