


DISCLAIMER: This map is provided as a courtesy to the Pennsylvania Bureau of Deep Mine Safety by American Premier Underwriters, Inc. and United Railroad Corporation and its subsidiary United Railroad Corporation, which own or operate the coal assets depicted hereon. American Premier Underwriters, Inc. and United Railroad Corporation disclaim any representation or duty to any person as to the accuracy or completeness of this map or its purpose. Any person who uses this map for any reason undertakes an independent duty to verify its accuracy and completeness. American Premier Underwriters, Inc., United Railroad Corporation and its subsidiary United Railroad Corporation assume no liability for damages or liability arising from its use.

NO. 3

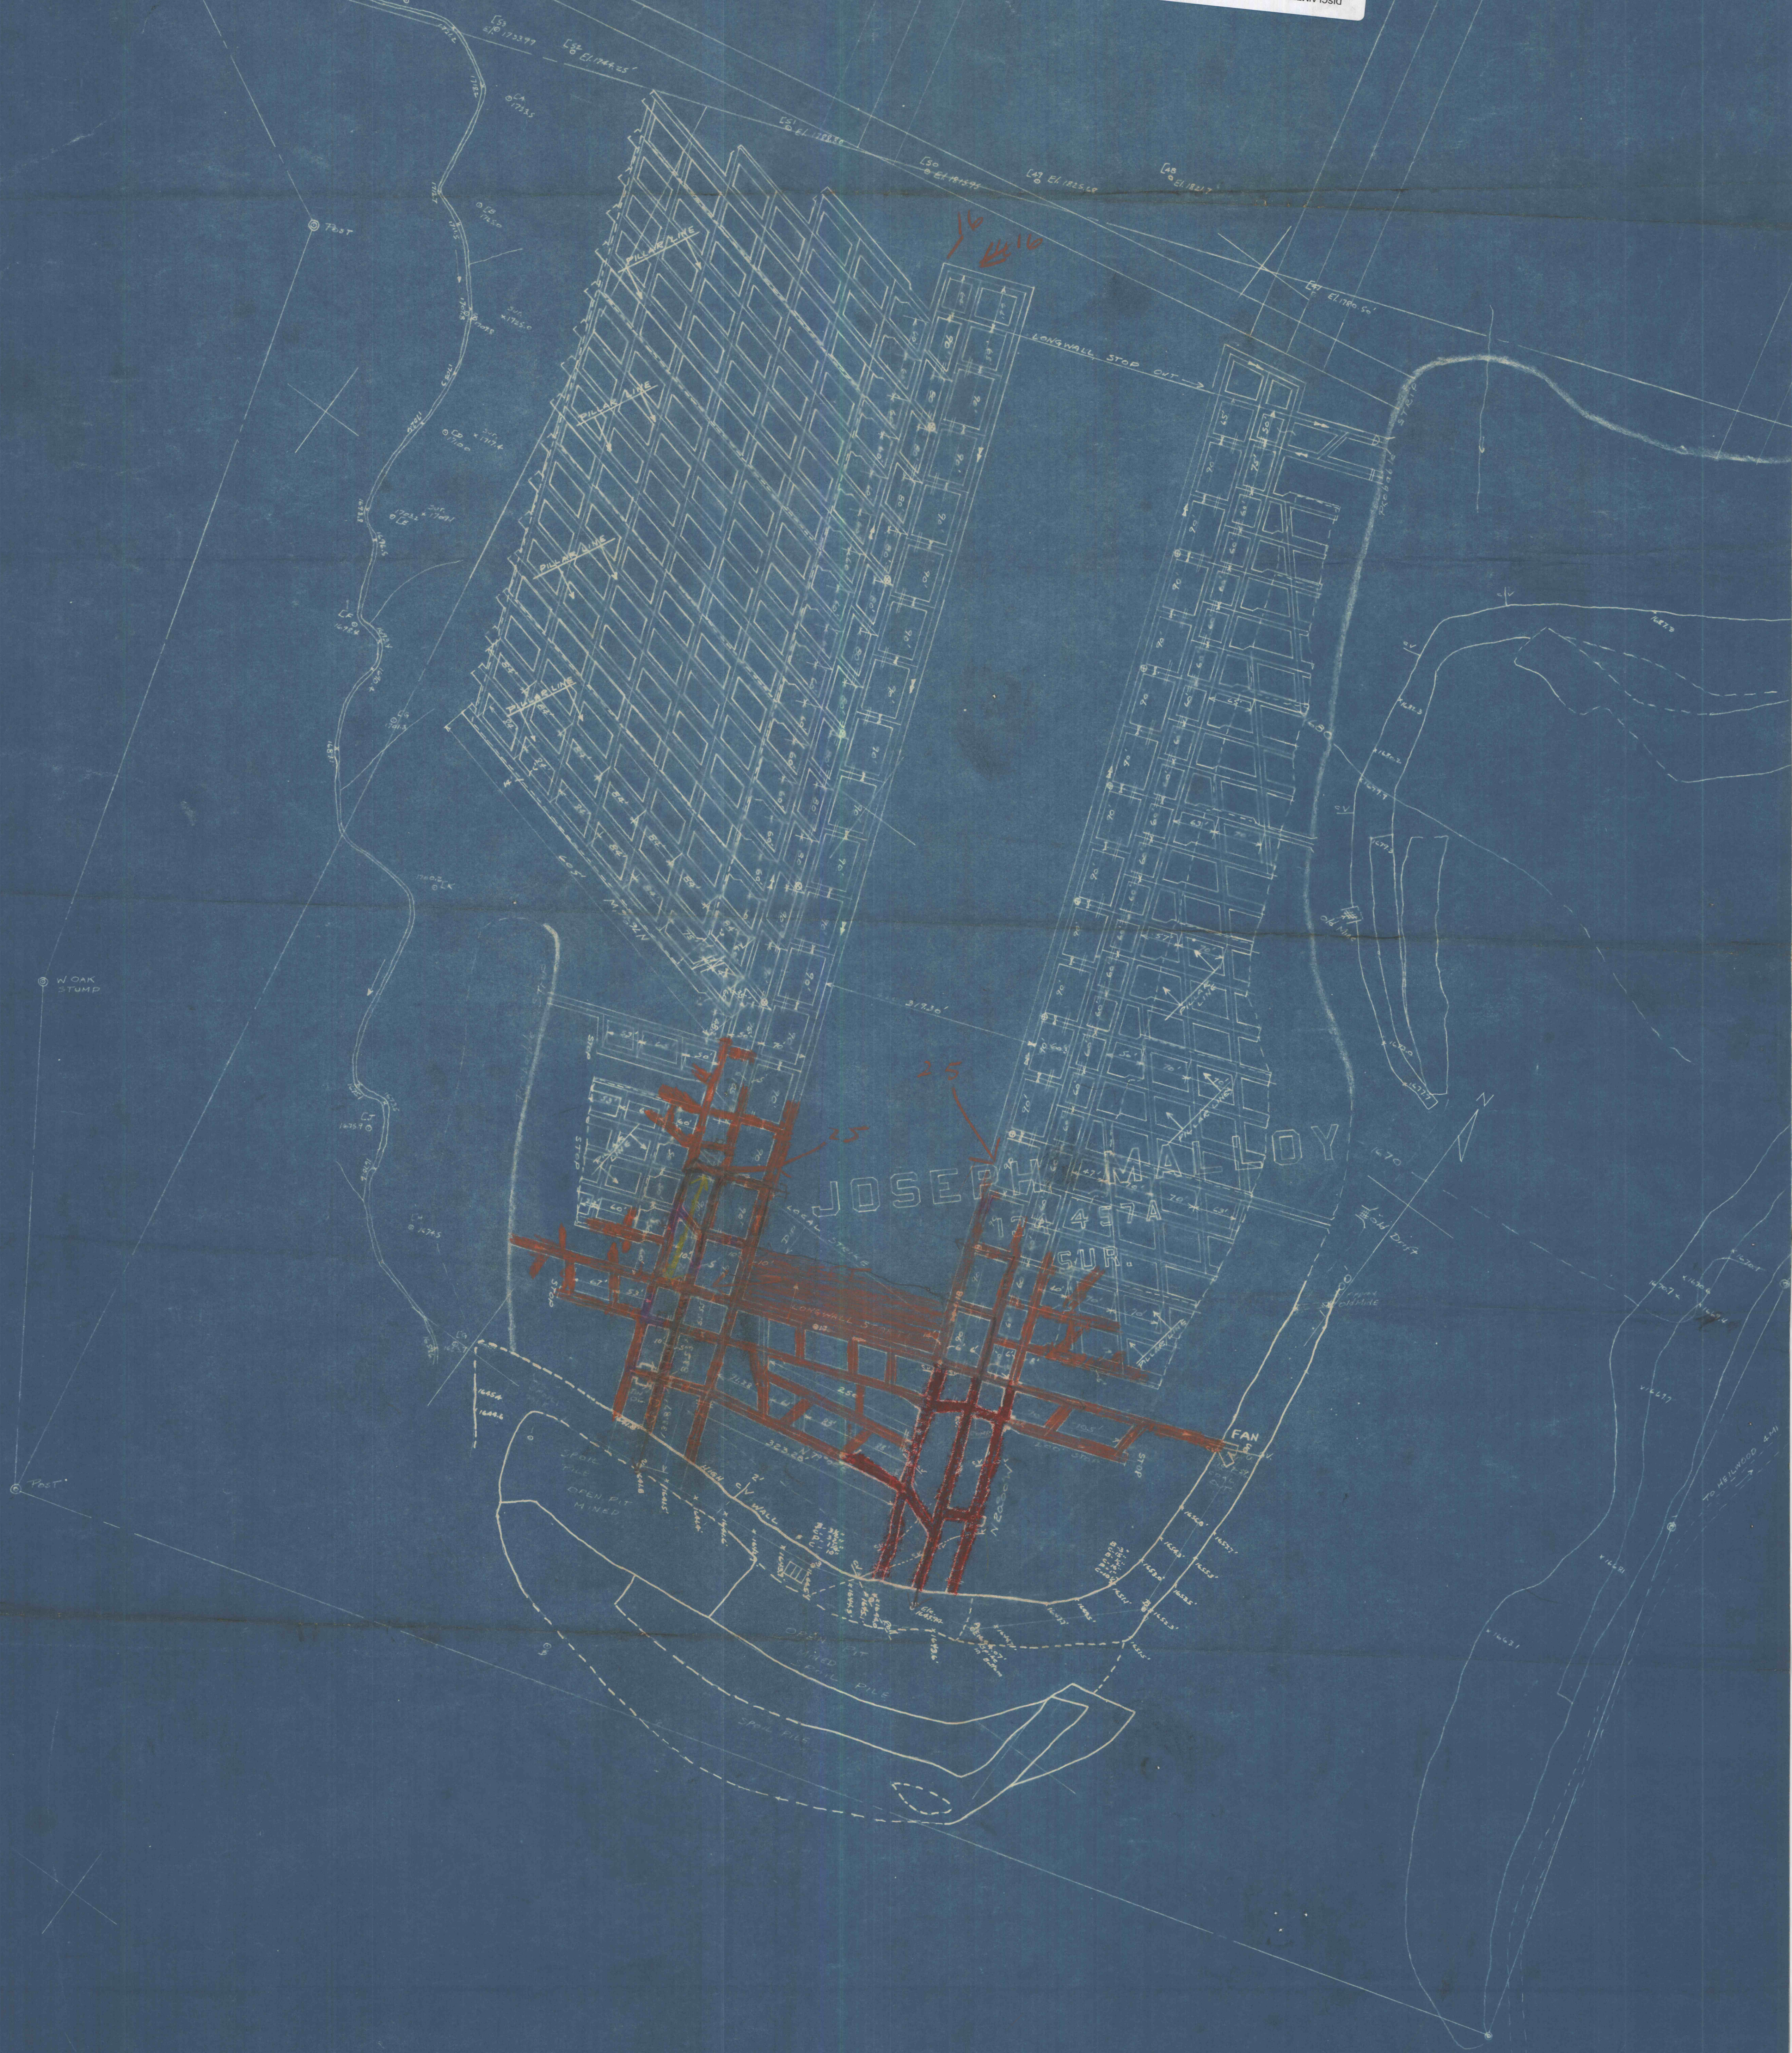

PINE TWP COAL CO., INC.
HEILWOOD, PA.
PROJECTIONS FOR HIGHWALL
MECHANICAL MINING
DATE - 8-2-59
SCALE - 1" = 100'
REVISED - 10-15-59

*Do Not Destroy
(This was last Map
Marked by Foreman on
wall at mine)*