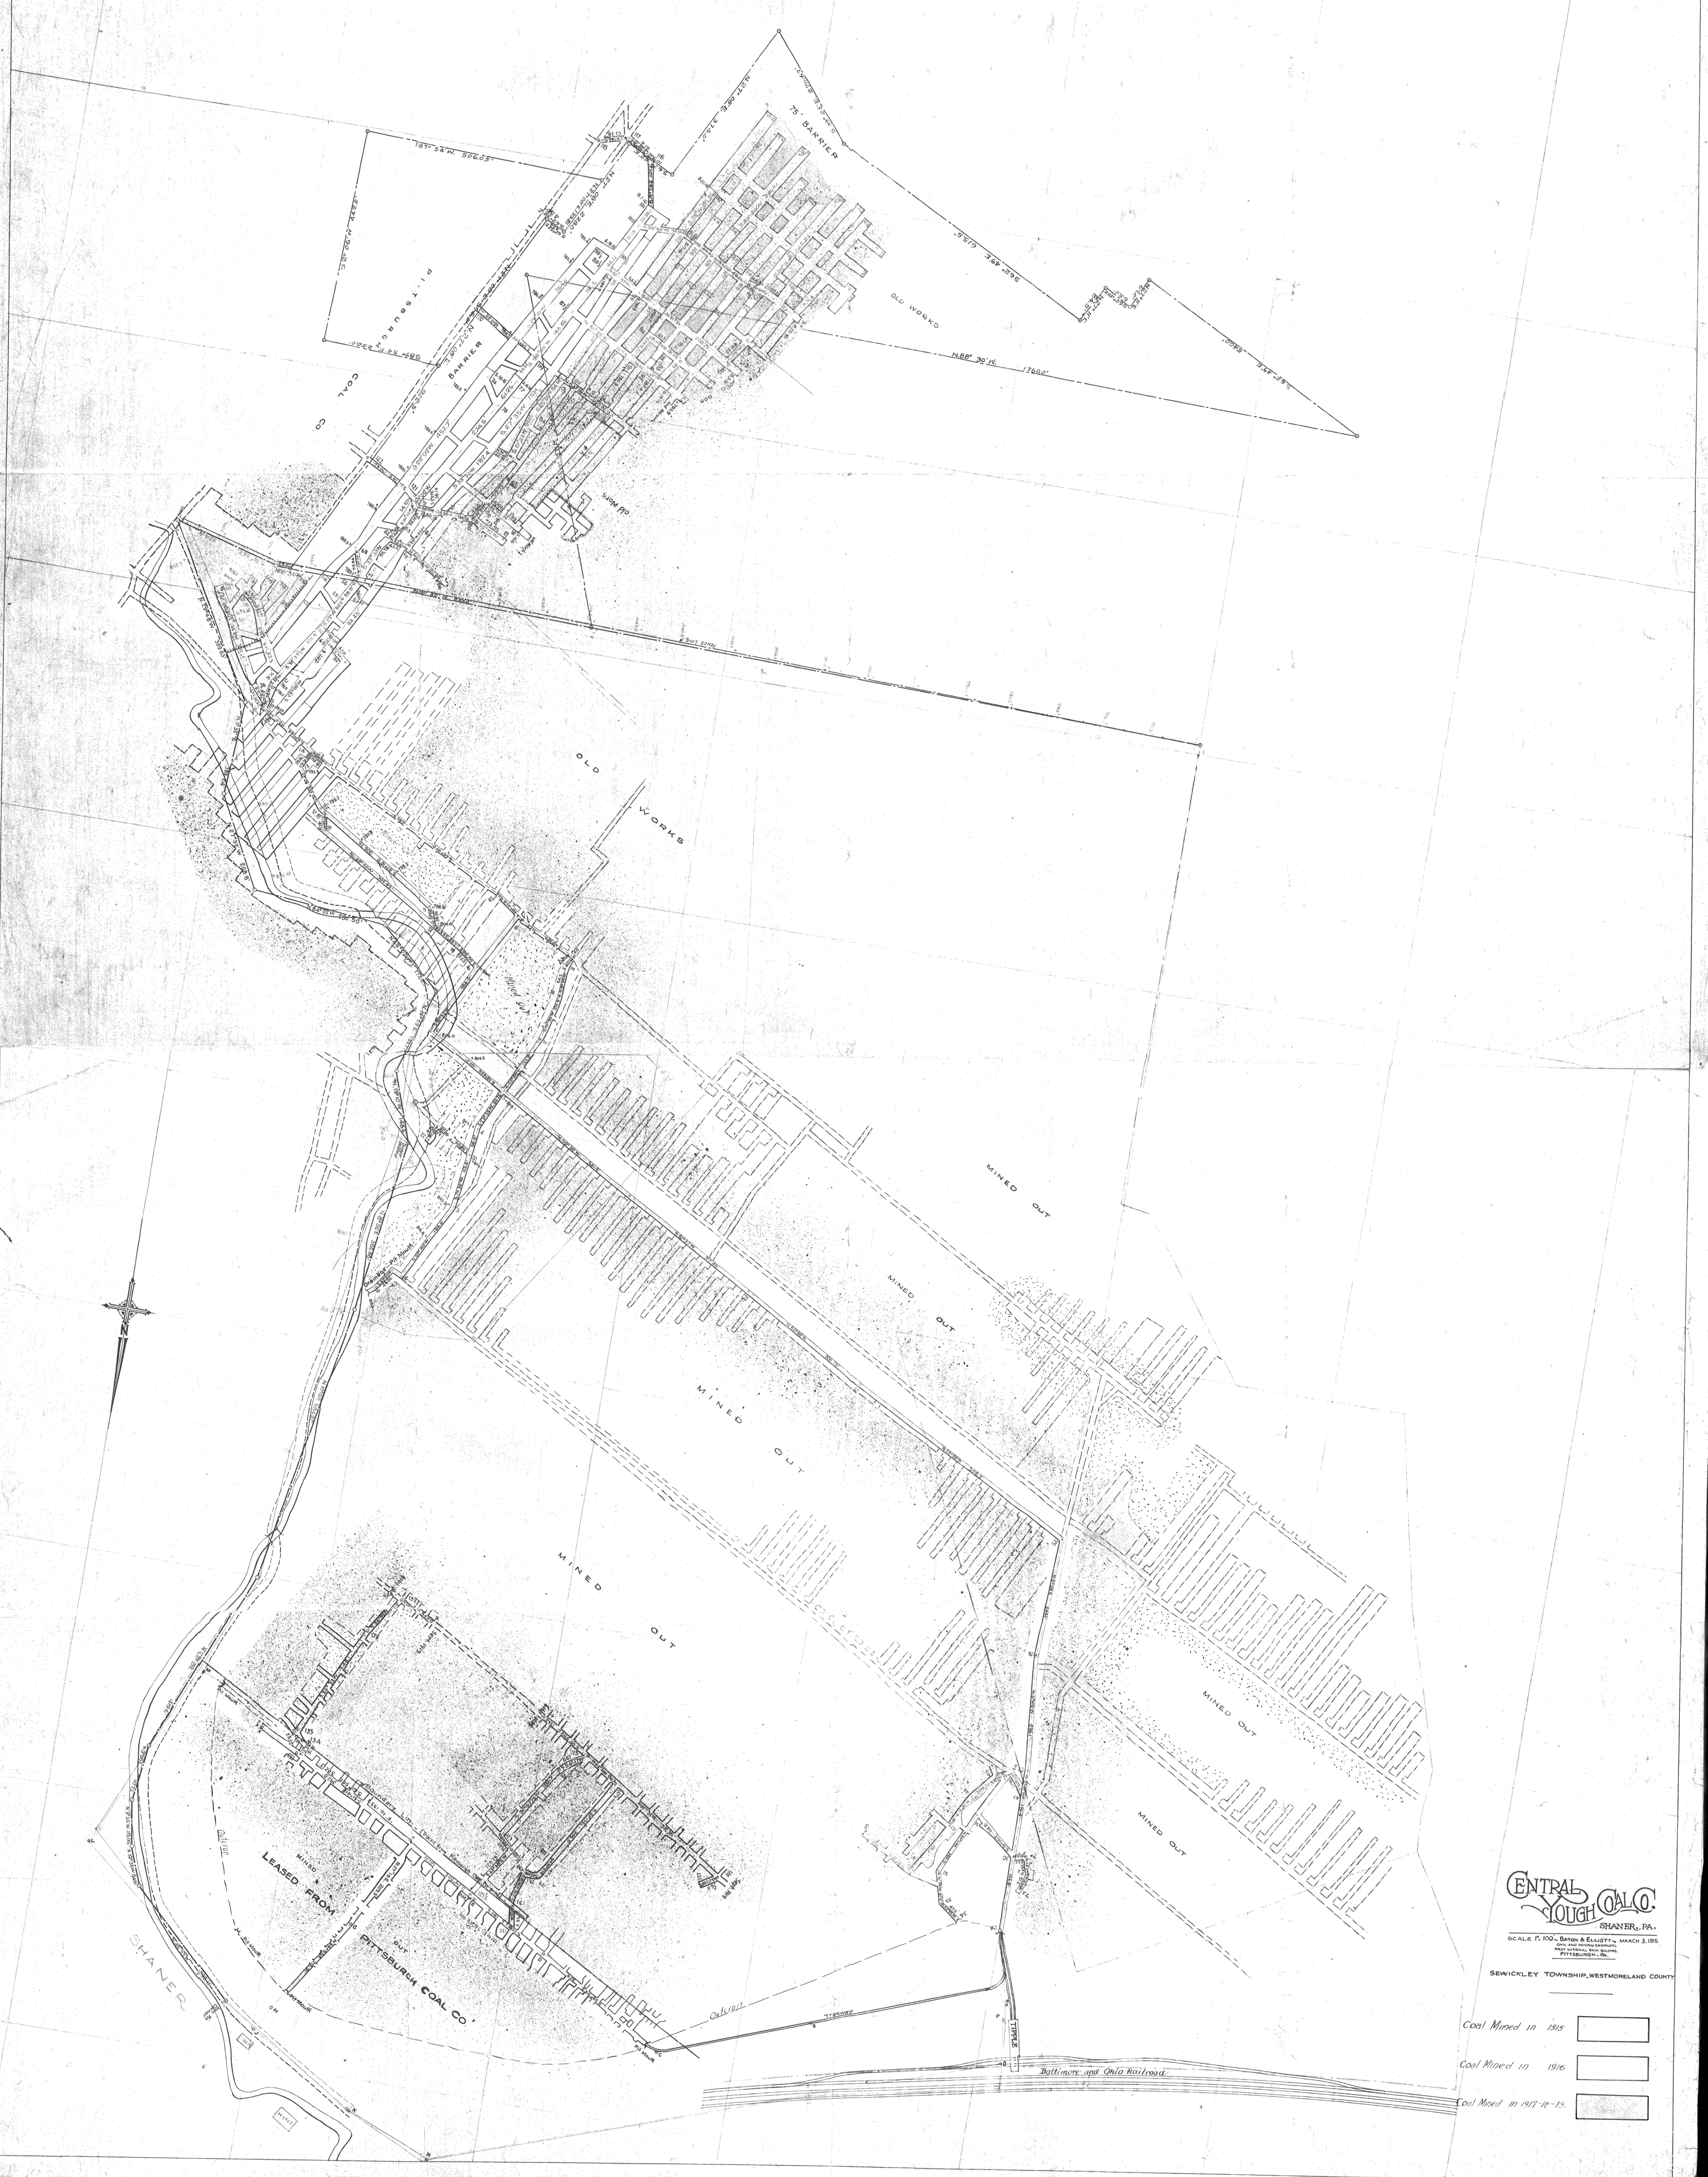

CENTRAL YOUGH COAL CO.

SHANER, PA.

SCALE 1" = 100' ~ BATON & ELLIOTT ~ MARCH 3, 1915
CIVIL AND MINING ENGINEERS,
FIRST NATIONAL BANK BUILDING,
PITTSBURGH ~ PA.

SEWICKLEY TOWNSHIP_WESTMORELAND COUNTY

Coal Mined in 1915 ☐
Coal Mined in 1916 ☐
Coal Mined in 1917-18-19. ▨