


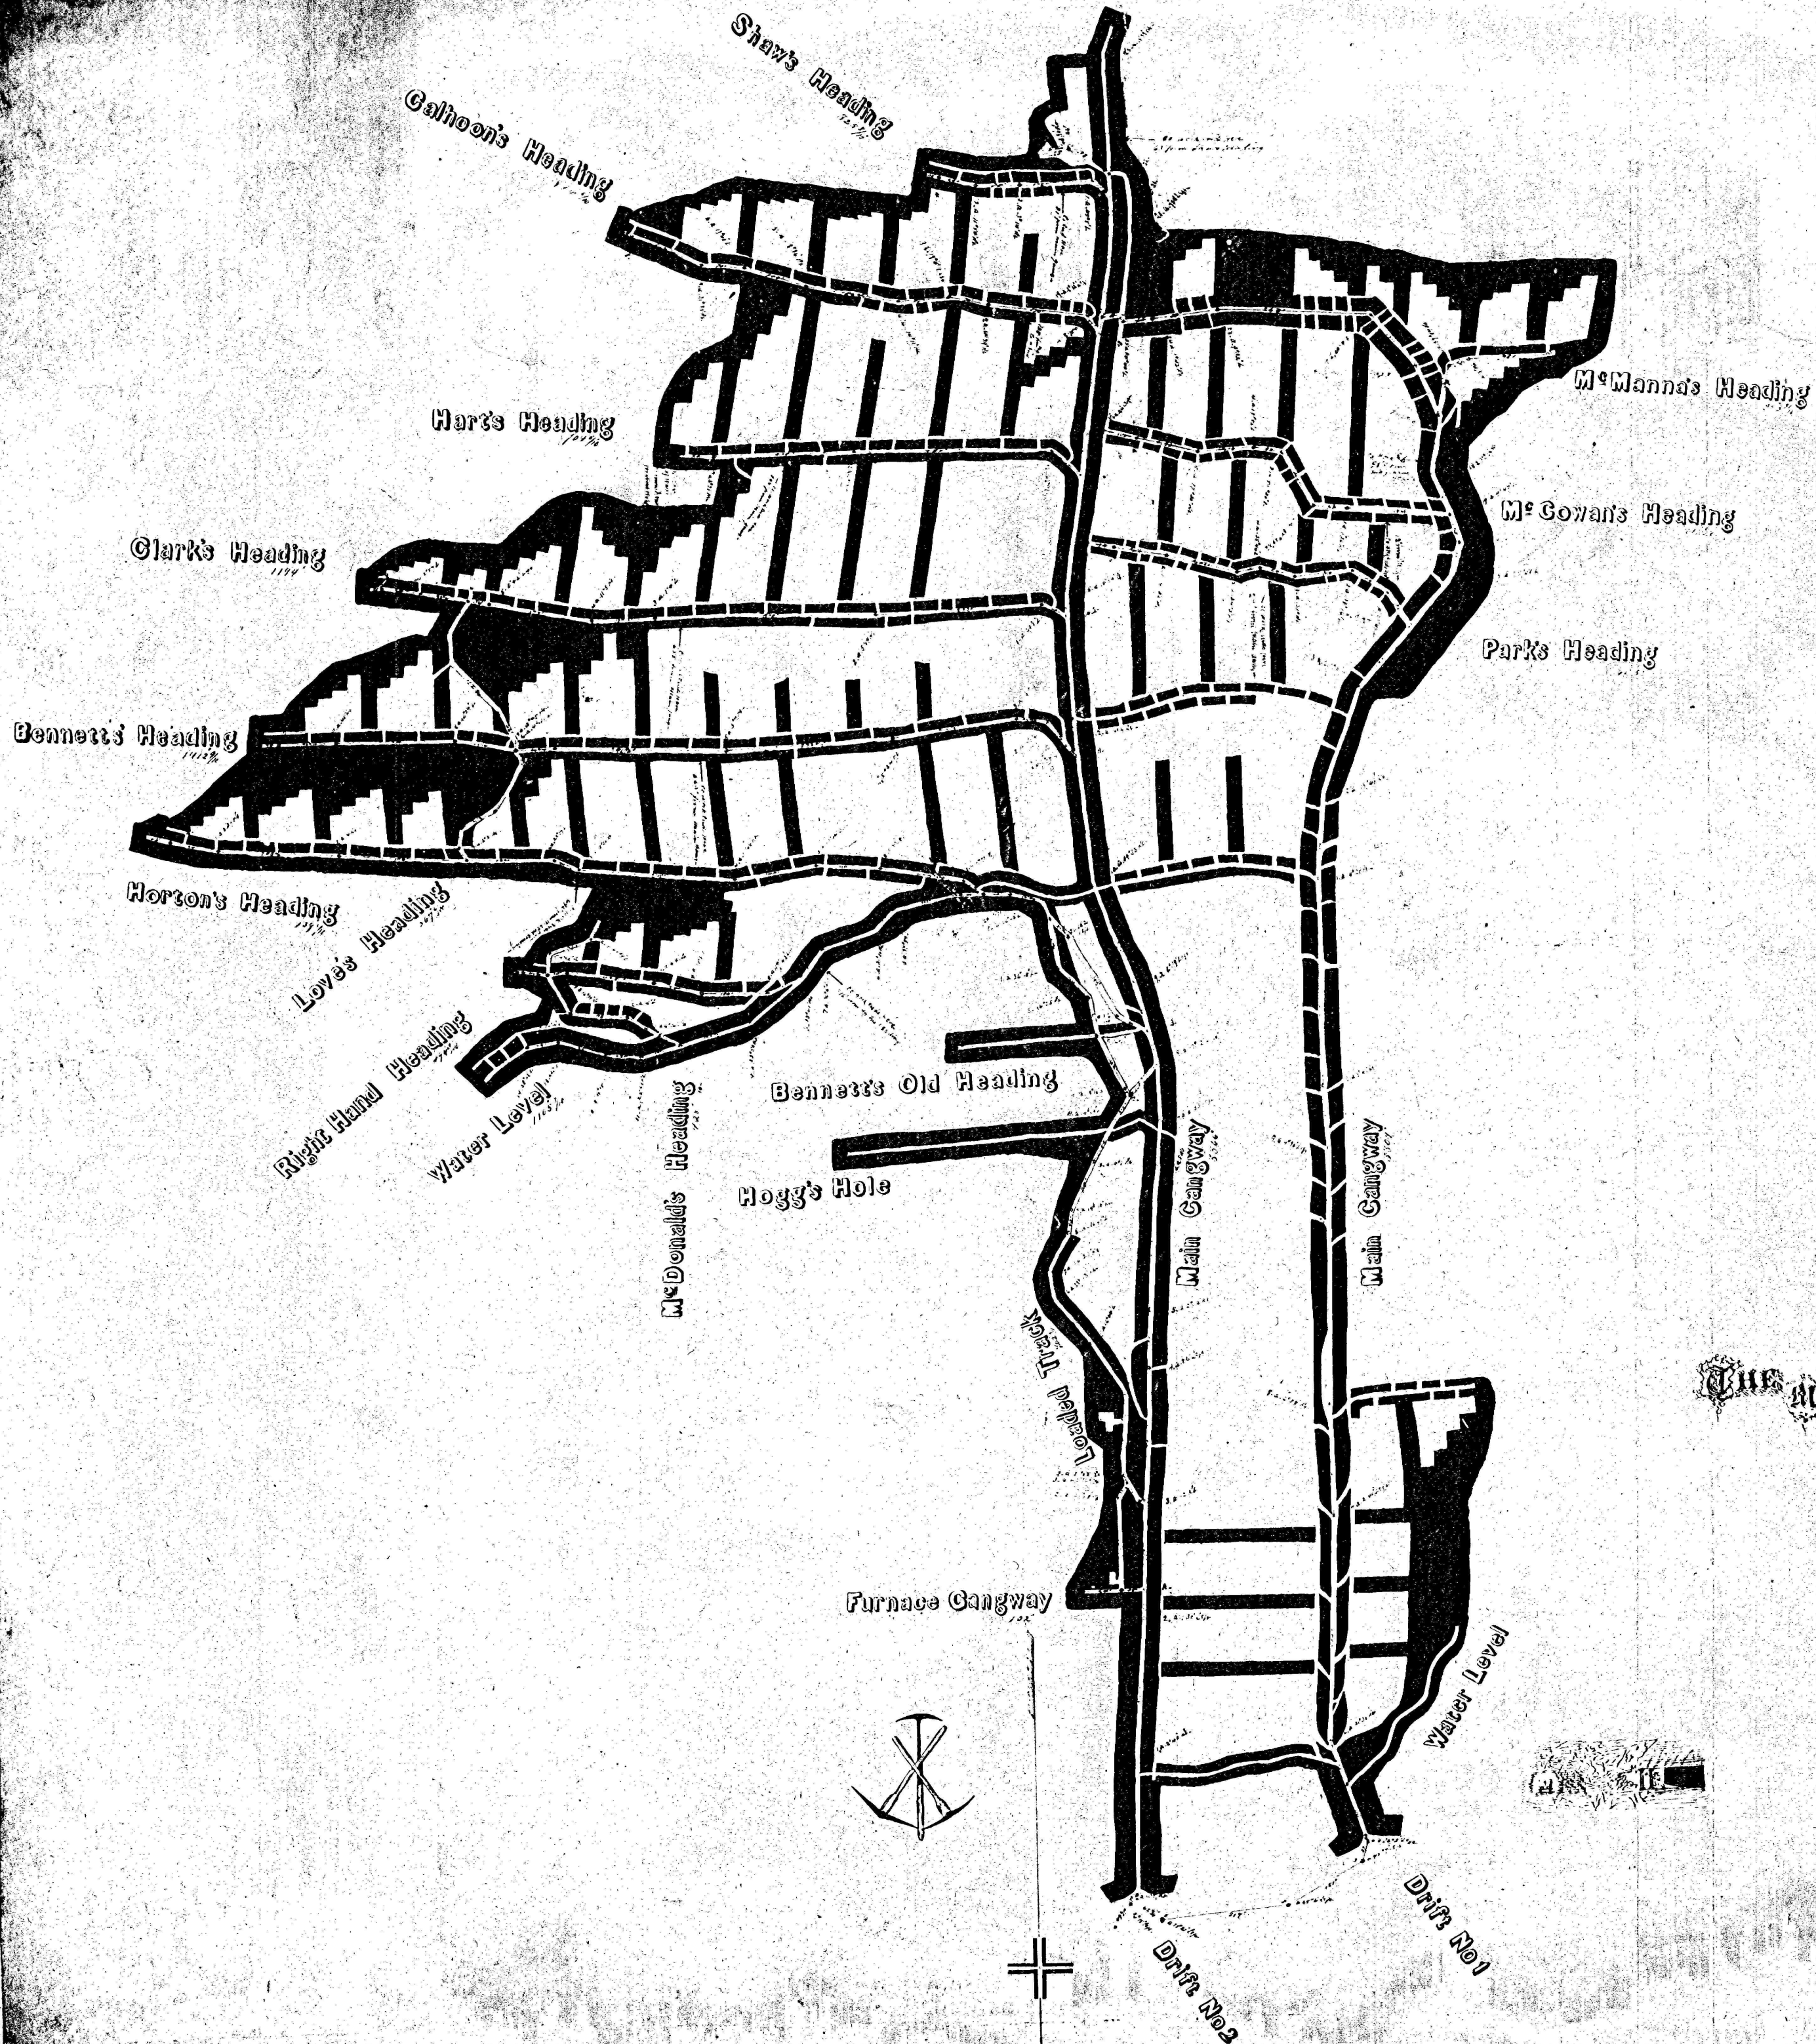

M A
 THE Mc JEFFREY COAL COMPANY
 MINES
 at
 Mc Intyre
 Jan. 1873
 Scale 100 ft to 1 in.

REDUCED SCALE

0 100 200 300 400 500