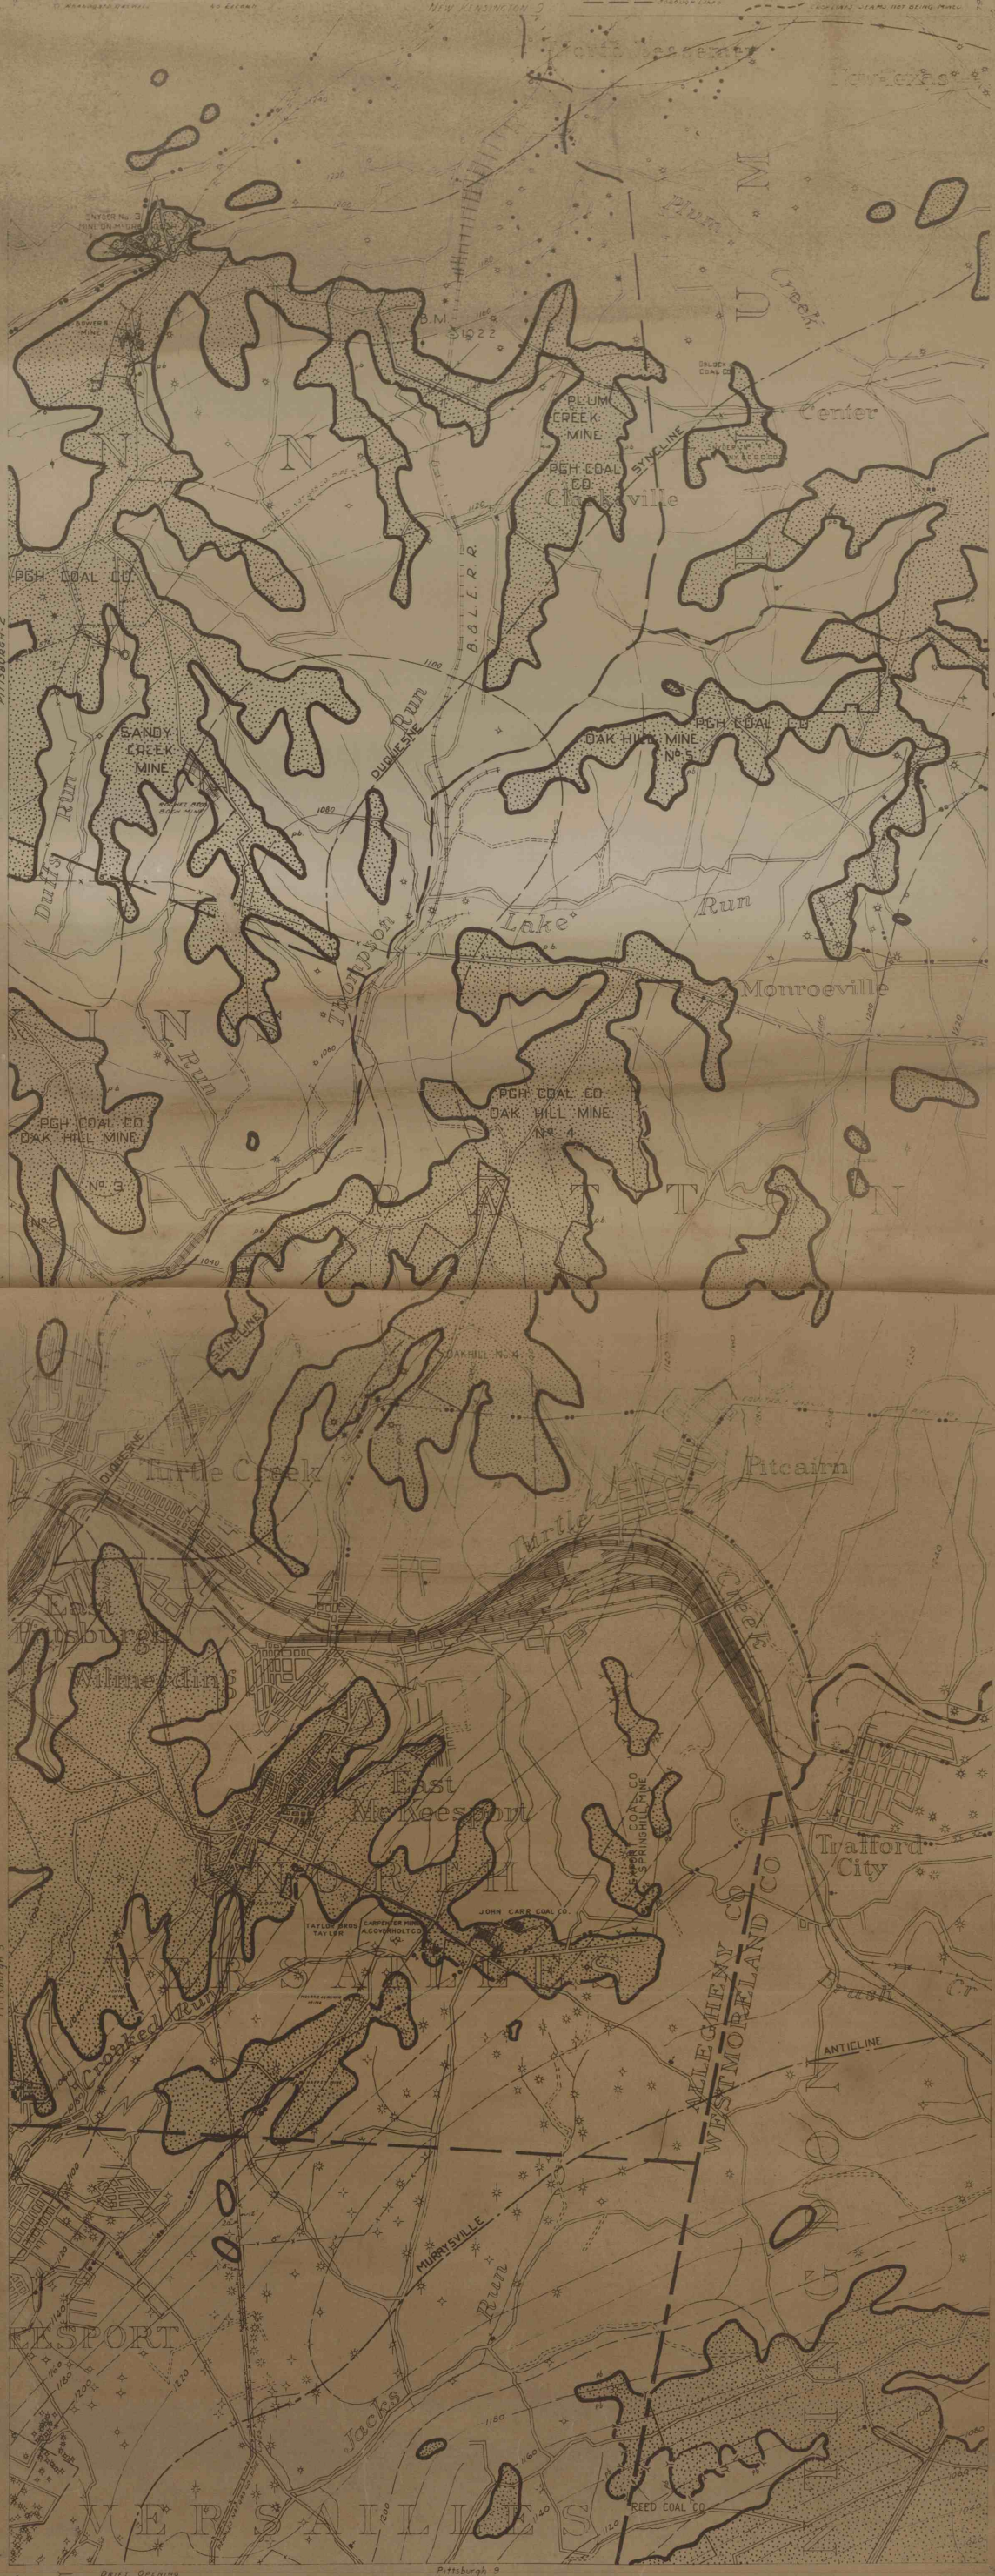

New Kensington 3
Plum Creek
Center
PLUM CREEK MINE
PGH COAL CO
Clarkeville
SYNCLINE
B.&L.E.R.R.
PGH COAL CO
Pittsburgh 2
Greensburg 1
SANDY CREEK MINE
Duffs Run
Thompson Run
DUQUESNE
OAK HILL MINE No 5
PGH COAL CO
Lake Run
Monroeville
PGH COAL CO OAK HILL MINE No 4
PGH COAL CO OAK HILL MINE No 3
No 2
Turtle Creek
Pitcairn
Turtle Creek
East Pittsburgh
Wilmerding
East McKeesport
Trafford City
Greensburg 4
Pittsburgh 5
Crooked Run
ALLEGHENY CO
WESTMORELAND CO
ANTICLINE
MURRYSVILLE
Jacks Run
REED COAL CO
Pittsburgh 9
Pittsburgh 8
DRIFT OPENING
SLOPE OPENING
SHAFTS
BARRIER PILLAR
2 MILES
W.P.A PROJECT NO 4483
PITTSBURGH SHEET No 6
Pittsburgh seam - pb