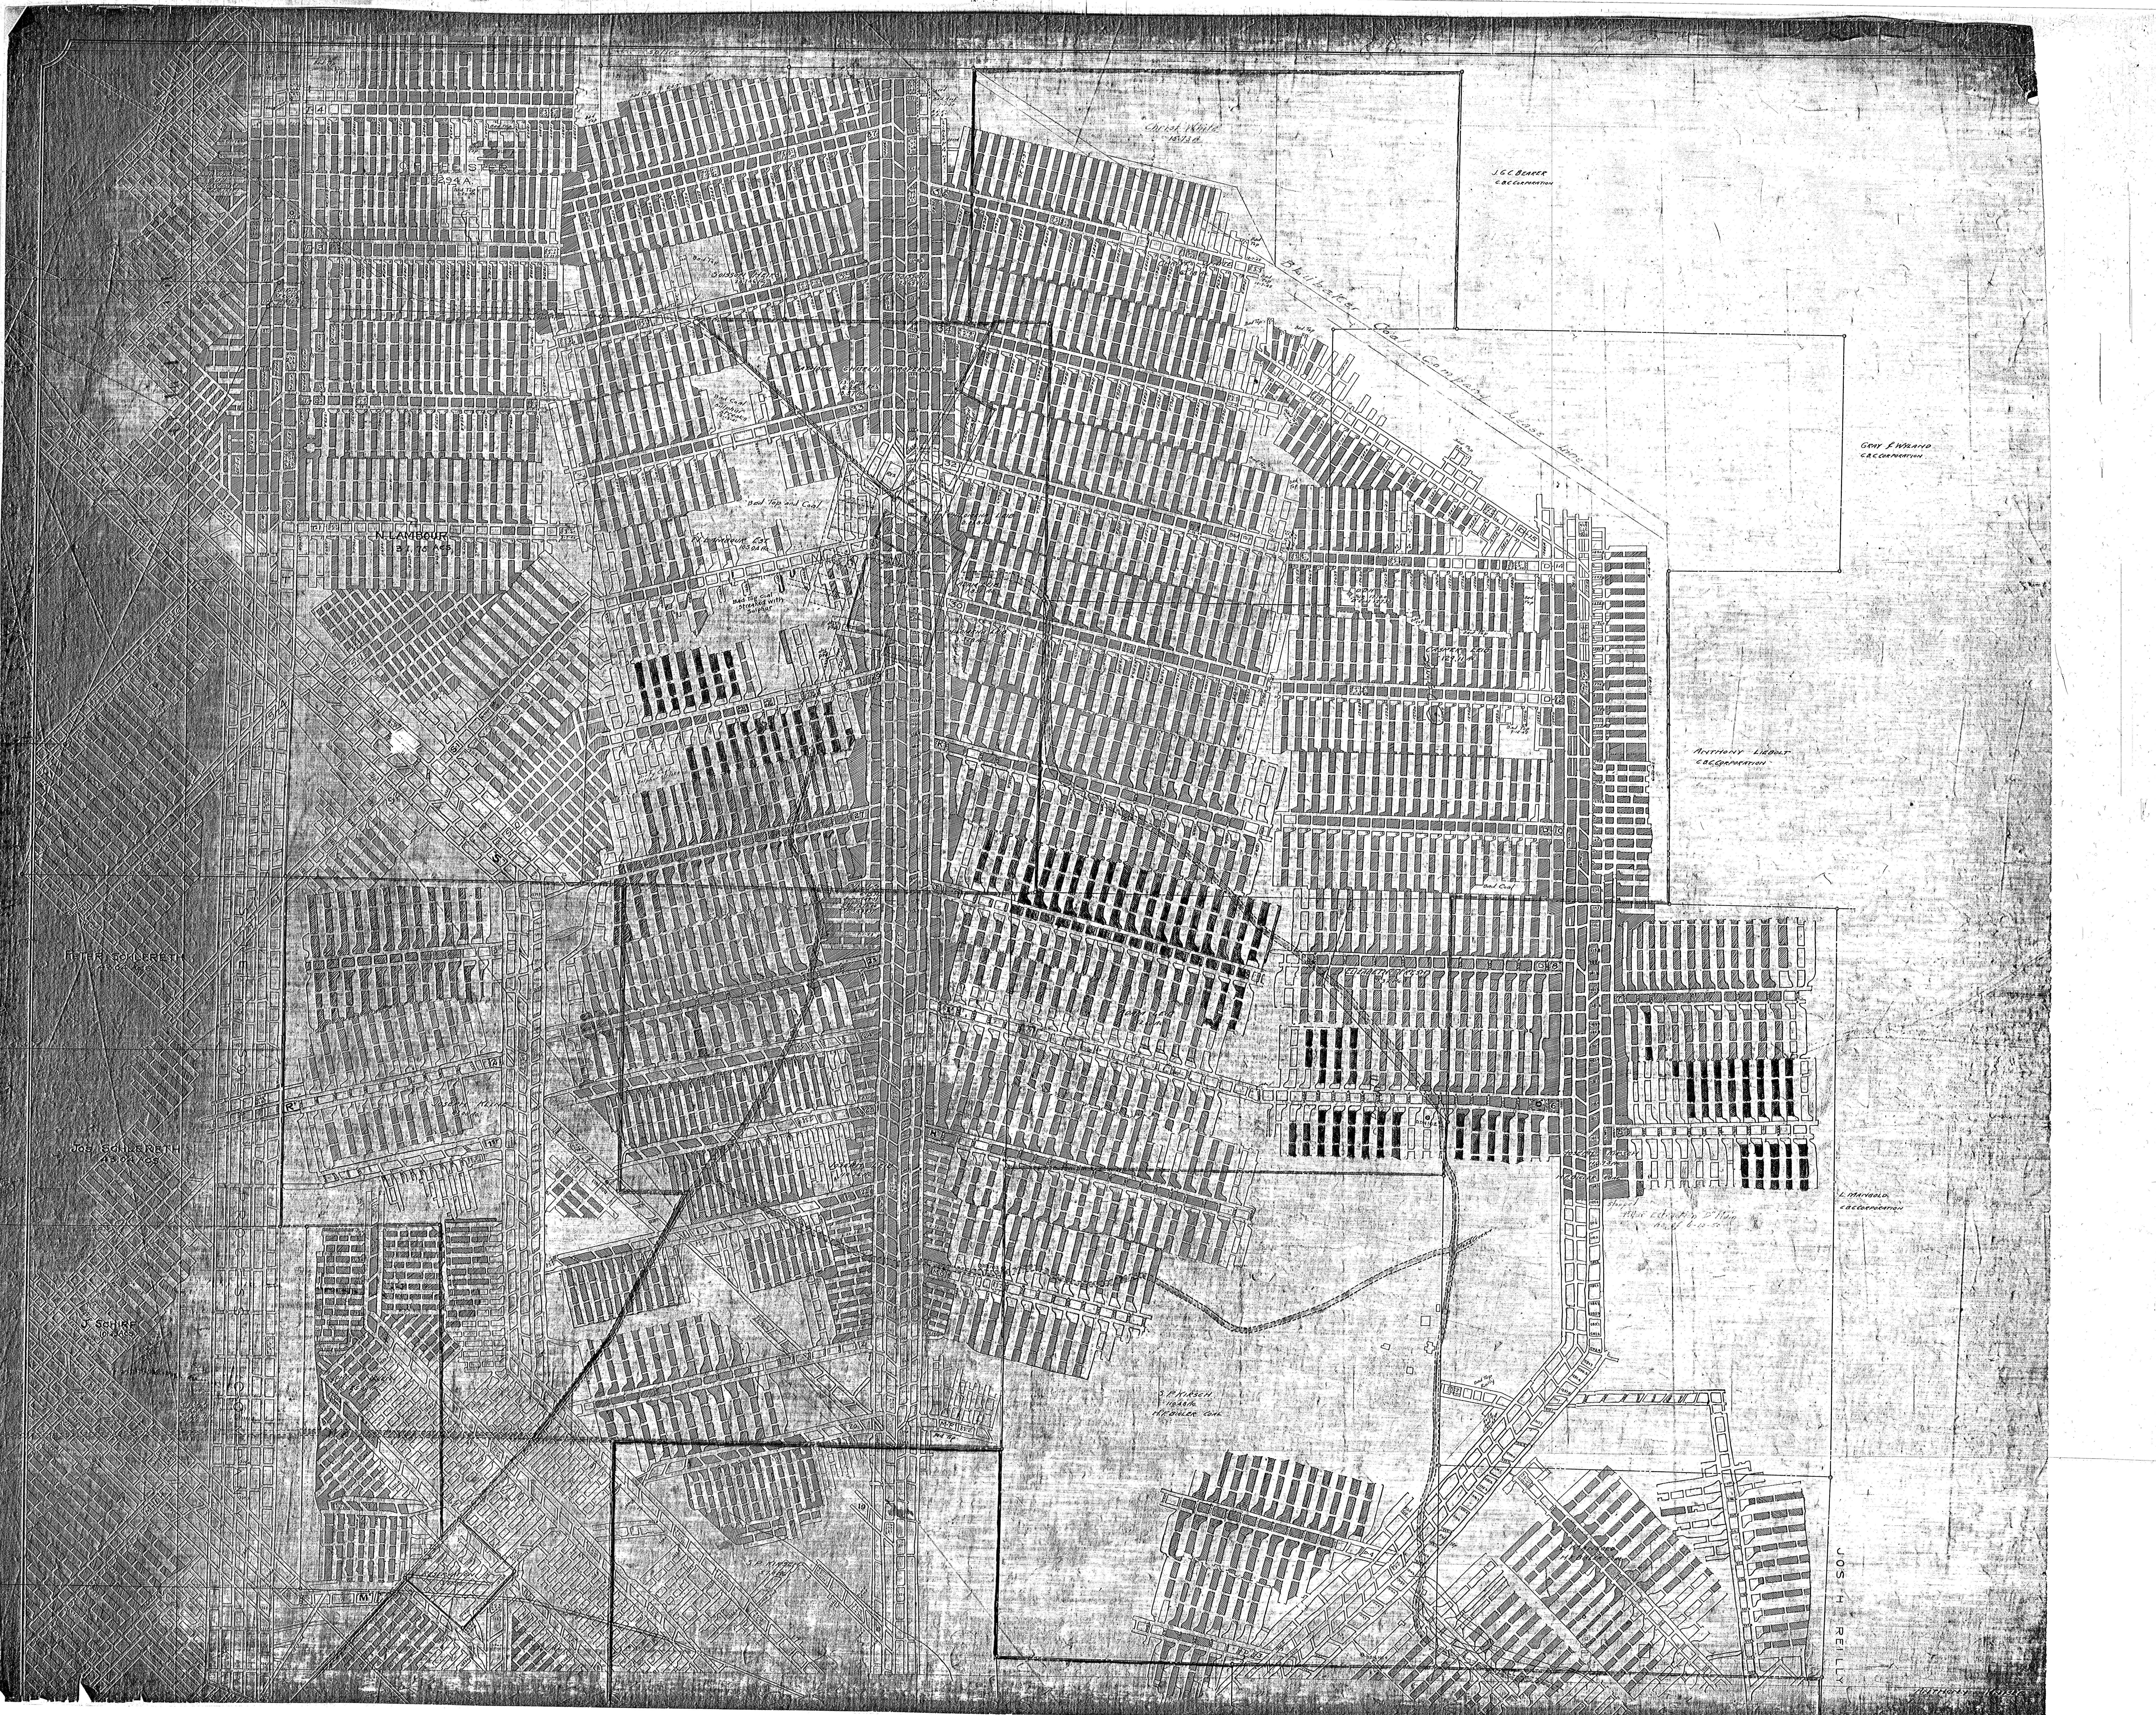

splice line
C. PFEISTER
92.94 A.
N. LAMBOUR
131.75 ACS.
Soisson Heirs
24.745 Ac.
Catholic Church Property
Bad Coal Sulphur Streaks 12-13-41
Bad Top and Coal
N. Lambour Est
105.04 Ac.
Bad Top Coal Streaked with Sulphur
Dirty Coal Sulphur streaks
Christ White
15.73 A.
Christ White
67.18 A.
Bad Top
J. G. C. BEARER
C.B.C. CORPORATION
Brubaker Coal Company Lease Line
GRAY & WYLAND
C.B.C. CORPORATION
D-15
D-14
Casper Leis
129.11 Ac.
ANTHONY LIEBOLT
C.B.C. CORPORATION
L. MANGOLD
C.B.C. CORPORATION
Stopped Pillar Extraction "D" Main as of 6-13-50
Joseph Kirsch
PETER SCHLERETH
43.04 ACS.
JOS. SCHLERETH
43.04 ACS.
J. SCHIRF
10.23 ACS.
Joseph Kline
R
S
T
M
S. P. Kirsch
110.48 Ac.
H. F. BIGLER COAL
Bad Top Relly
D-4
D-3
JOS H REILLY