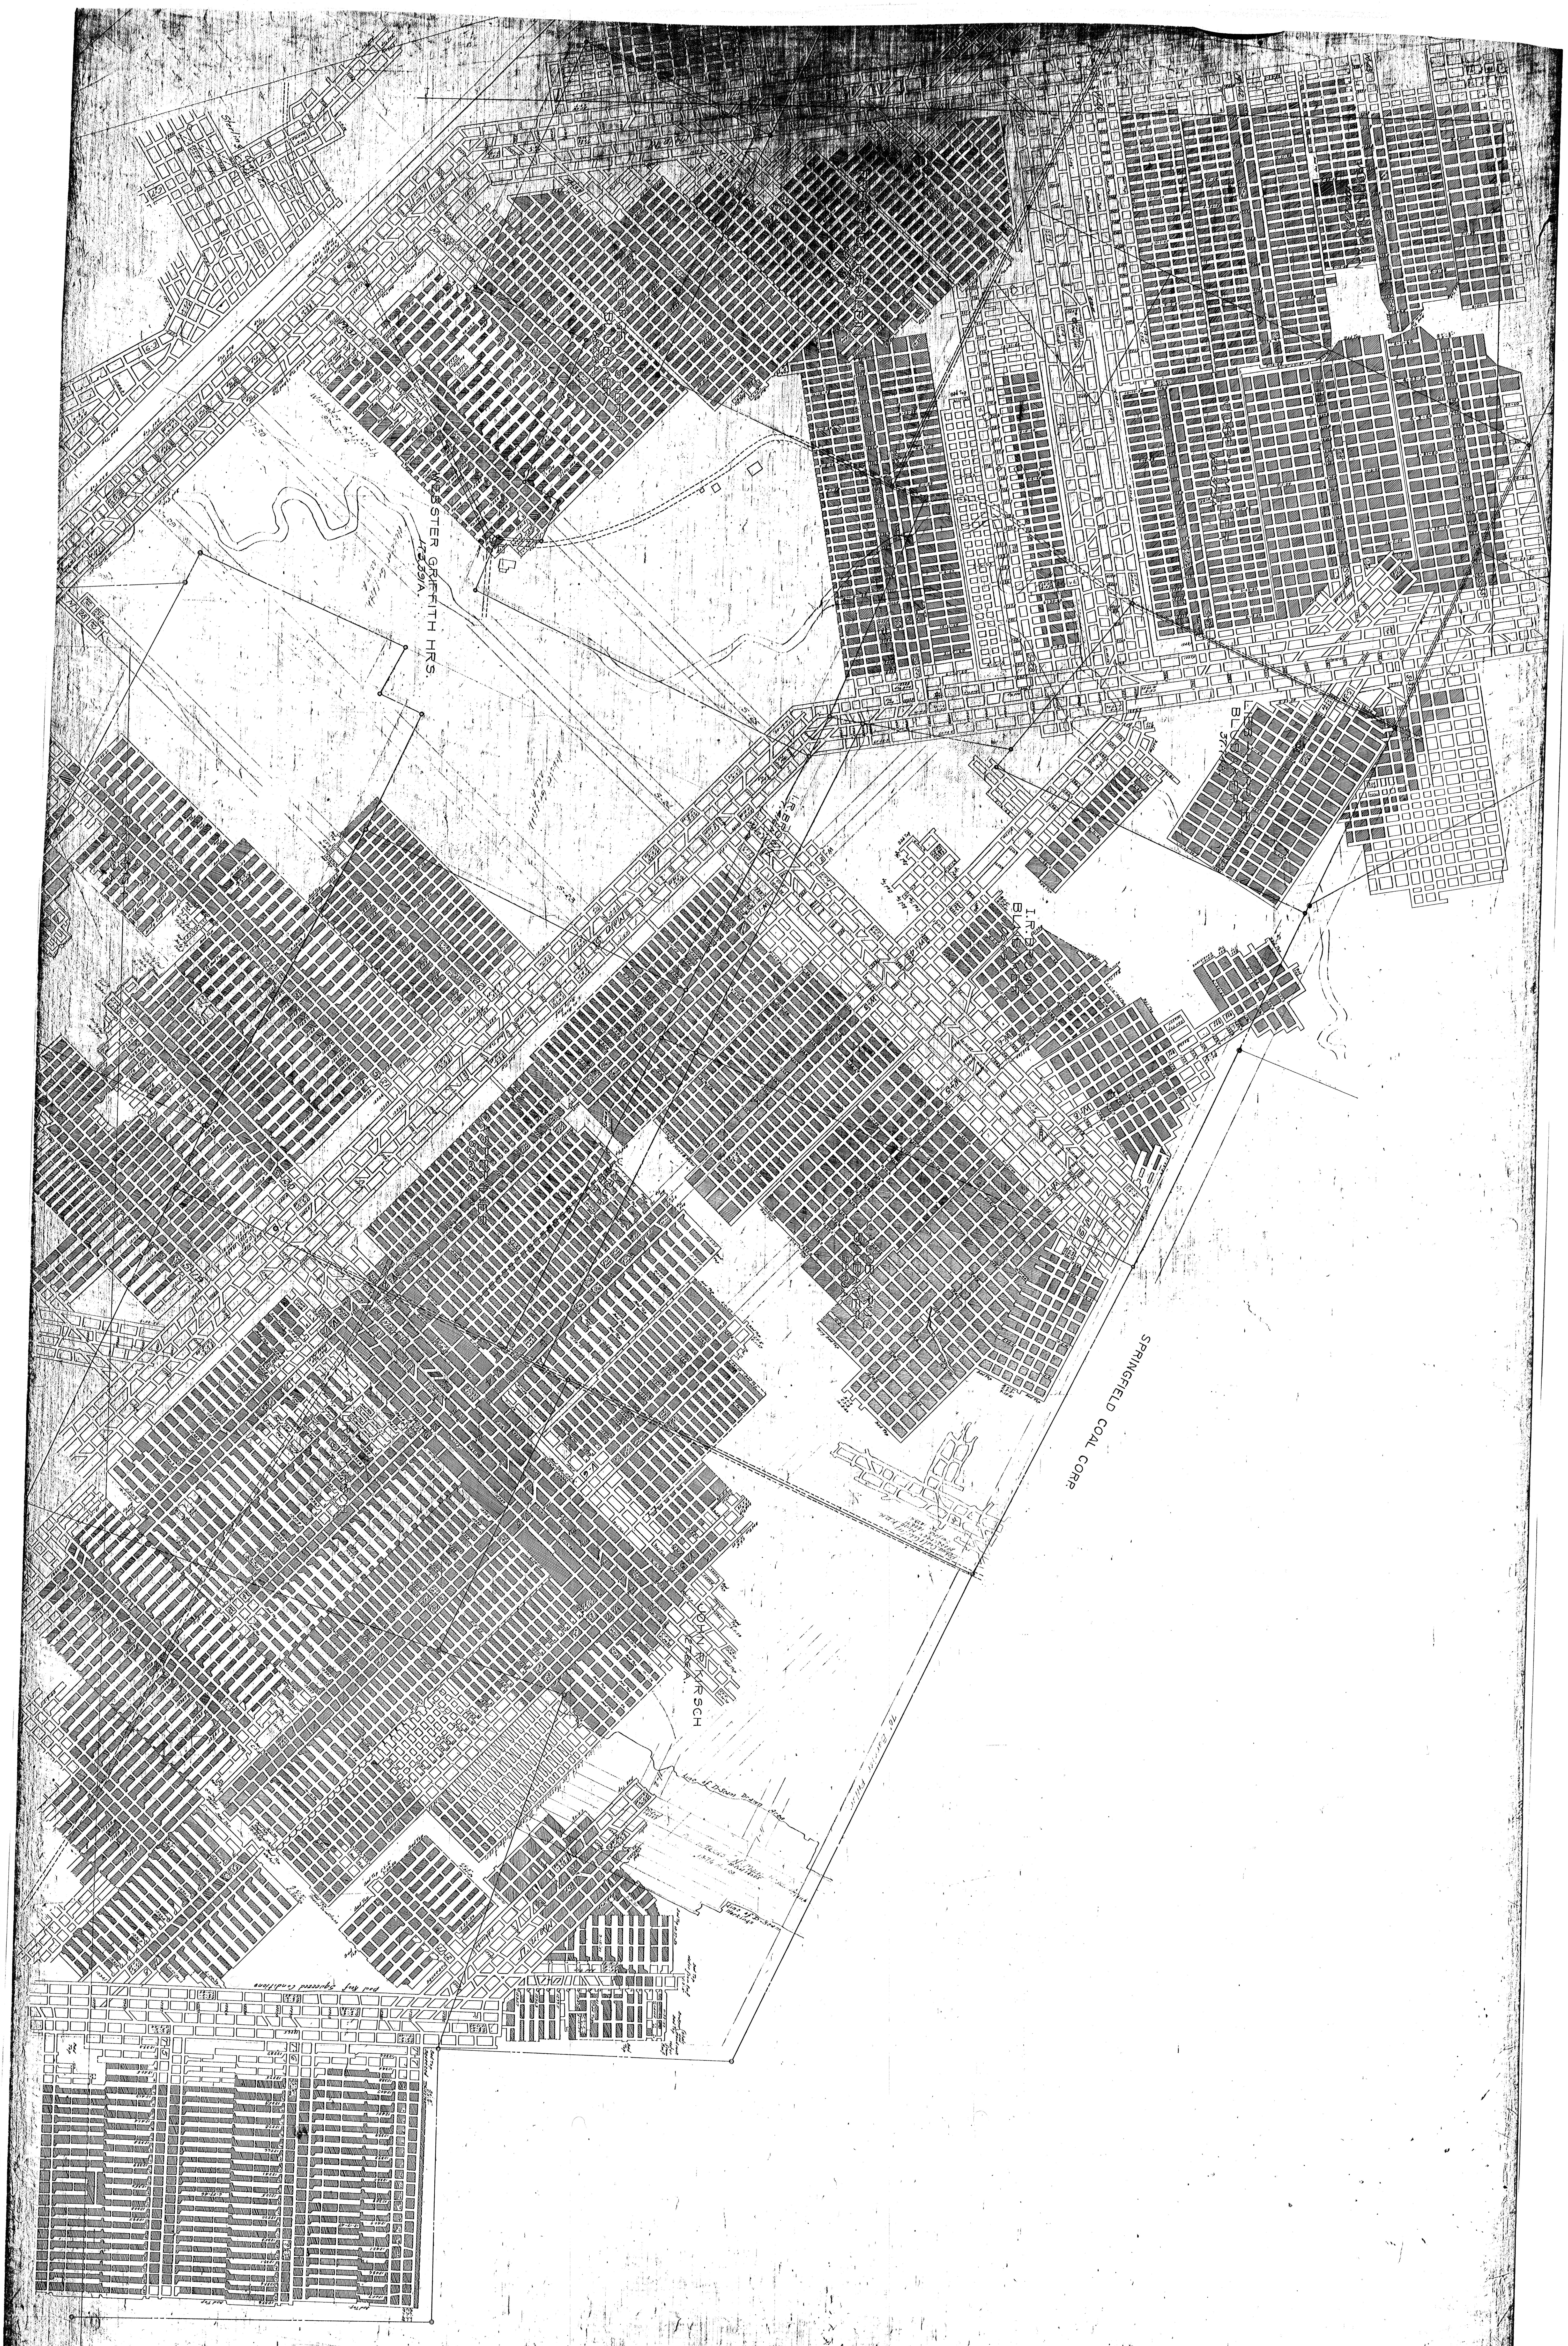
WEBSTER GRIFFITH HRS.
173.39 A.
JOHN R. KIRSCH
127.26 A.
SPRINGFIELD COAL CORP
I.R. BROWN
BL
Line of D-Seam Drawn Area